



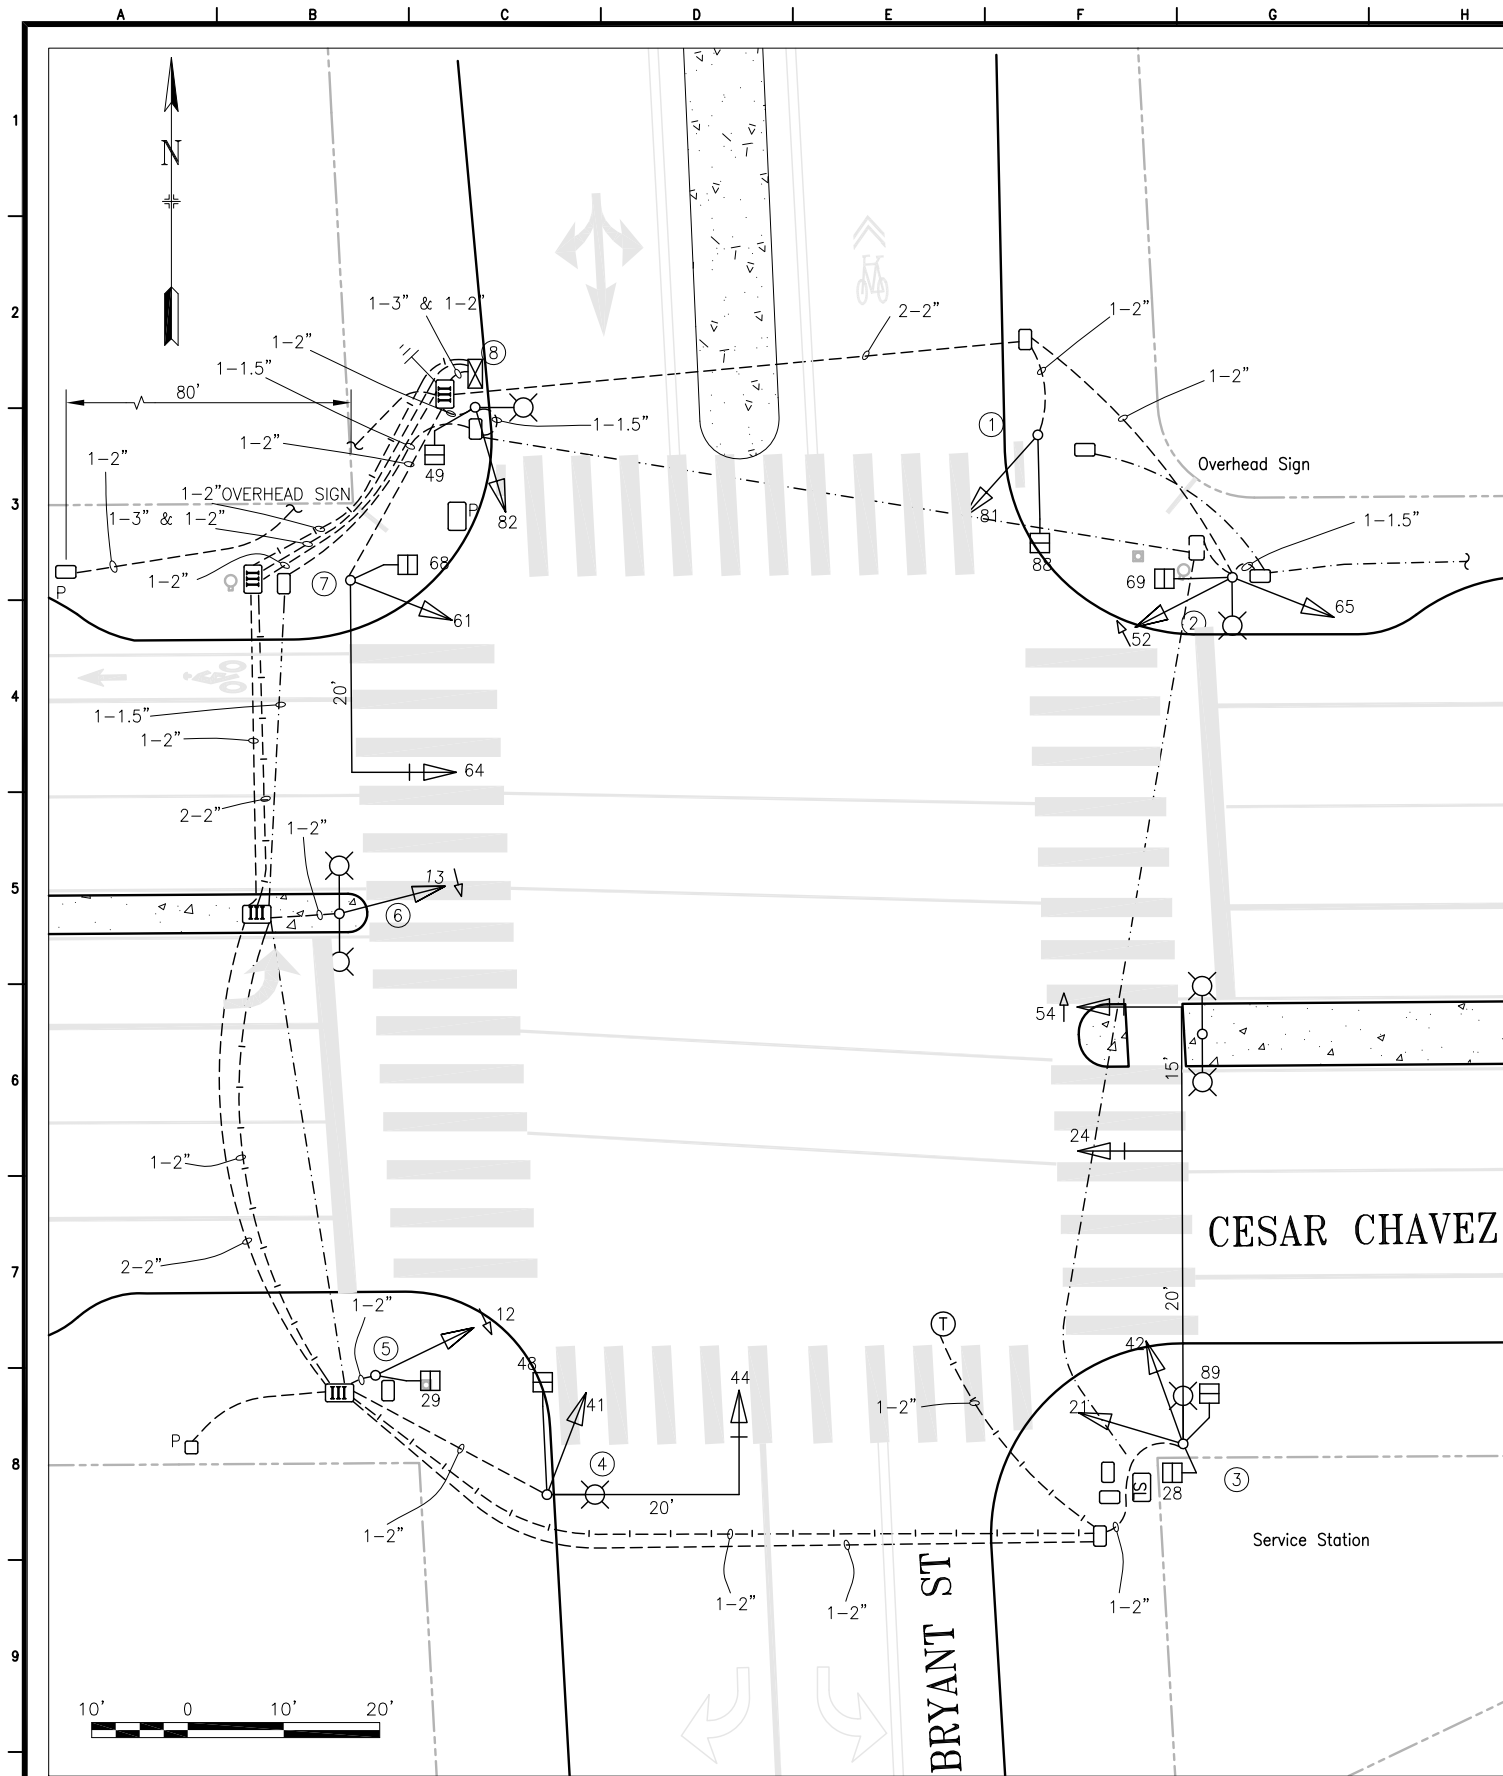

POLE AND EQUIPMENT SCHEDULE										
POLE No.	TYPE OF POLE	LUMINAIRE (HPS) VOLTAGE/ WATTS	VEHICLE SIGNAL					PEDESTRIAN SIGNAL		
			No.	TYPE	MOUNTING	VISORS	LOUVERS	No.	TYPE	MOUNTING
①	1-A (10')		81	3S12"	TV-1-T	T		88	1S-COUNT	SP-1
②	CITY STANDARD STREET LIGHT	120V 150W	52 65	4S12"GLA 3S12"	SV-2-TA w/ Extender and Coupler	T T		69	1S-COUNT	SP-1
③	27-4-100 with 45' MASTARM		54 24 21 42	4S12"GLA 3S12" 3S12" 3S12"	MAS MAS SV-2-TA	T T T		28 89	1S-COUNT 1S-COUNT	SP-1 SP-1
④	17B-1-70 with 6' LUMINAIRE ARM AND 20' MASTARM		44 41	3S12" 3S12"	MAS SV-1-T	T T		48	1S-COUNT	SP-1
⑤	1-A (10')		12	3S12"LA	TV-1-T	T		29	1S-COUNT	SP-1
⑥	ORNAMENTAL STREET LIGHT		13	3S12"LA	SV-1-T	T				
⑦	16-1-70 with 20' MASTARM		64 61	3S12" 3S12"	MAS SV-1-T	T T		68	1S-COUNT	SP-1
⑧	CITY STANDARD STREET LIGHT	120V 100W	82	3S12"	SV-1-T	T		49	1S-COUNT	SP-1
										REMARKS
										BACKPLATE BACKPLATE
										BACKPLATE
										BACKPLATE

PHASE DIAGRAM

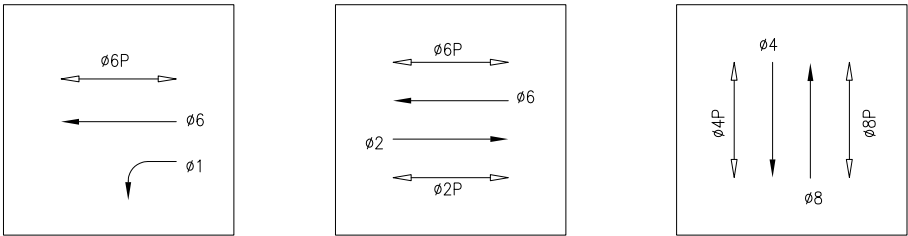

PHASE SEQUENCE

R	G	Y	R	CESAR CHAVEZ STREET (EB) - ø2
G	Y	R	R	CESAR CHAVEZ STREET (WB) - ø6
Y	R	G	Y	CESAR CHAVEZ STREET (WBLT) - ø1
R	G	Y	R	BRYANT STREET (SB & NB) - ø6 & ø2
RH	WM	FRH	RH	PED XING BRYANT STREET (SS) - ø2P
WM	FRH	RH	RH	PED XING BRYANT STREET (NS) - ø6P
RH	WM	FRH	RH	PED XING CESAR CHAVEZ STREET (ES & WS) - ø4P & ø8P

NO.	DATE	DESCRIPTION	BY	APP.
0	4/14	SIGNAL UPGRADE ACTIVATED THRU 1068J; CONVERTED FROM 1068J AND 0494J CPs	JH	GD
TABLE OF REVISIONS CHECK WITH TRACING TO SEE IF YOU HAVE LATEST REVISION				

REFERENCE INFORMATION
& FILE NO. OF SURVEYS



SAN FRANCISCO MUNICIPAL TRANSPORTATION AGENCY
CITY AND COUNTY OF SAN FRANCISCO

DRAWN: DATE:
JH 8/14
CHECKED: DATE:
GD 8/14

SCALE:

AS SHOWN

SHEET OF SHEETS

1 OF 1

TRAFFIC SIGNAL INVENTORY DIAGRAM

CESAR CHAVEZ ST AND BRYANT ST

CNN NO.

21135000

REV NO.

0