


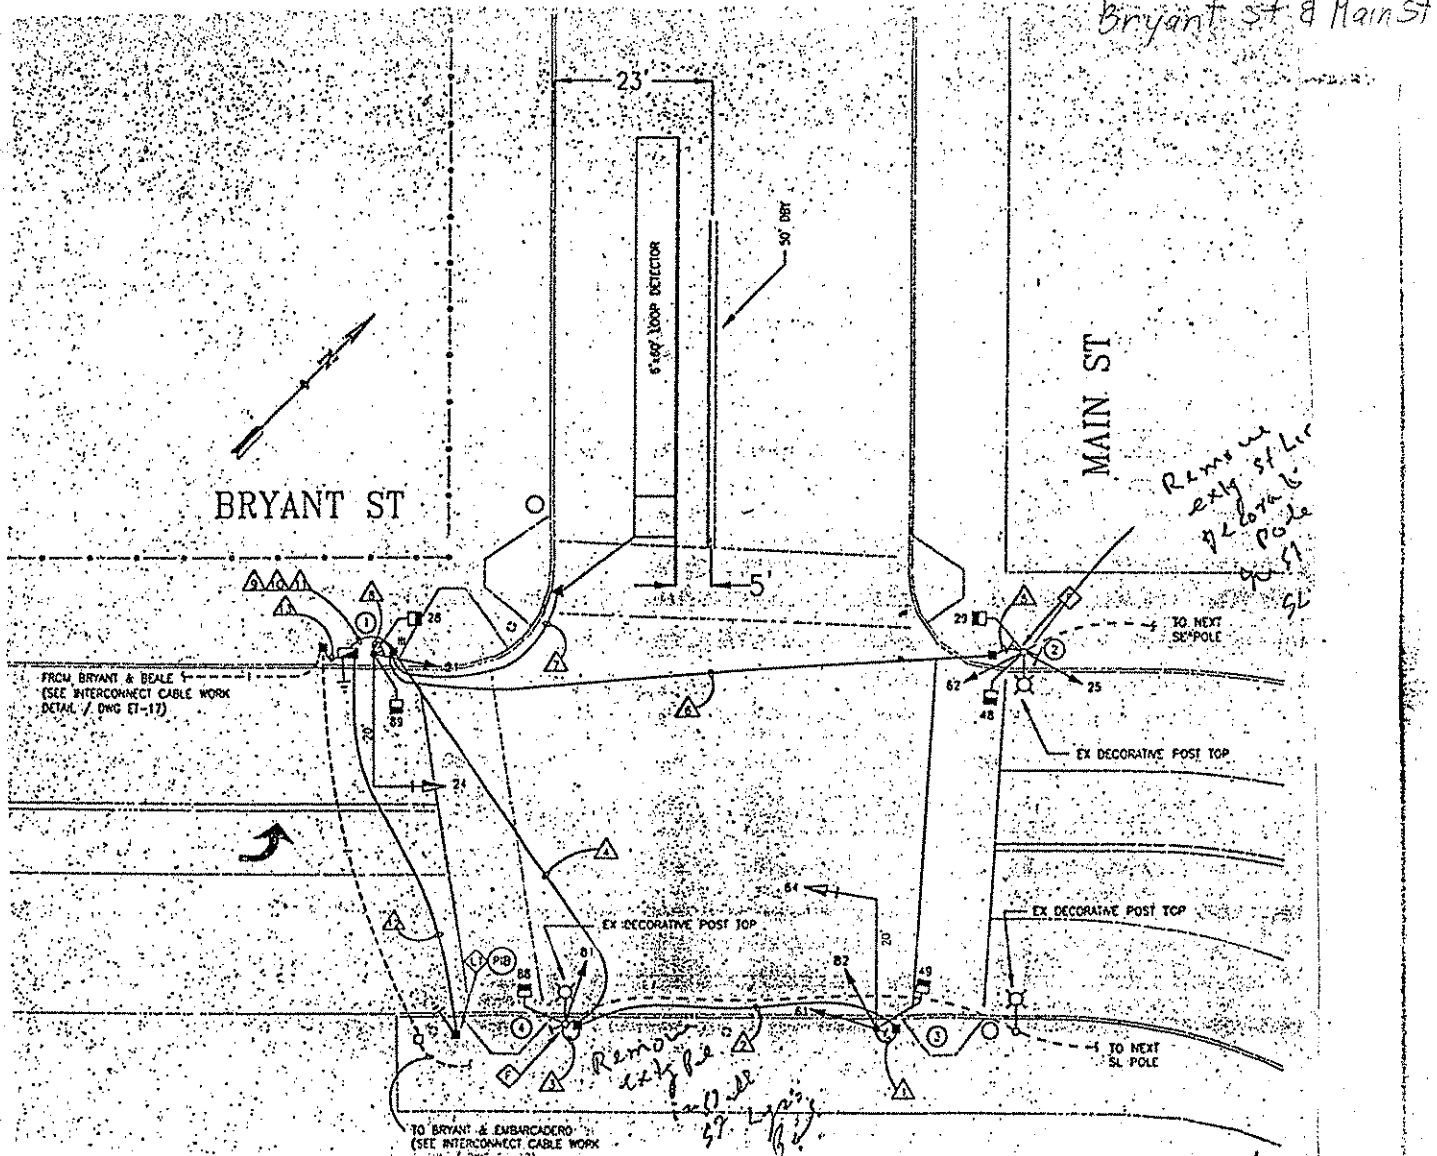

F	FUNC	MAT'L	SIGNAL NO.	MAKE	NO. OF SECT.	SIZE	VISOR	B.P. OR LOUVERS	MOUN'T	PED SIGNAL NO.	LEGEND	MESSAGE		MAKE	MOUN'T
												ELEMENT	COLOR		
1	S	9	21	TCT	35	8' RYG	T	-	SV-1	28	T	8-IN	W/OX	KC	SP-1
2	L	S	24	TCT	35	12' RYG	T	BP	MAS	89	T	15-IN	W/OX	KC	SP-1
3	S	S	25	TCT	35	8' RYG	T	-	SV-2	29	T	16-IN	W/OX	KC	SP-1
4	L	S	62	TCT	35	8' RYG	T	-	SV-2	48	T	16-IN	W/OX	KC	SP-1
			61	TCT	35	8' RYG	T	-	SV-2	49	T	13-IN	W/OX	KC	SP-1
			82	TCT	35	8' RYG	T	-	SV-2	88	T	13-IN	W/OX	KC	SP-1
			64	TCT	35	12' RYG	T	BP	MAS						
			81	TCT	35	8' RYG	T	-	SV-1						

CONTROLLER CABINET SIZE : M Cabinet BASE CABINET :

COMMENTS :