


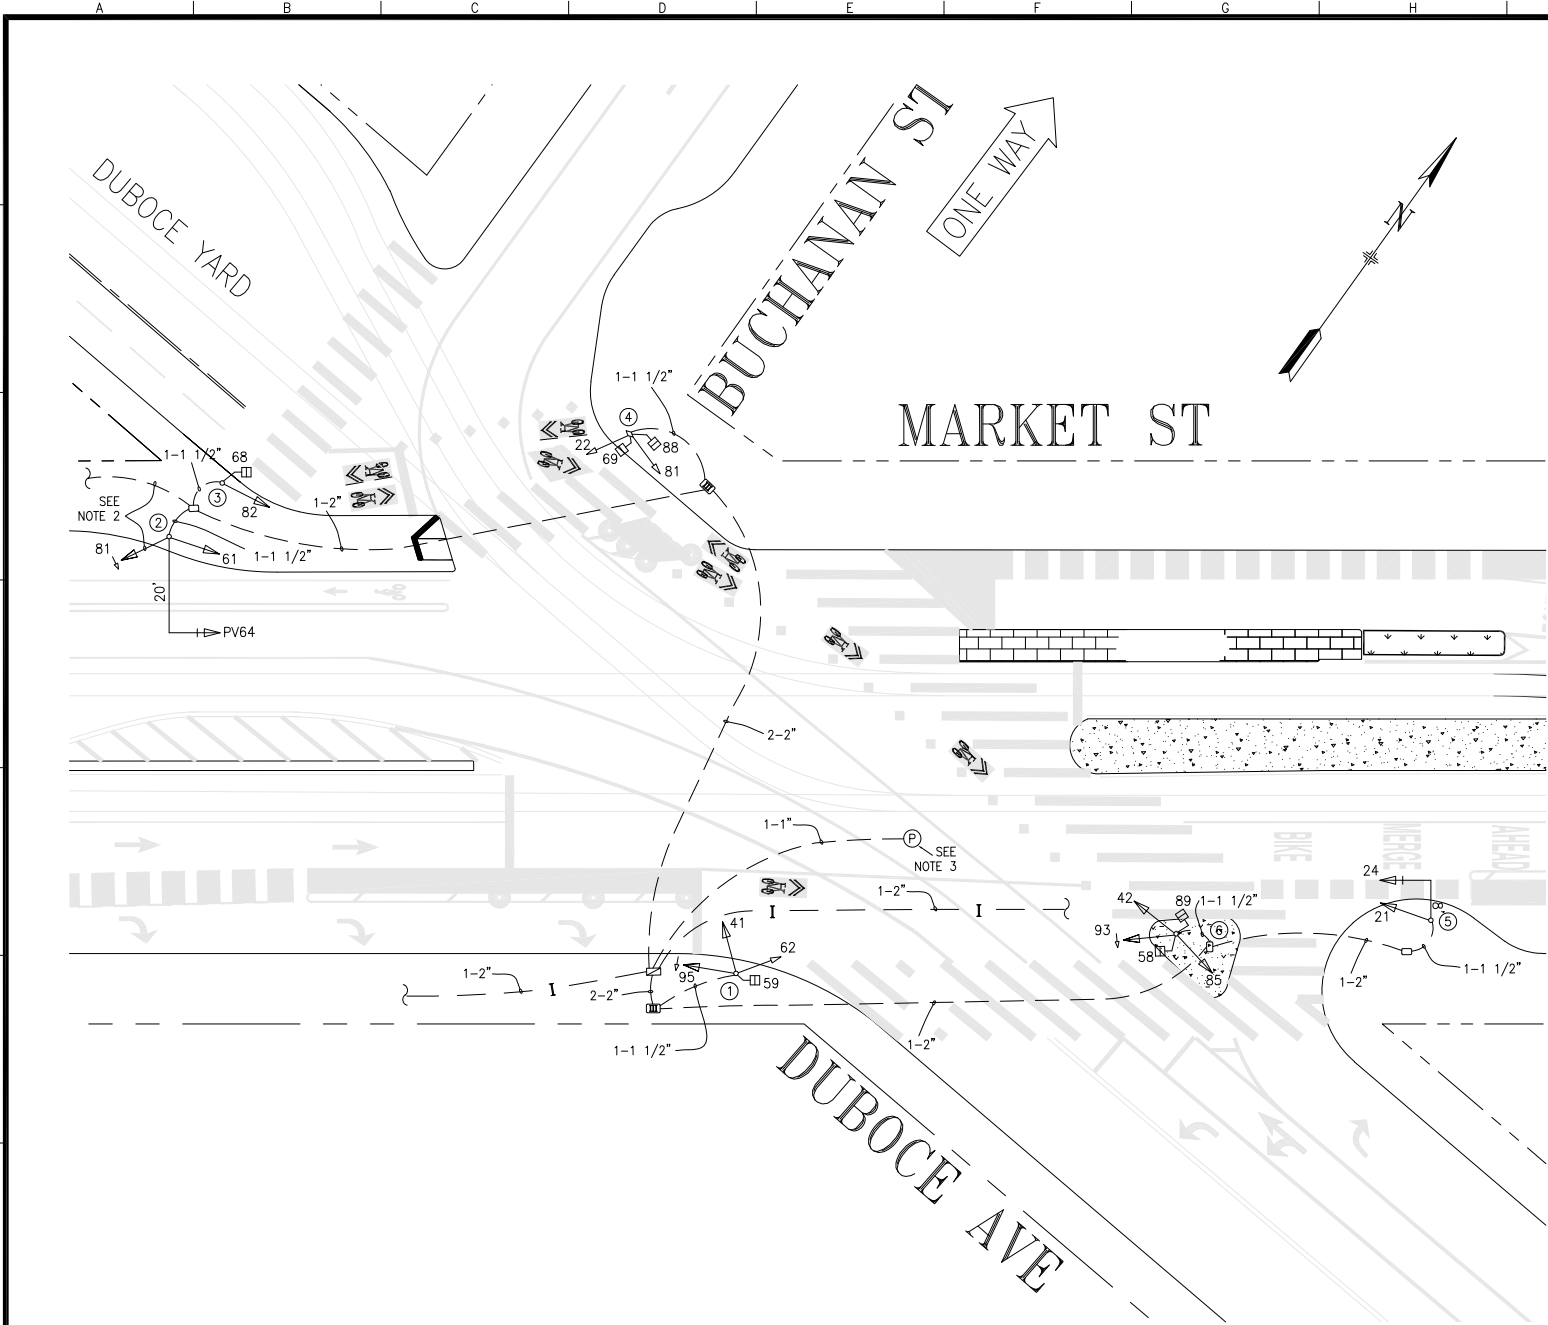

POLE AND EQUIPMENT SCHEDULE										
POLE No.	TYPE OF POLE	VEHICLE SIGNAL					PEDESTRIAN SIGNAL			REMARKS
		No.	TYPE	MOUNTING	VISORS	LOUVERS	No.	TYPE	MOUNTING	
①	PEDESTAL BASE	41 62 95	2S12" LB 3S8" 3S12" RA	TV-3-TA	T FC T		59	1S-COUNT	SP-1	
②	16-1-70 WITH 20' MAST ARM	PV64 61	3S12" 3S12"	MAS SV-2-TA	T FC	YES				SEE NOTE 2
③	PEDESTAL BASE	82	3S12"	TV-1-T	FC	YES	68	1S-COUNT	SP-1	
④	MUNI POLE (POLE #6192)	22 81	3S8" 3S8"	SV-2-TA	T T		69 88	1S-COUNT 1S-COUNT	SP-2	
⑤	16-1-70 WITH 8' MAST ARM	21 24	3S12" GVA 3S12" GVA	SV-1 MAS	T T					
⑥	1-A (10')	42 85 93	2S12" LB 3S12" 3S12" RA	TV-3-T	T T T		58 89	1S-COUNT 1S-COUNT	SV-1 SV-1	

NOTE:
1. CABINET FOUNDATION TYPE: M
2. SIGNAL HEAD 81 FOR DOLORES/MARKET SIGNAL IS MOUNTED ON POLE 2 AND SHOWN AS REFERENCE ONLY. SEE SIGNAL INVENTORY DIAGRAM FOR DOLORES/MARKET FOR FURTHER DETAILS ON CONDUIT CONNECTION TO POLE 2 FOR SIGNAL 81.
3. TO PG&E SERVICE POINT AT MANHOLE #5740

7	8/19/18	SRC 2018-230: UPGRADED SIGNALS 41 & 42 TO 2S12" BAR	TY	MV
		SIGNALS; RENUMBERED SIGNALS 27/63 TO 24/64		
6	3/7/17	SRC 2016-348: INSTALLED PV HEAD ON SIGNAL 63	ET	HQ
5	5/13/11	SRC 2010-279: RE-NUMBERED 2P TO 5P & 23/25 TO 93/95,	ET	HQ

		CHANGED 41 & 42 TO 3S8" (RX/BLANK/GX), REMOVED SIGNAL 26 AS PER FIELD CHECK, REMOVED GREEN CROSSBUCK ON POLE 4		
4	12/21/06	SRC 2006-189: NEW 4-SECTION 12-INCH HEAD FOR SIGNAL 81	RO	HQ
3	1/5/06	SRC 2005-263: REMOVE RED & YELLOW UP ARROWS FOR SIGNALS 21 & 27	RO	HQ
2	6/25/03	SRC 2003-048: INSTALLED PED COUNTDOWN SIGNALS	MG	JM
1	9/14/95	NEW EB RIGHT TURN ARROWS FOR SIGNALS 93 & 95	RJ	KLW
NO.	DATE	DESCRIPTION	BY	APP.

TABLE OF REVISIONS
CHECK WITH TRACING TO SEE IF YOU HAVE LATEST REVISION

REFERENCE INFORMATION & FILE NO. OF SURVEYS	
SPEC #23,989 (UPPER MARKET STREET SIDEWALK WIDENING & BEAUTIFICATION)-DRAWING E-15	
CONTRACT MR-894 - DRAWINGS CL-7489 & CL-7493	
CONTRACT MR-1101R - DRAWINGS CL-7926 & CL7927	



SAN FRANCISCO MUNICIPAL TRANSPORTATION AGENCY
CITY AND COUNTY OF SAN FRANCISCO

DRAWN:	DATE:
TY	02/2019
CHECKED:	DATE:
MV	03/2019

SCALE: 1" = 20'	TRAFFIC SIGNAL INVENTORY DIAGRAM	CNN NO. 30758000
SHEET OF SHEETS 1 OF 1	BUCHANAN ST, DUBOCE AVE & MARKET ST	REV NO. 7