


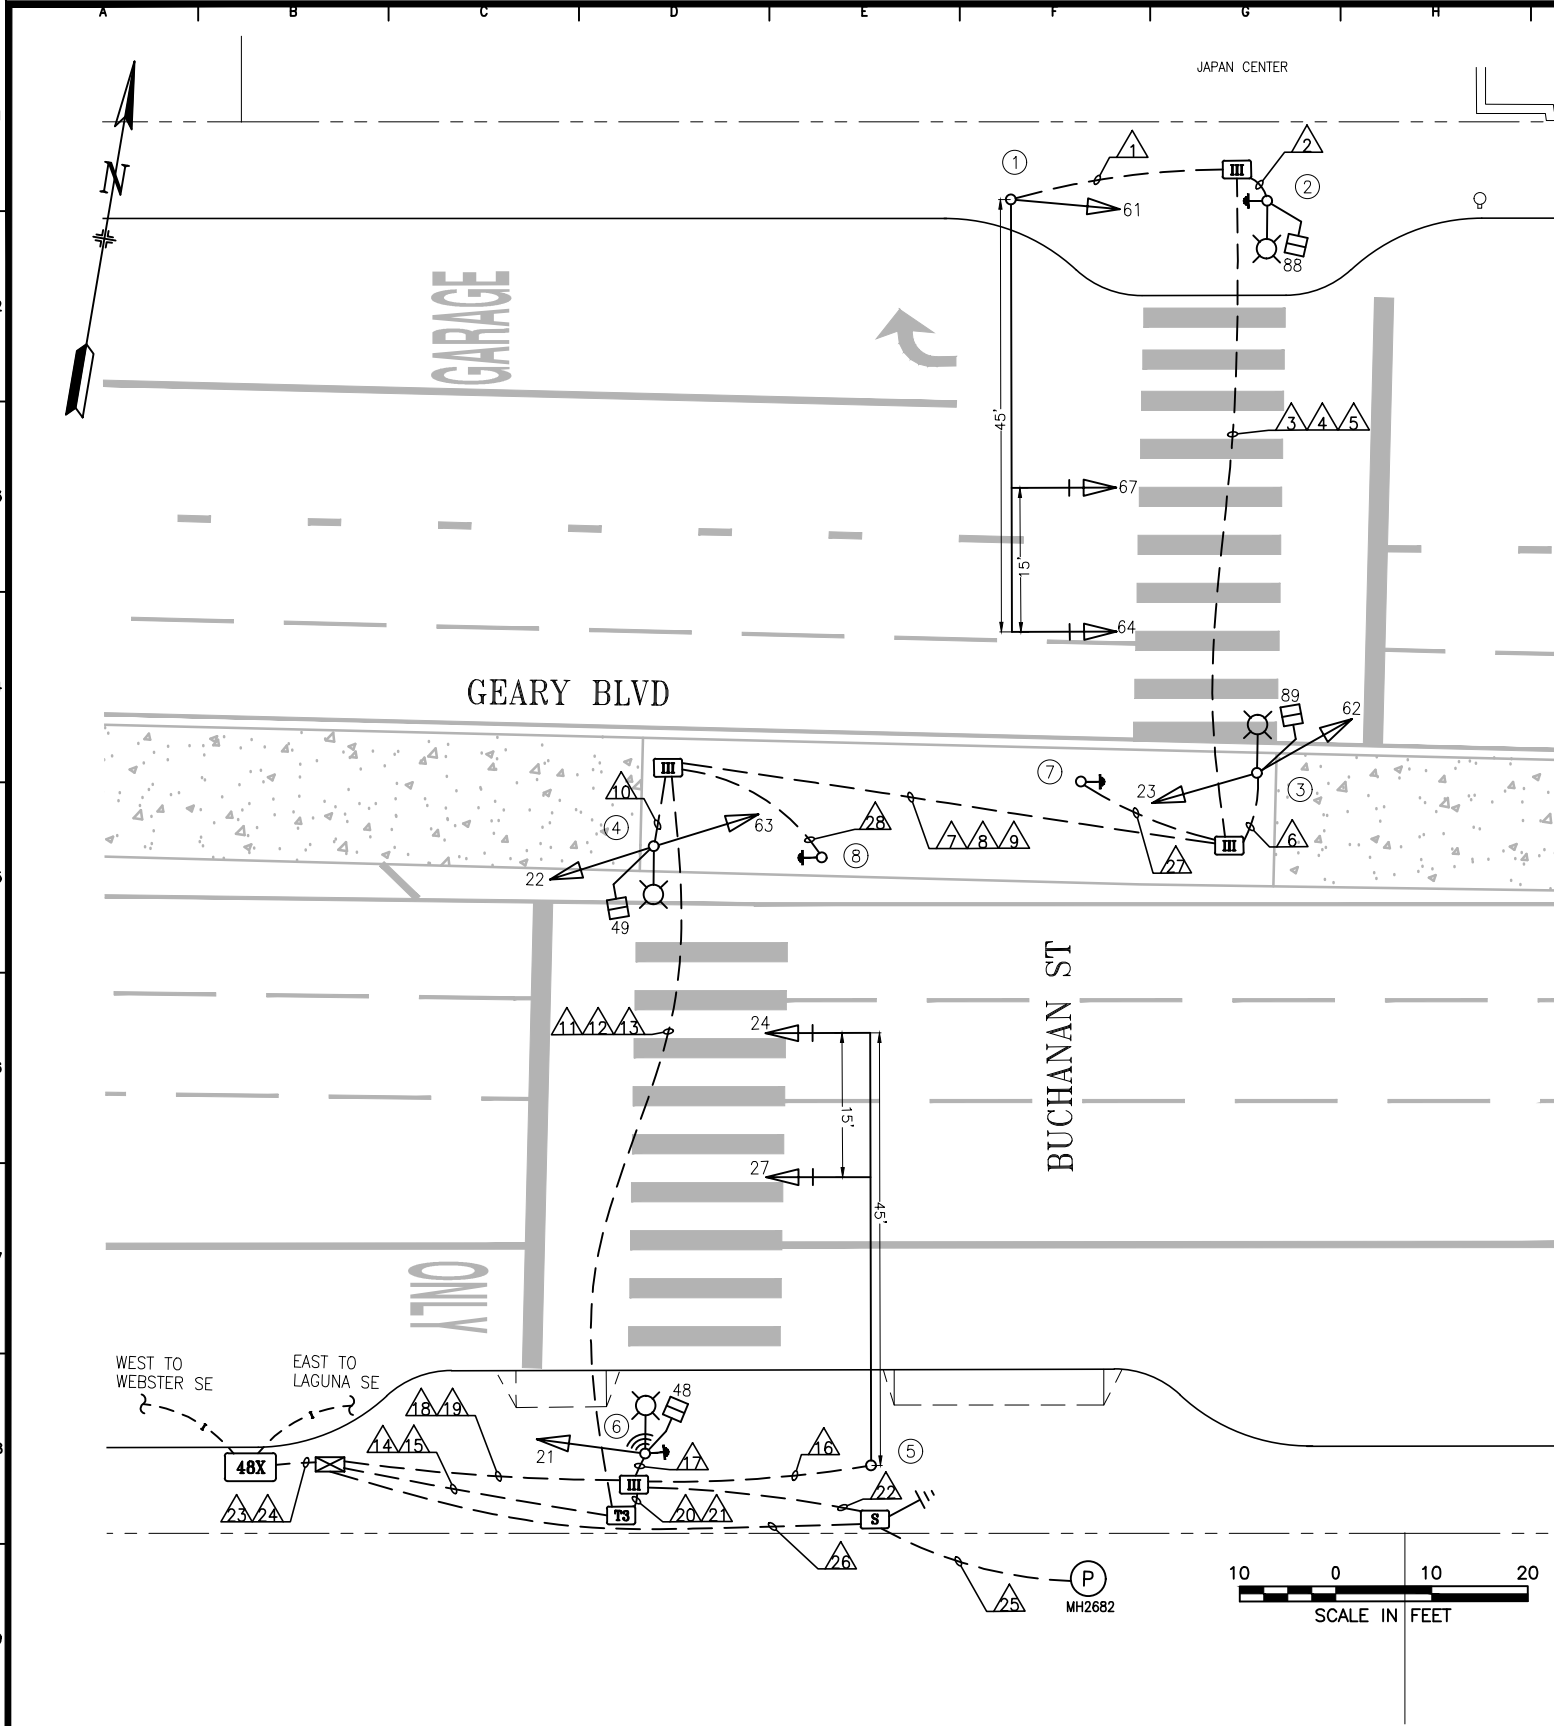

POLE AND EQUIPMENT SCHEDULE											
POLE No.	TYPE OF POLE	FIXTURE TYPE	VEHICLE SIGNAL					PEDESTRIAN SIGNAL			REMARKS
			No.	TYPE	MOUNTING	VISORS	LOUVERS	No.	TYPE	MOUNTING	
①	27-4-100 W/ 45' MAST ARM		61 64 67	3S12" 3S12" 3S12"	SV-1-T MAS MAS	T T T	BP BP				
②	STEEL STREET LIGHT 6' LUMINAIRE ARM	108W LED						88	1S-COUNT	SP-1	APS-2W
③	STEEL STREET LIGHT 6' LUMINAIRE ARM	108W LED	23 62	3S12" 3S12"	SV-1-T SV-1-T	T T		89	1S-COUNT	SP-1	SIGNAL 23 @ 13'
④	STEEL STREET LIGHT 6' LUMINAIRE ARM	108W LED	22 63	3S12" 3S12"	SV-1-T SV-1-T	T T		49	1S-COUNT	SP-1	SIGNAL 63 @ 13'
⑤	27-4-100 W/ 45' MAST ARM		24 27	3S12" 3S12"	MAS MAS	T T	BP BP				
⑥	STEEL STREET LIGHT 6' LUMINAIRE ARM	108W LED	21	3S12"	SV-1-T	T		48	1S-COUNT	SP-1	TSP; OPTICOM APS-2W
⑦	PEDESTRIAN PUSH BUTTON										APS-2W
⑧	PEDESTRIAN PUSH BUTTON										APS-2W

NO.	DATE	DESCRIPTION	BY	APPROVED
1	09/02/21	INSTALLED SIGNALS 23 AND 63 VIA 2608J PCO#20	D. MACKOWSKI	K. KWONG
0	07/29/21	NEW SIGNAL ACTIVATED VIA SRC 2020-315; CONVERTED FROM AS-BUILT FILE #110,932 (E-13.0) OF SFPW 2608J/1000008388 GEARY RAPID WEST OF VN SURFACE CONTRACT	D. MACKOWSKI	K. KWONG
TABLE OF REVISIONS CHECKOUT DRAWING THROUGH THE SID CUSTODIAN FOR THE LATEST REVISION				



SFMTA

DRAWN BY:	DATE:
D. MACKOWSKI	9/21/21
CHECKED BY:	DATE:
K. KWONG	9/30/21

SCALE
AS SHOWN
SHEET OF SHEETS
1 OF 2

TRAFFIC SIGNAL INVENTORY DIAGRAM
BUCHANAN ST & GEARY BLVD

CNN NO:
54015000
REV NO:
1

