


BUCHANAN & GOLDEN GATE

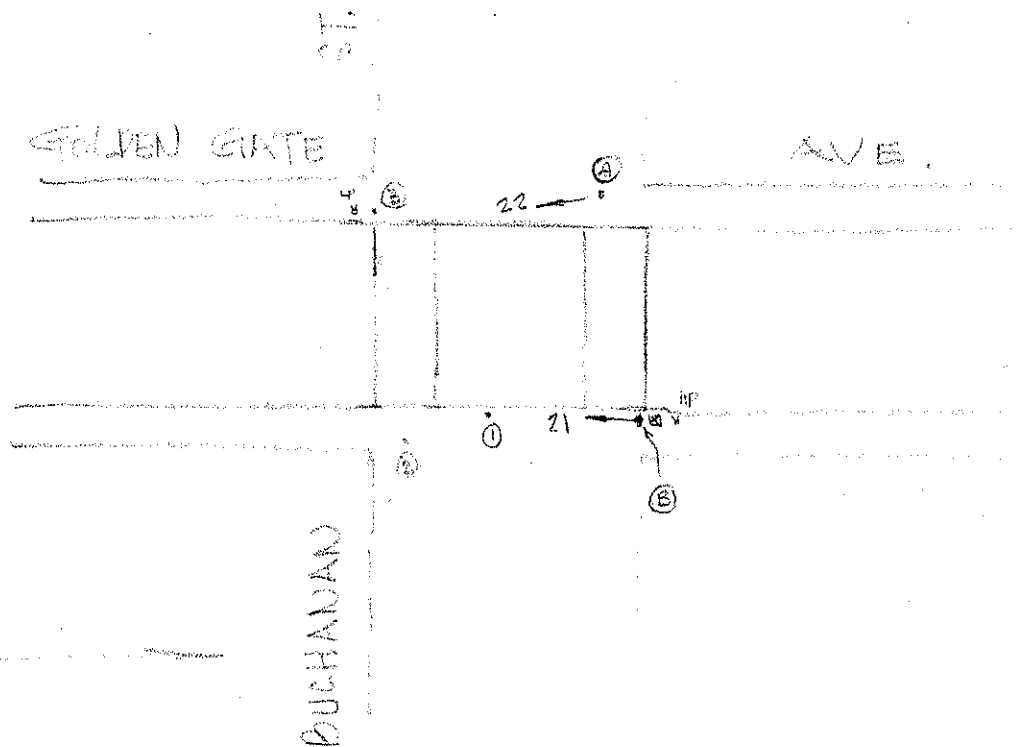

10/7/03

[illegible]

CONTROLLER CABINET SIZE : STD BASE CABINET:           

COMMENTS: