


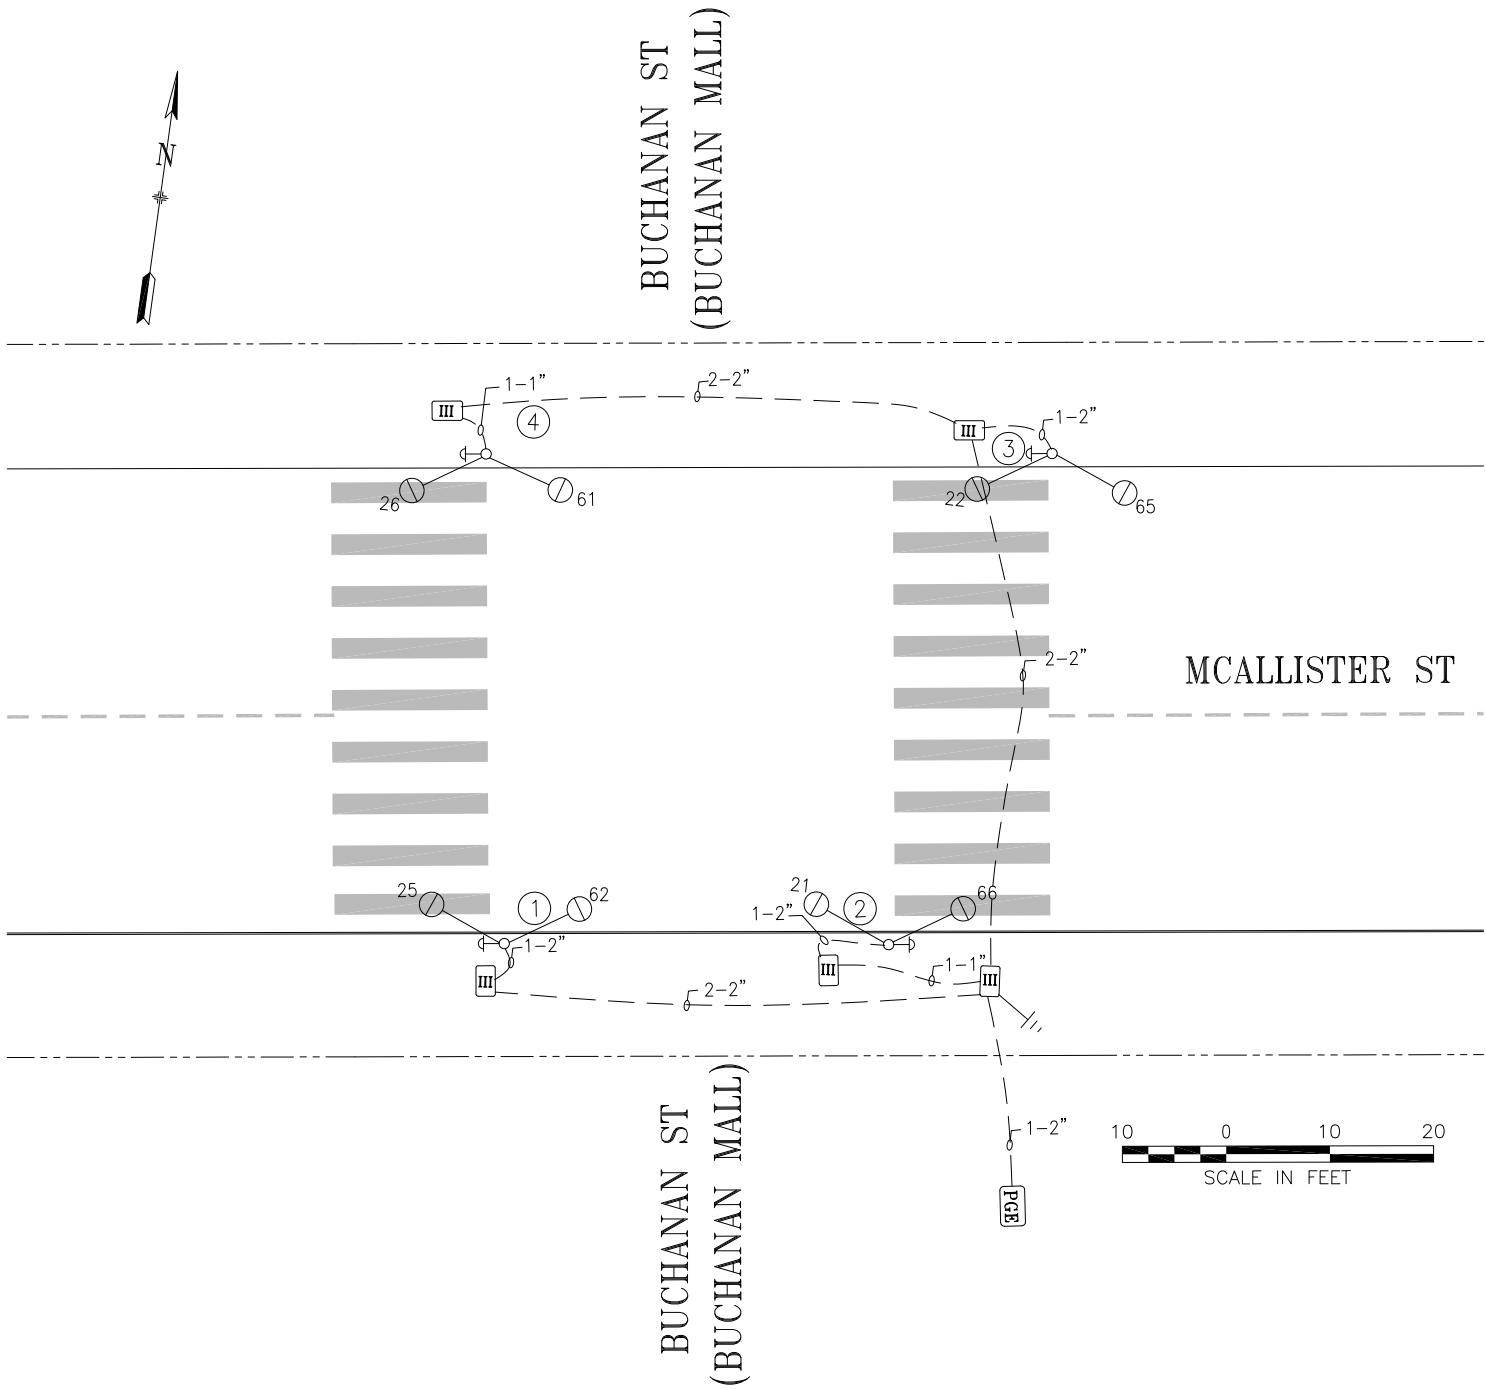

POLE AND EQUIPMENT SCHEDULE						
POLE No.	TYPE OF POLE	VEHICLE SIGNAL				REMARKS/NOTES
		No.	TYPE	MOUNTING	VISORS	
①	1-A (15')	62 25	①	SIDE MOUNT SIDE MOUNT	---	PEDESTRIAN PUSH BUTTON
②	1-A (15')	21 66	①	SIDE MOUNT SIDE MOUNT	---	PEDESTRIAN PUSH BUTTON
③	1-A (15')	22 65	①	SIDE MOUNT SIDE MOUNT	---	PEDESTRIAN PUSH BUTTON
④	1-A (15')	26 61	①	SIDE MOUNT SIDE MOUNT	---	PEDESTRIAN PUSH BUTTON

SHEET NOTES:

① JSF TECHNOLOGIES SOLAR POWERED AB-9407 AC DUAL SIDED BLACK RECTANGULAR RAPID FLASHING BEACON ASSEMBLY

NO.		DATE	DESCRIPTION	BY	APP.
0		02/19/18	NEW BEACON ACTIVATED BY MR 1290R	K.Shue	K.Kwong
TABLE OF REVISIONS					
CHECK WITH TRACING TO SEE IF YOU HAVE LATEST REVISION					

REFERENCE INFORMATION & FILE NO. OF SURVEYS
--



SAN FRANCISCO MUNICIPAL TRANSPORTATION AGENCY
CITY AND COUNTY OF SAN FRANCISCO

DRAWN: K.SHUE	DATE: 7/2018
CHECKED: K.KWONG	DATE: 7/2018

SCALE:
AS SHOWN
SHEET OF SHEETS
1 OF 1

TRAFFIC SIGNAL INVENTORY DIAGRAM
MCALLISTER STREET AT BUCHANAN STREET

CNN NO.
54061000
REV. NO.
0