


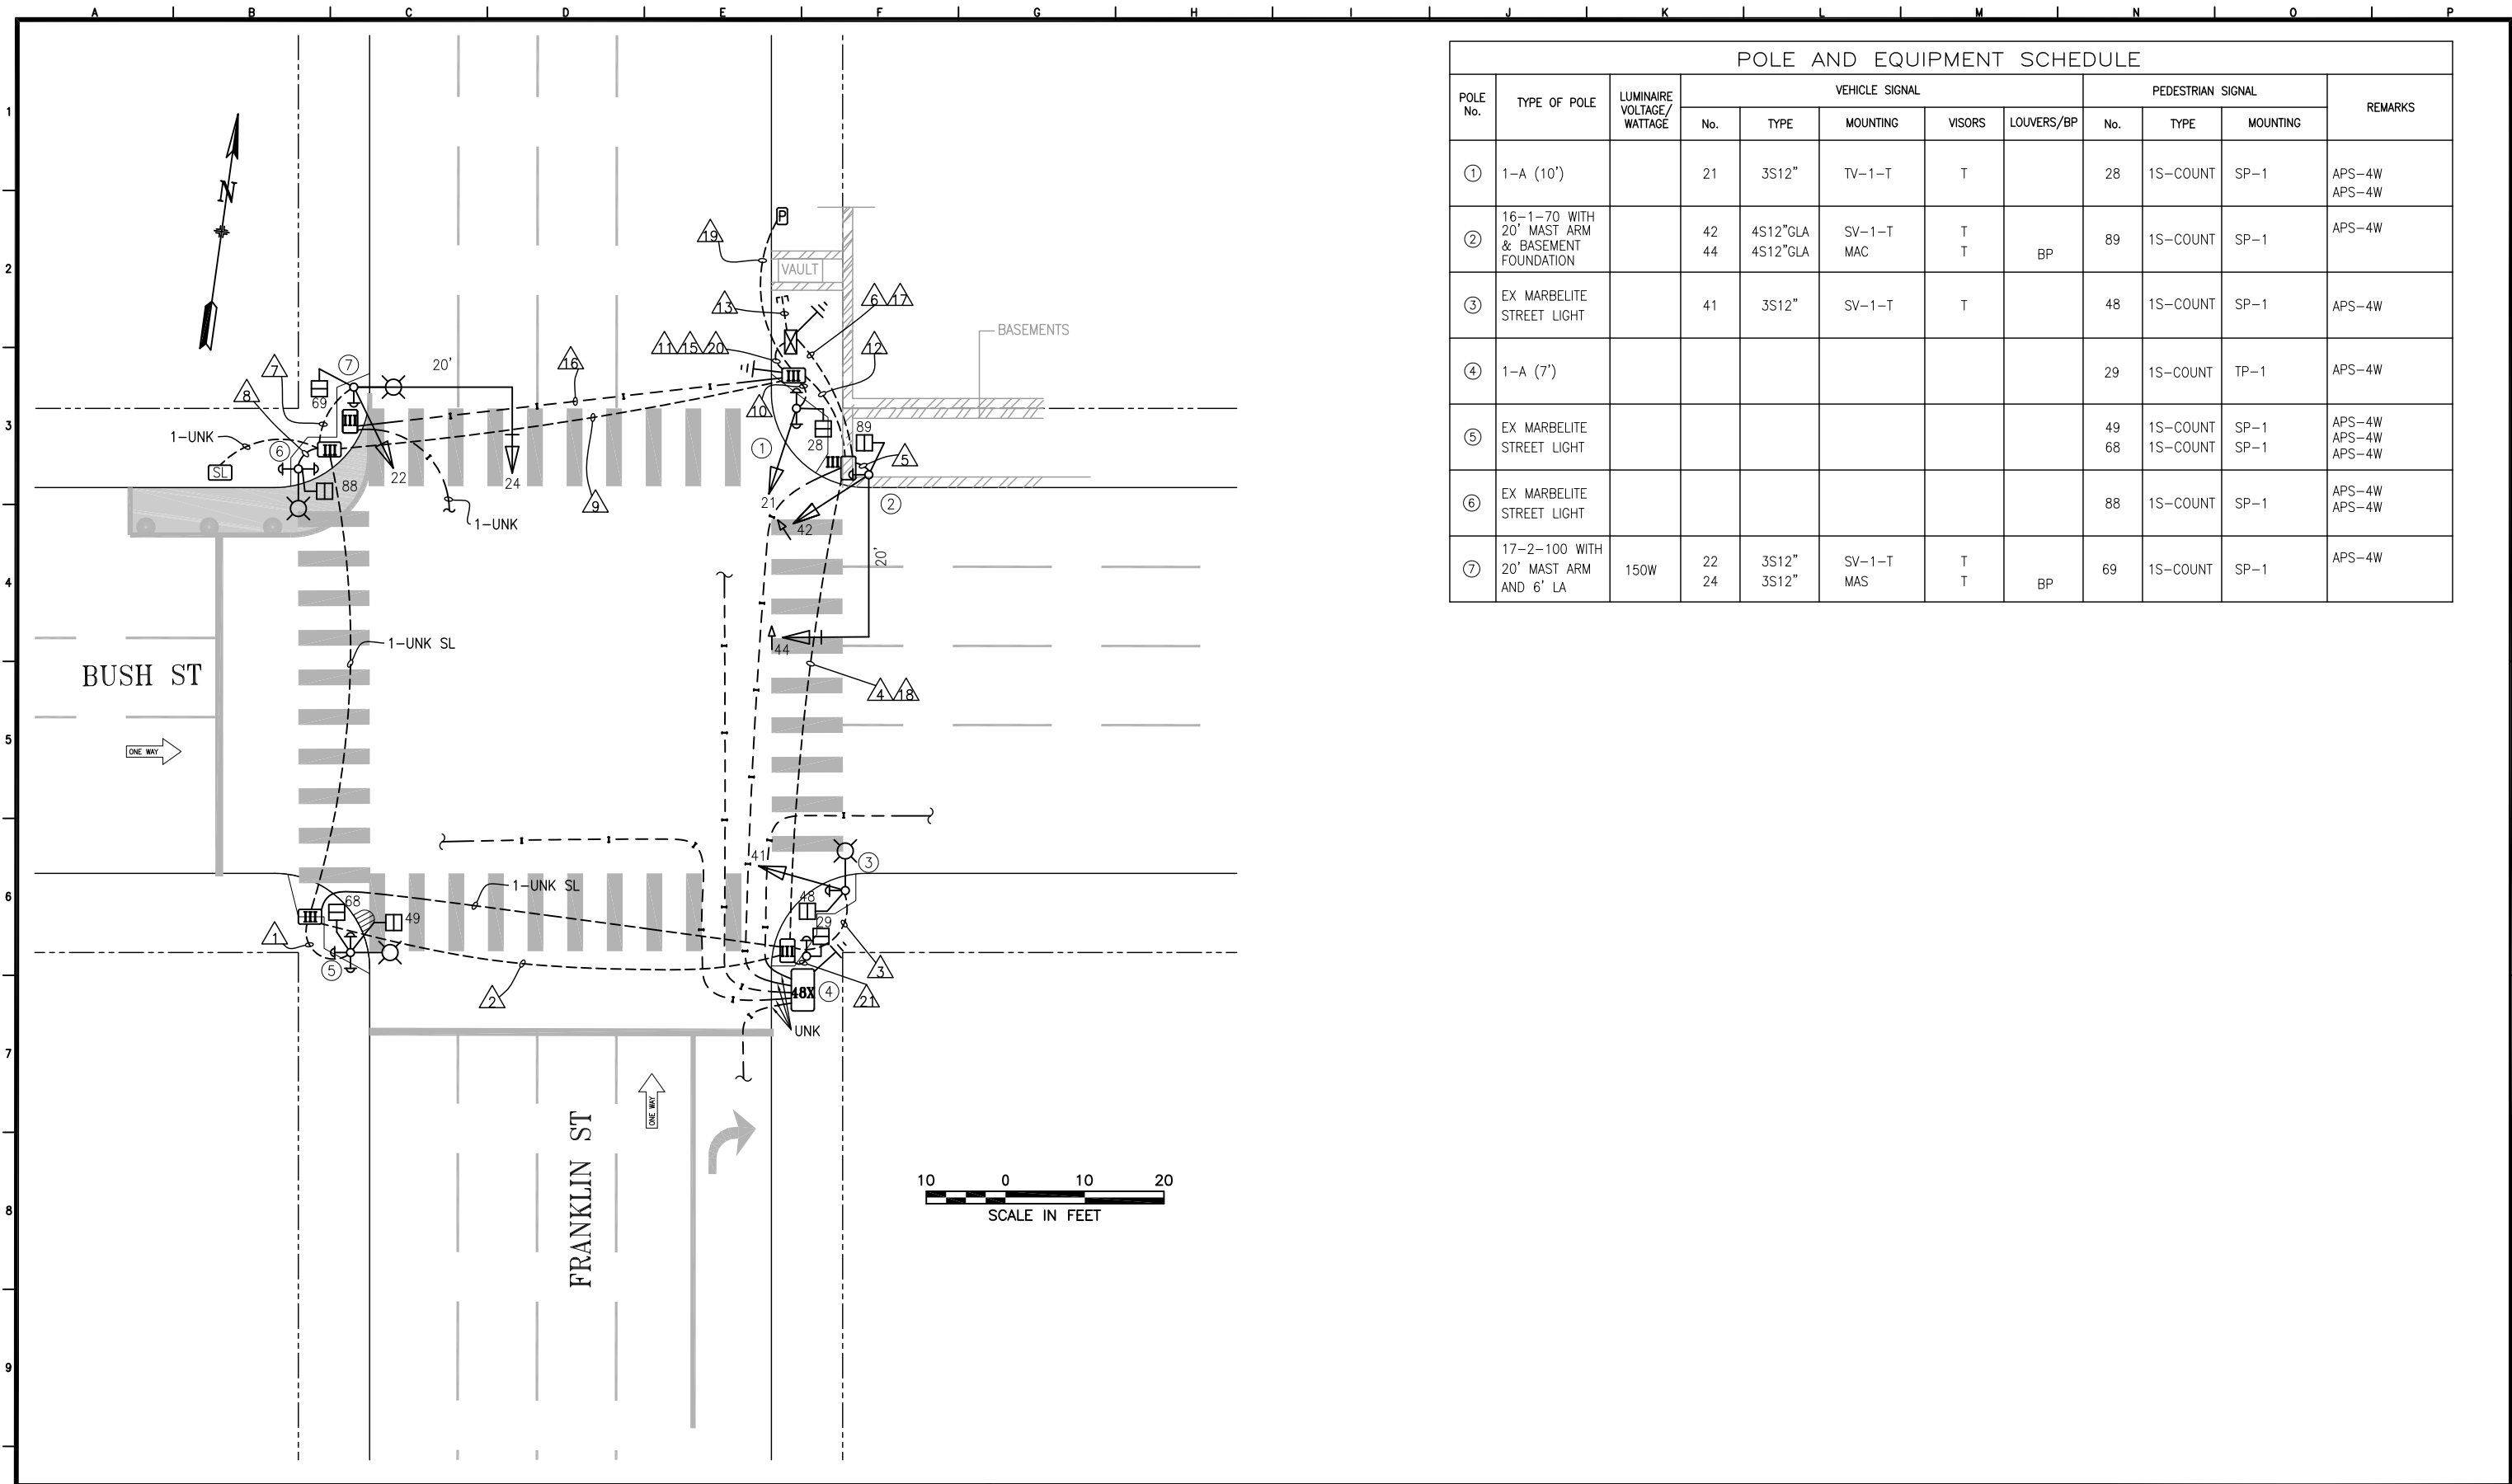

POLE AND EQUIPMENT SCHEDULE											
POLE No.	TYPE OF POLE	LUMINAIRE VOLTAGE/WATTAGE	VEHICLE SIGNAL					PEDESTRIAN SIGNAL			REMARKS
			No.	TYPE	MOUNTING	VISORS	LOUVERS/BP	No.	TYPE	MOUNTING	
①	1-A (10')		21	3S12"	TV-1-T	T		28	1S-COUNT	SP-1	APS-4W APS-4W
②	16-1-70 WITH 20' MAST ARM & BASEMENT FOUNDATION		42 44	4S12"GLA 4S12"GLA	SV-1-T MAC	T T	BP	89	1S-COUNT	SP-1	APS-4W
③	EX MARBELITE STREET LIGHT		41	3S12"	SV-1-T	T		48	1S-COUNT	SP-1	APS-4W
④	1-A (7')							29	1S-COUNT	TP-1	APS-4W
⑤	EX MARBELITE STREET LIGHT							49 68	1S-COUNT 1S-COUNT	SP-1 SP-1	APS-4W APS-4W APS-4W
⑥	EX MARBELITE STREET LIGHT							88	1S-COUNT	SP-1	APS-4W APS-4W
⑦	17-2-100 WITH 20' MAST ARM AND 6' LA	150W	22 24	3S12" 3S12"	SV-1-T MAS	T T	BP	69	1S-COUNT	SP-1	APS-4W

Δ	10/13/22	CHANGE SIGNAL 42 & 44 TO 4-SECTION HEAD PER SRC 2022-202	D. YEUNG	G. DELEON
Δ	10/6/16	UPDATED PER CONTRACT 2596J CONSTRUCTION PLAN	D. YEUNG	G. DELEON
Δ	3/28/04	CONVERTED FROM CONTRACT 0286J CONSTRUCTION PLAN	D. YEUNG	G. DELEON
NO.	DATE	DESCRIPTION	BY	APPROVED
TABLE OF REVISIONS				
CHECKOUT DRAWING THROUGH THE SID CUSTODIAN FOR THE LATEST REVISION				



SFMTA

DRAWN BY: D. YEUNG	DATE: 8/2022
CHECKED BY: G. DELEON	DATE: 8/2022

SCALE AS SHOWN
SHEET OF SHEETS 1 OF 2

TRAFFIC SIGNAL INVENTORY DIAGRAM
BUSH ST AND FRANKLIN ST

CNN NO: 26498000
REV NO: 2

