


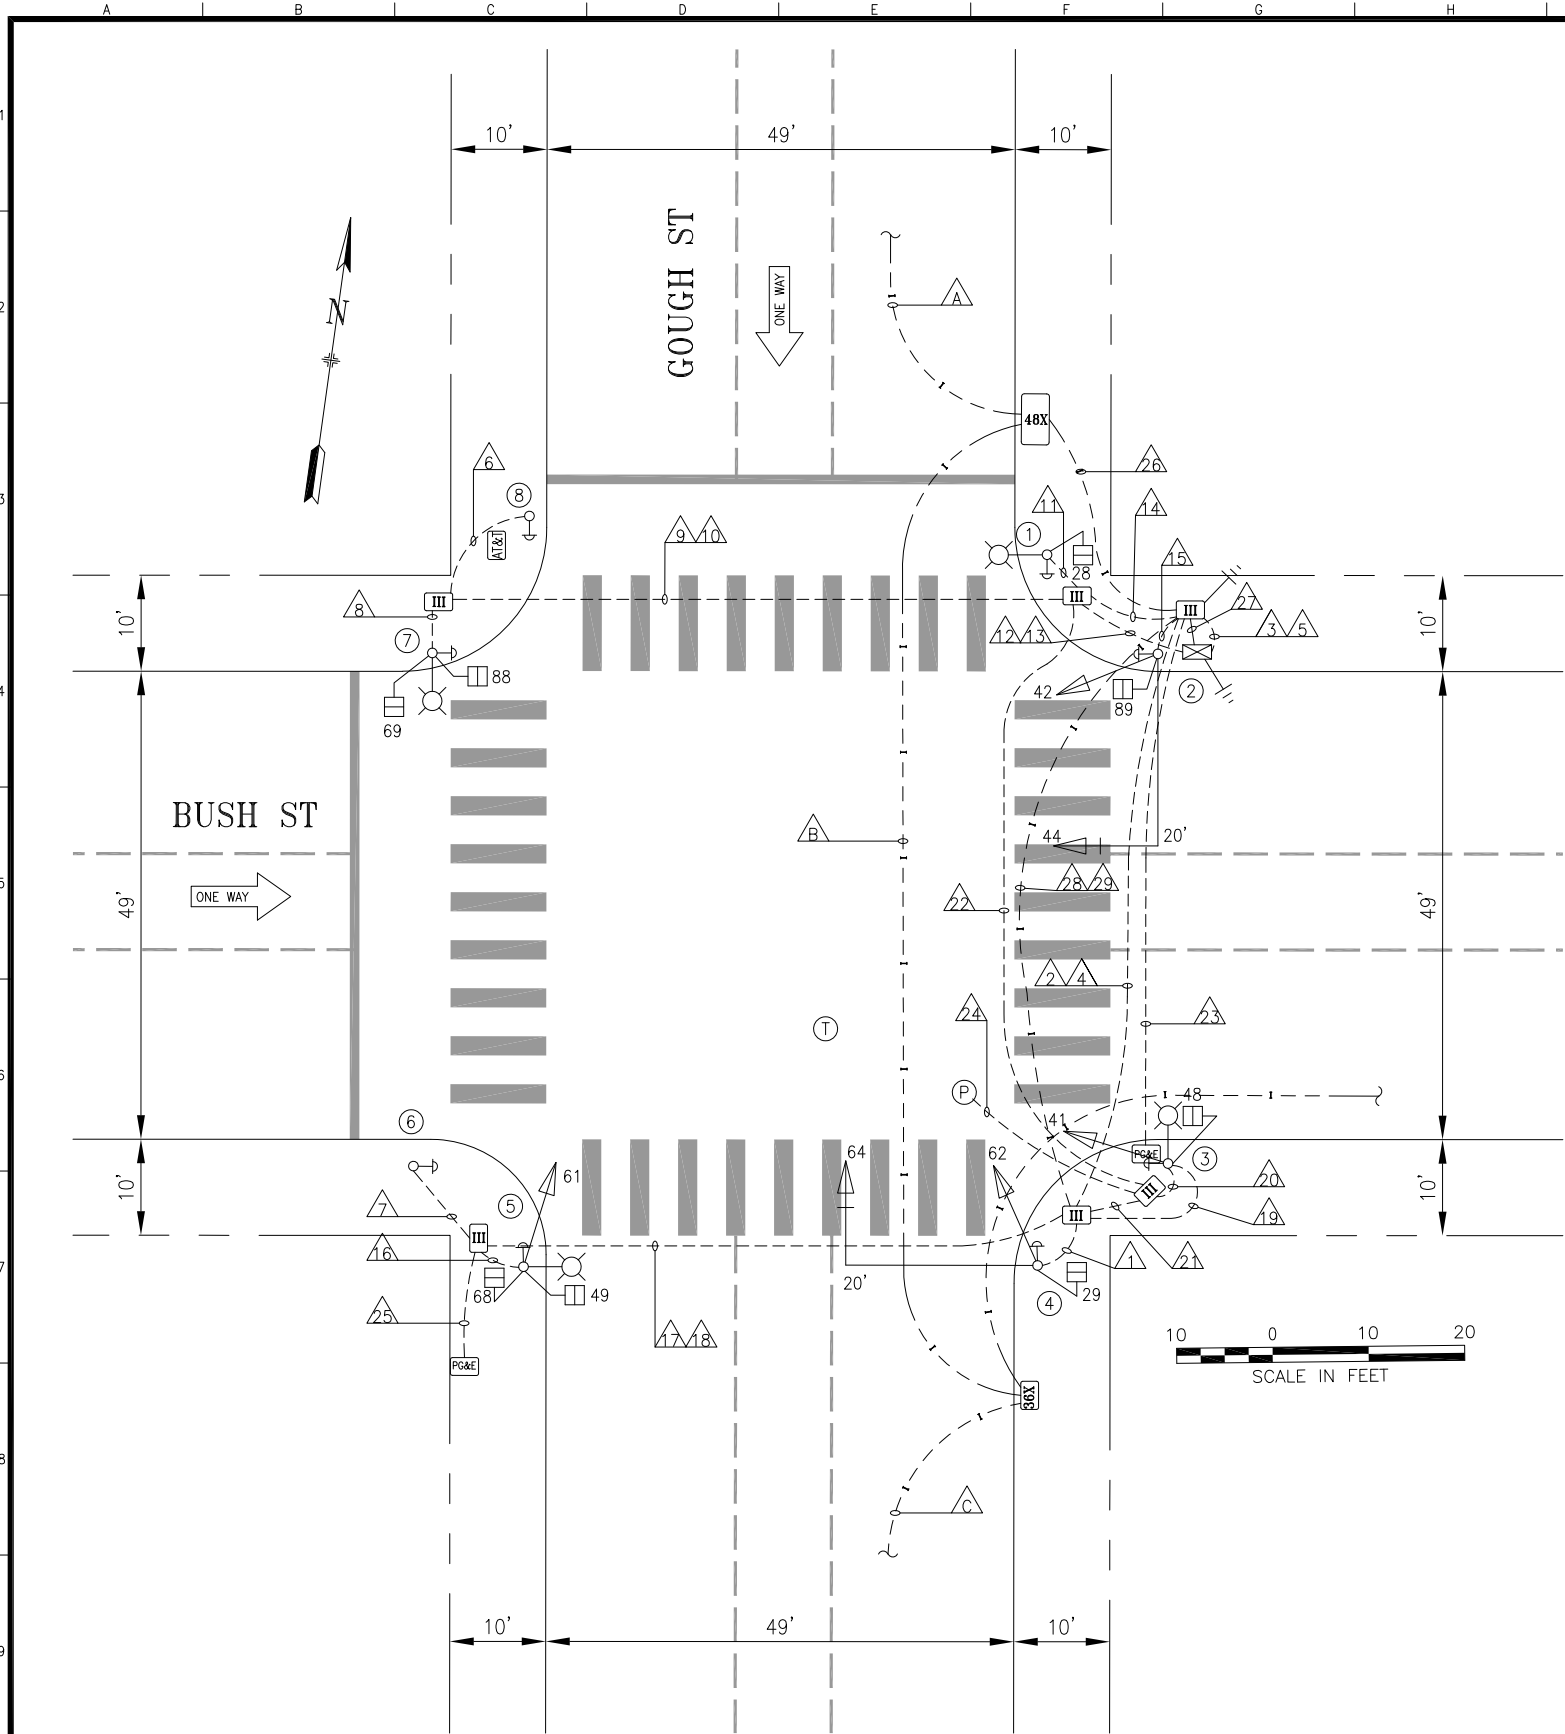

POLE AND EQUIPMENT SCHEDULE											
POLE No.	TYPE OF POLE	LUMINAIRE VOLTAGE/WATTAGE	VEHICLE SIGNAL					PEDESTRIAN SIGNAL			REMARKS
			No.	TYPE	MOUNTING	VISORS	LOUVERS/BP	No.	TYPE	MOUNTING	
①	MARBELITE STREET LIGHT	108W LED						28	1S-COUNT	SP-1	APS-3W
②	16-1-100 W/ 20' MAST ARM		42 44	3S12" 3S12"	SV-1-T MAS	T T	BP	89	1S-COUNT	SP-1	APS-3W
③	MARBELITE STREET LIGHT	73W LED	41	3S12"	SV-1-T	T		48	1S-COUNT	SP-1	APS-3W
④	16-2-100 W/ 20' MAST ARM		62 64	3S12" 3S12"	SV-1-T MAS	T T	BP	29	1S-COUNT	SP-1	APS-3W
⑤	MARBELITE STREET LIGHT	108W LED	61	3S12"	SV-1-T	T		49 68	1S-COUNT 1S-COUNT	SP-1 SP-1	APS-3W
⑥	PPB POLE										APS-3W
⑦	MARBELITE STREET LIGHT	73W LED						69 88	1S-COUNT 1S-COUNT	SP-1 SP-1	APS-3W
⑧	PPB POLE										APS-3W

1	03/05/21	PER SRC 2020-063, INSTALL APS		C SKERRIT	G DELEON
0	09/12/19	SIGNAL UPGRADE BY 3003J, CONVERTED FROM CONTRACT PLAN, 0286J CONTRACT PLAN, AND BUSH/GOUGH SID REV 2 (2018)		C SKERRIT	G DELEON
NO.	DATE	DESCRIPTION	BY	APP.	
TABLE OF REVISIONS					
CHECK WITH TRACING TO SEE IF YOU HAVE LATEST REVISION					

REFERENCE INFORMATION & FILE NO. OF SURVEYS
--



SAN FRANCISCO MUNICIPAL TRANSPORTATION AGENCY

CITY AND COUNTY OF SAN FRANCISCO

DRAWN:	DATE:
C SKERRIT	12/2019
CHECKED:	DATE:
G DELEON	12/2019

SCALE:
AS SHOWN
SHEET OF SHEETS
1 OF 2

TRAFFIC SIGNAL INVENTORY DIAGRAM
BUSH STREET AND GOUGH STREET

CNN NO.
26504000
REV NO.
1

[illegible]

- ① CONDUIT RUNS A, B, AND C CONTAIN 4 CONDUITS EACH
- ② BELDEN CABLE 8489 (OR EQUIVALENT) WIRING PULLED FROM APS PPB TO PED SIGNAL

[illegible]