


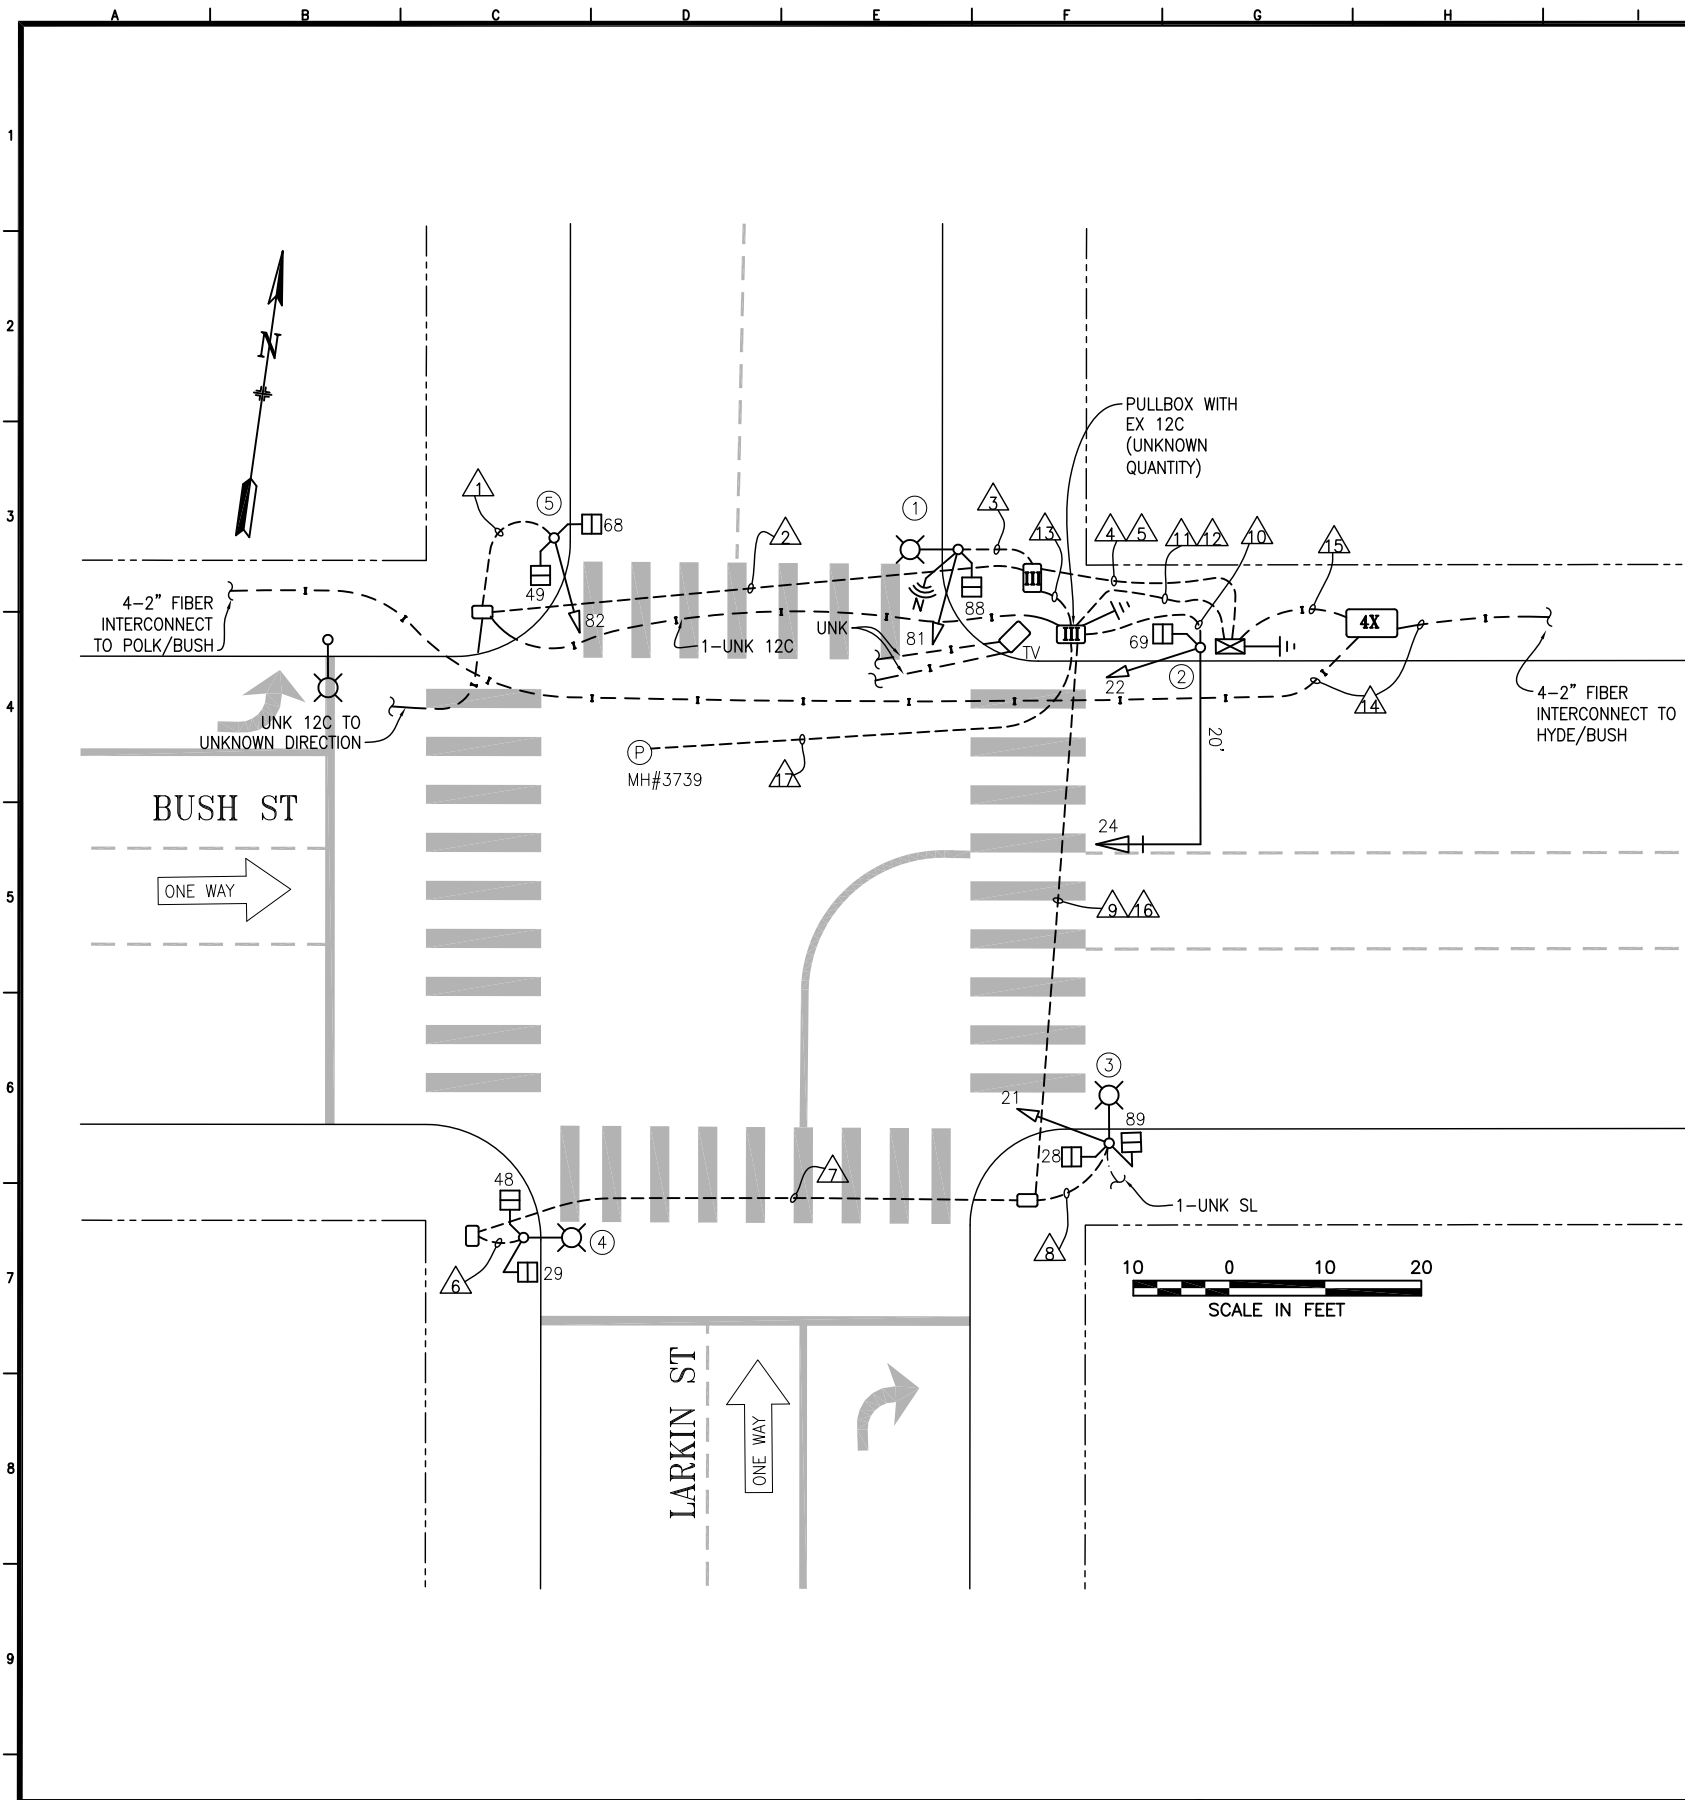

POLE AND EQUIPMENT SCHEDULE										
POLE No.	TYPE OF POLE	VEHICLE SIGNAL					PEDESTRIAN SIGNAL			REMARKS
		No.	TYPE	MOUNTING	VISORS	LOUVERS/BP	No.	TYPE	MOUNTING	
①	STREETLIGHT W/ 6' LA	81	3S8"	SV-1-T	T		88	1S-COUNT	SP-1	NETWORK RADIO
②	16-1-70 W/ 20' MA	24 22	3S12" 3S8"	MAS SV-1-T	T T	BP	69	1S-COUNT	SP-1	
③	STREETLIGHT	21	3S8"	SV-1-T	T		28 89	1S-COUNT 1S-COUNT	SP-1 (22") SP-1-SF (12")	
④	STREETLIGHT W/ 6' LA						29 48	1S-COUNT 1S-COUNT	SP-1 SP-1	
⑤	1-A (10')	82	3S8"	TV-1-T	T		49 68	1S-COUNT 1S-COUNT	SP-1 (22") SP-1-SF (12")	

Δ	8/15/23	UPDATE PER FIELD: ADD NETWORK RADIO. 82 IS TV-1-T	D. YEUNG	G. DE LEON	
Δ	3/24/04	CONVERTED FROM CONTRACT 0286J CONSTRUCTION PLAN	D. YEUNG	G. DE LEON	
NO.	DATE	DESCRIPTION	BY	APPROVED	
TABLE OF REVISIONS					
CHECKOUT DRAWING THROUGH THE SID CUSTODIAN FOR THE LATEST REVISION					



SFMTA

DRAWN BY: D. YEUNG	DATE: MAR 2023
CHECKED BY: G. DE LEON	DATE: MAR 2023

SCALE AS SHOWN
SHEET OF SHEETS 1 OF 2

TRAFFIC SIGNAL INVENTORY DIAGRAM
BUSH ST AND LARKIN ST

CNN NO: 25204000
REV NO: 1

[illegible]