


BUSH & MONTGOMERY

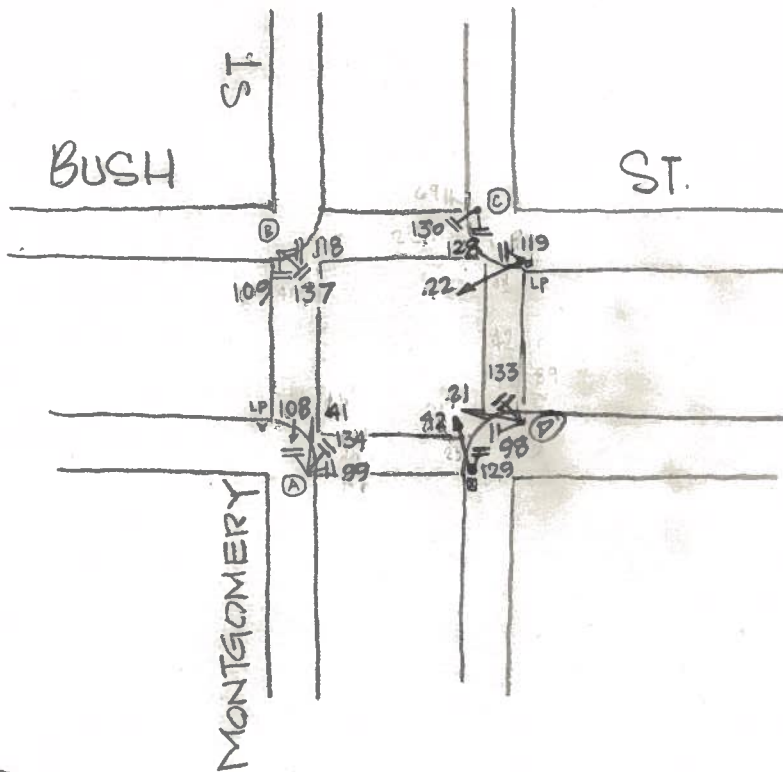

09/28/2019

POLE	FUNC.	MAT'L	SIGNAL NO.	MAKE	NO. OF SECT.	SIZE	VISOR	B.P. OR LOUVERS	MOUN'T	PED SIGNAL NO.	LEGEND	MESSAGE		MAKE	MOUN'T
												ELEMENT	COLOR		
A	S	S	21	ICC	3	8"	FTT	NO	TV-1	98	COUNT	IS	W/OR	ICC	S
B	S	S	22	ICC	3	8"	FTT	NO	TV-1	99	COUNT	IS	W/OR	ICC	SP-1
C	S	S	41	ICC	3	8"	FTT	NO	TV-T-T	100	COUNT	IS	W/OR	ICC	S
D	S	S	42	ICC	3	12"	FTT	NO	TV-T-T	109	COUNT	IS	W/OR	ICC	T
										118	COUNT	IS	W/OR	ICC	T
										119	COUNT	IS	W/OR	ICC	SP-1
										128	COUNT	IS	W/OR	ICC	S
										129	COUNT	IS	W/OR	ICC	SP-1
										130	COUNT	IS	W/OR	ICC	S
										133	COUNT	IS	W/OR	ICC	S
										134	COUNT	IS	W/OR	ICC	S
										137	COUNT	IS	W/OR	ICC	T

CONTROLLER CABINET SIZE : MSFNARY BASE CABINET: NO

COMMENTS : NOMA SOMA RETIMING : UPDATE PED PHASE LABEL (SRC 2019-228)
 UPDATE VEH PHASE LABEL AS PER TIMING CARD
 - C. SKERRIT 09/28/2019