


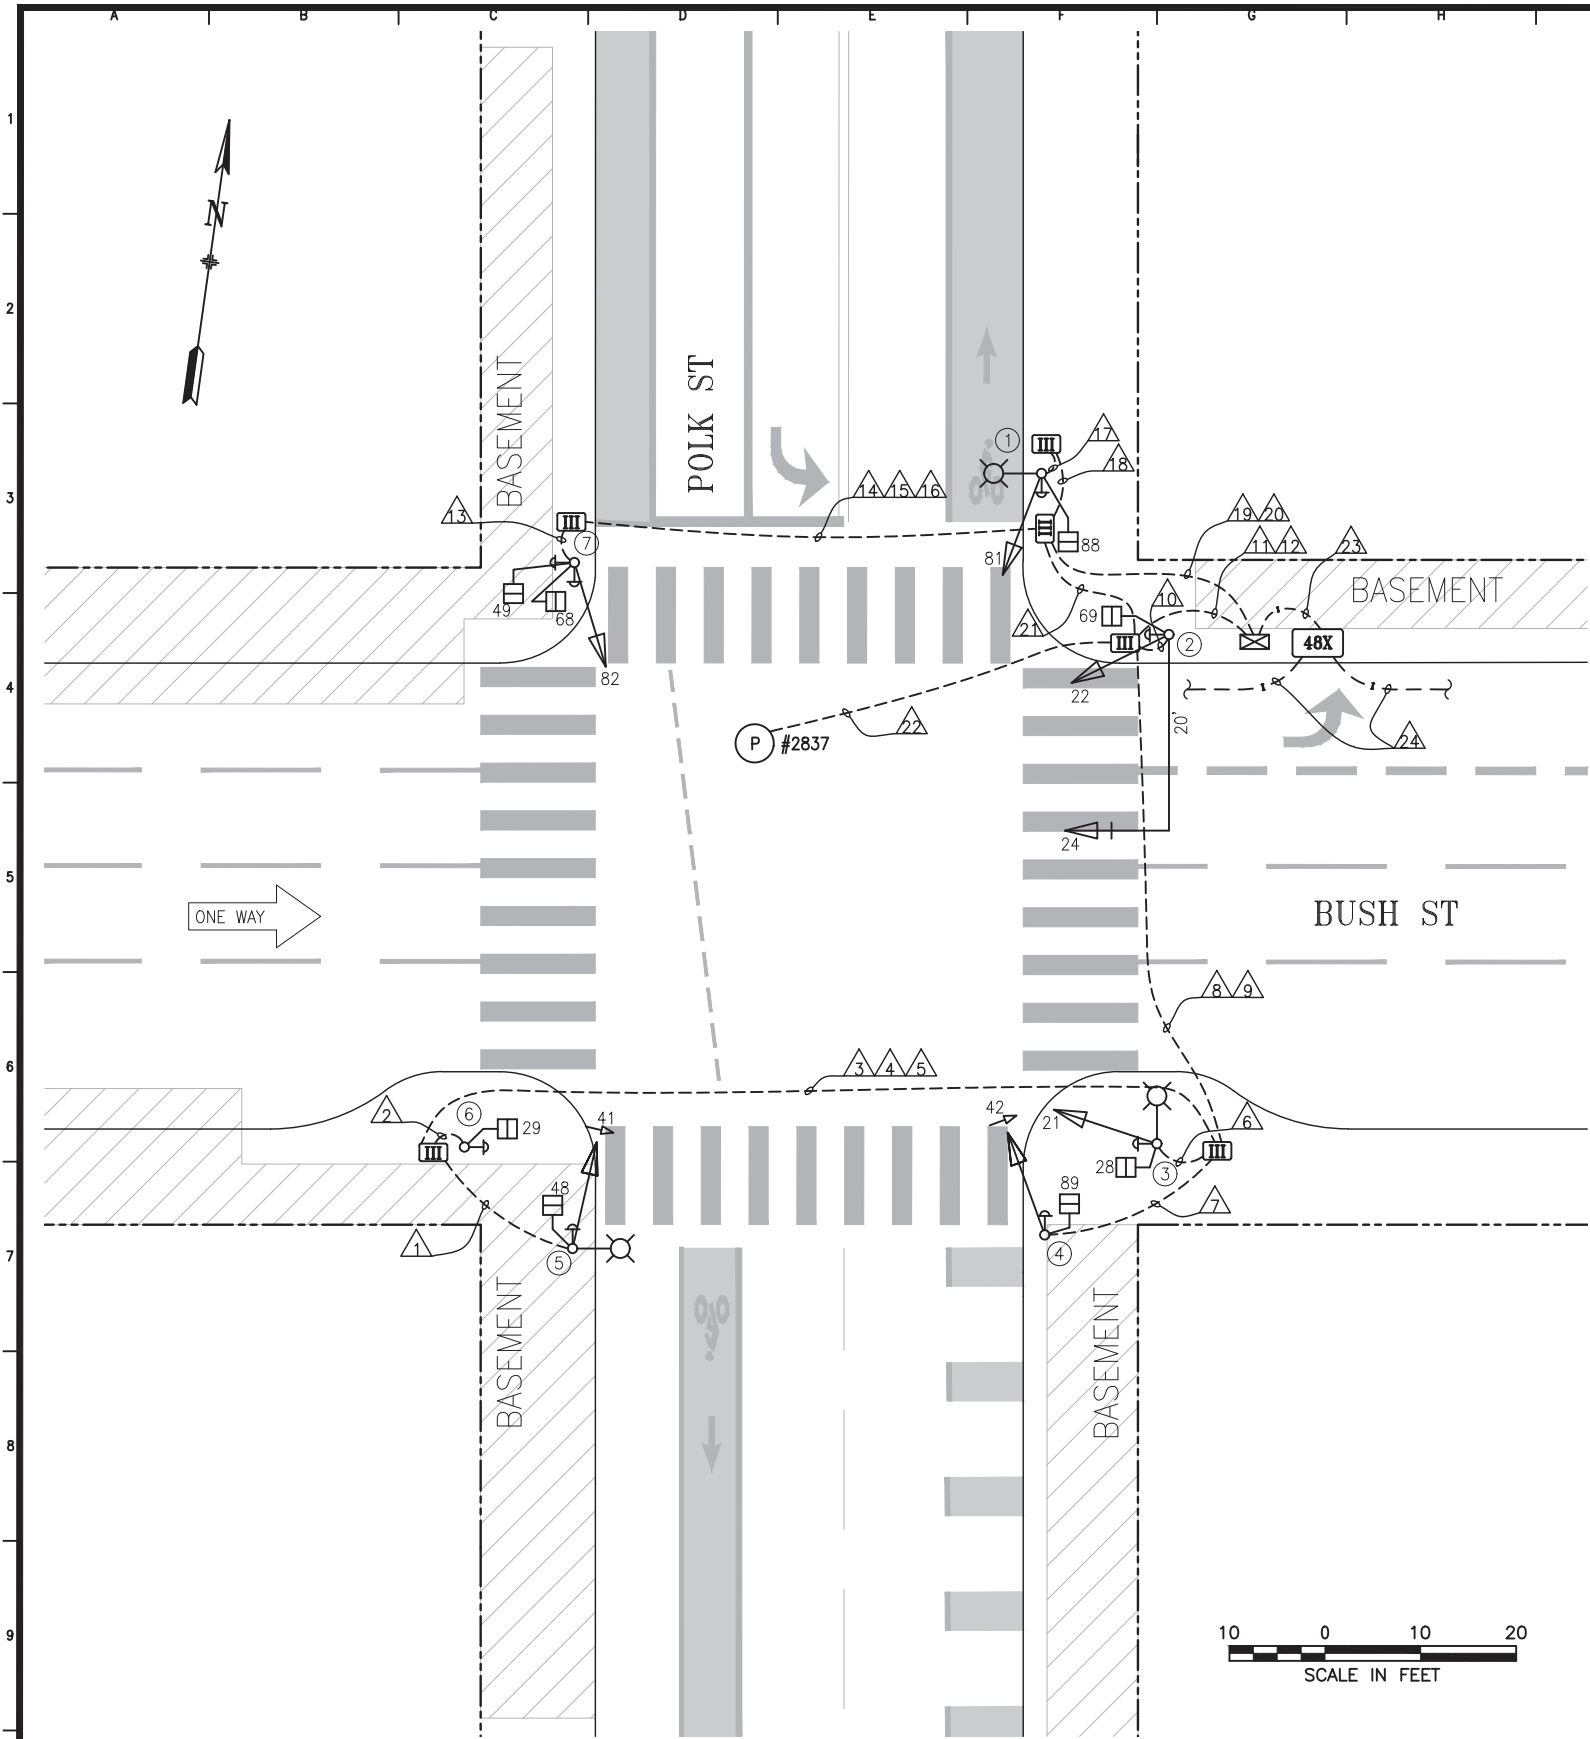

POLE AND EQUIPMENT SCHEDULE											
POLE No.	TYPE OF POLE	LUMINAIRE VOLTAGE/ WATTAGE	VEHICLE SIGNAL					PEDESTRIAN SIGNAL			REMARKS
			No.	TYPE	MOUNTING	VISORS	LOUVERS	No.	TYPE	MOUNTING	
①	ORNAMENTAL STREET LIGHT		81	3S12"	SV-1-T	T		88	1S-COUNT	SP-1	APS-4W
②	16-1-70 W/ 20' MAST ARM		22 24	3S12" 3S12"	SV-1-T MAS	T T		69	1S-COUNT	SP-1	APS-4W
③	CITY STANDARD STREET LIGHT		21	3S12"	SV-1-T	T		28	1S-COUNT	SP-1	APS-4W
④	1-A (10')		42	4S12"GLA	TV-1-T	T		89	1S-COUNT	SP-1	APS-4W
⑤	CITY STANDARD STREET LIGHT		41	4S12"GLA	SV-1-T	T		48	1S-COUNT	SP-1	APS-4W
⑥	1-A (7')							29	1S-COUNT	TP-1	APS-4W
⑦	1-A (10')		82	3S12"	TV-1-T	T		49 68	1S-COUNT 1S-COUNT	SP-1 SP-1	APS-4W APS-4W

NO.	DATE	DESCRIPTION	BY	APPROVED
2	7/16/19	APS INSTALLED PER SRC 2019-188	J.HORNBOSTEL	G.DeLEON
1	3/13/19	Ø7 SIGNALS ACTIVATED	J.HORNBOSTEL	G.DeLEON
0	7/10/18	SIGNAL MOD BY 2126J, CONVERTED FROM 2126J & 0286J AS-BUILTS; Ø7 SIGNALS TAPED UP AND INACTIVE	J.HORNBOSTEL	G.DeLEON
TABLE OF REVISIONS CHECKOUT DRAWING THROUGH THE SID CUSTODIAN FOR THE LATEST REVISION				



SFMTA

DRAWN BY: J. HORNBOSTEL	DATE: 8/2021	SCALE AS SHOWN	TRAFFIC SIGNAL INVENTORY DIAGRAM	CNN NO: 52510000
CHECKED BY: G. DeLEON	DATE: 8/2021	SHEET OF SHEETS 01 OF 02		REV NO:

BUSH STREET AND POLK STREET

2

CONDUIT AND WIRING SCHEDULE (FURNISH AND INSTALL CONDUIT AND WIRES)																									
CONDUIT RUN NUMBER		1	2	3	4	5	6	7	8	9	10	11	12	13	14	15	16	17	18	19	20	21	22	23	24
CONDUIT SIZE (INCH)		2	2	2	2	2	2	2	2	2	2	3	2	2	2	2	2	1.5	2	3	2	2	2	3	4x2
		GRS			SP	SP										SP	SP	GRS			SP				
NOTES																									
	VEHICLE SIGNAL 41	4		4					4			4													
	PED SIGNAL 48	2		2					2			2													
	PED SIGNAL 29		2	2					2			2													
	VEHICLE SIGNAL 21						3		3			3													
	PED SIGNAL 28						2		2			2													
	VEHICLE SIGNAL 42							4	4			4													
	PED SIGNAL 89							2	2			2													
	VEHICLE SIGNAL 22										3	3													
	VEHICLE SIGNAL 24										3	3													
	PED SIGNAL 69										2	2													
	VEHICLE SIGNAL 82												3	3						3					
	PED SIGNAL 49												2	2						2					
	PED SIGNAL 68												2	2						2					
	VEHICLE SIGNAL 81																	3	3	3					
	PED SIGNAL 88																	2	2	2					
	#14 NEUTRAL	2	1				2	2			3			3				2	2						
	#14 SPARE			3					3			3			3					3					
	TOTAL #14 WIRES	8	3	11			7	8	22		11	30		10	10			7	7	15					
	#10 WIRES NEUTRAL			1					2			3			1					2					
	#10 WIRES STREET LIGHT						2																		
	#8 WIRES STREET LIGHT									2												2			
	#8 WIRES (120 V SERVICE)											2										2			
	#6 BSCW (SEE SHEET NOTE 1)																						1		
	INTERCONNECT-FIBER-OPTIC CABLE W/ 12 STRANDS																							1	
	INTERCONNECT-FIBER-OPTIC CABLE W/ 144 STRANDS																								
	4 WIRE BELDEN 8489 (OR EQUIVALENT) FOR																								
	APS PPB ON POLE 5 (LAND IN P.S. 29 ON POLE 6)	1	1																						
	APS PPB ON POLE 6 (LAND IN P.S. 48 ON POLE 5)	1	1																						
	APS PPB ON POLE 3 (LAND IN P.S. 89 ON POLE 4)						1	1																	
	APS PPB ON POLE 4 (LAND IN P.S. 28 ON POLE 3)						1	1																	
	APS PPB ON POLE 7 (LAND IN P.S. 49 ON POLE 7)																								
	APS PPB ON POLE 7 (LAND IN P.S. 68 ON POLE 7)																								
	APS PPB ON POLE 2 (LAND IN P.S. 88 ON POLE 1)										1							1	1			1			
	APS PPB ON POLE 1 (LAND IN P.S. 69 ON POLE 2)										1							1	1			1			