


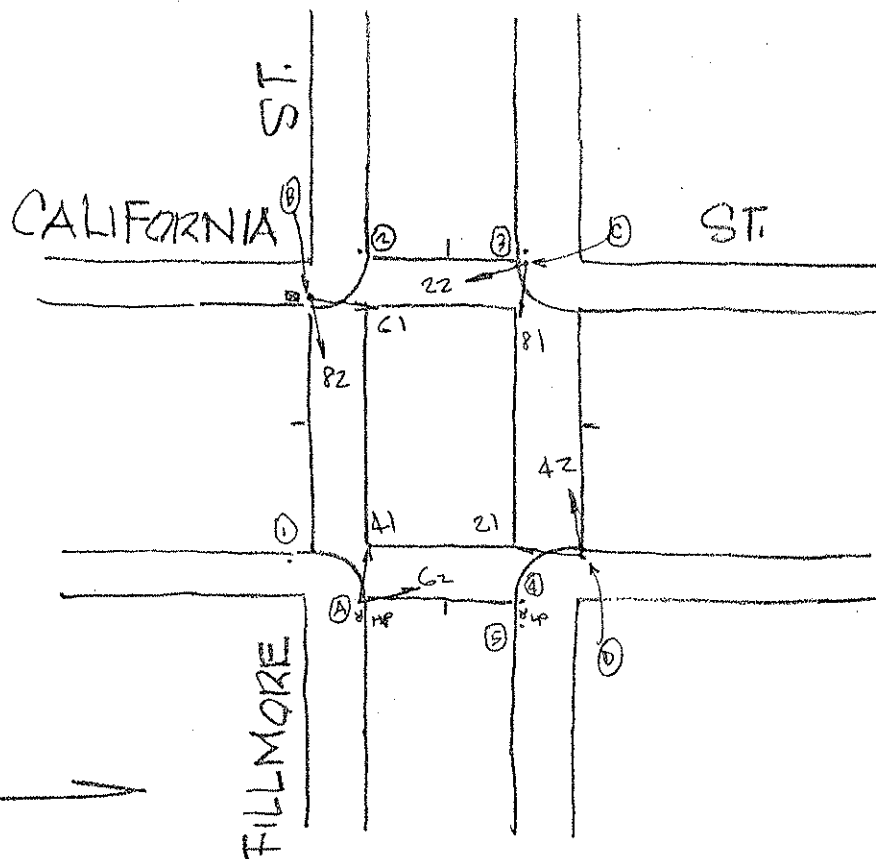

G-15-79

POLE	FUNC.	MAT'L	SIGNAL NO.	MAKE	NO. OF SECT.	SIZE	VISOR	B.P. OR LOUVERS	MOUN'T	PED SIGNAL NO.	LEGEND	MESSAGE		MAKE	MOUN'T
												ELEMENT	COLOR		
A	M	S	62	EC	3	8"	FC 8"	No	S						
B	S	C	41	EC	3	8"	FC 8"	No	S						
C	M	S	82	EC	3	8"	FC 8"	No	T						
D	L	C	61	EC	3	8"	FC 8"	No	T						
			22	EC	3	8"	FC 8"	No	S						
			81	EC	3	8"	FC 8"	No	S						
			42	EC	3	8"	FC 8"	No	S						
			21	EC	3	8"	FC 8"	No	S						
1	U	W													
2	M	S													
3	U	W													
4	M	S													
5	U	W													

CONTROLLER CABINET SIZE : ORDINARY BASE CABINET: YES

COMMENTS :