


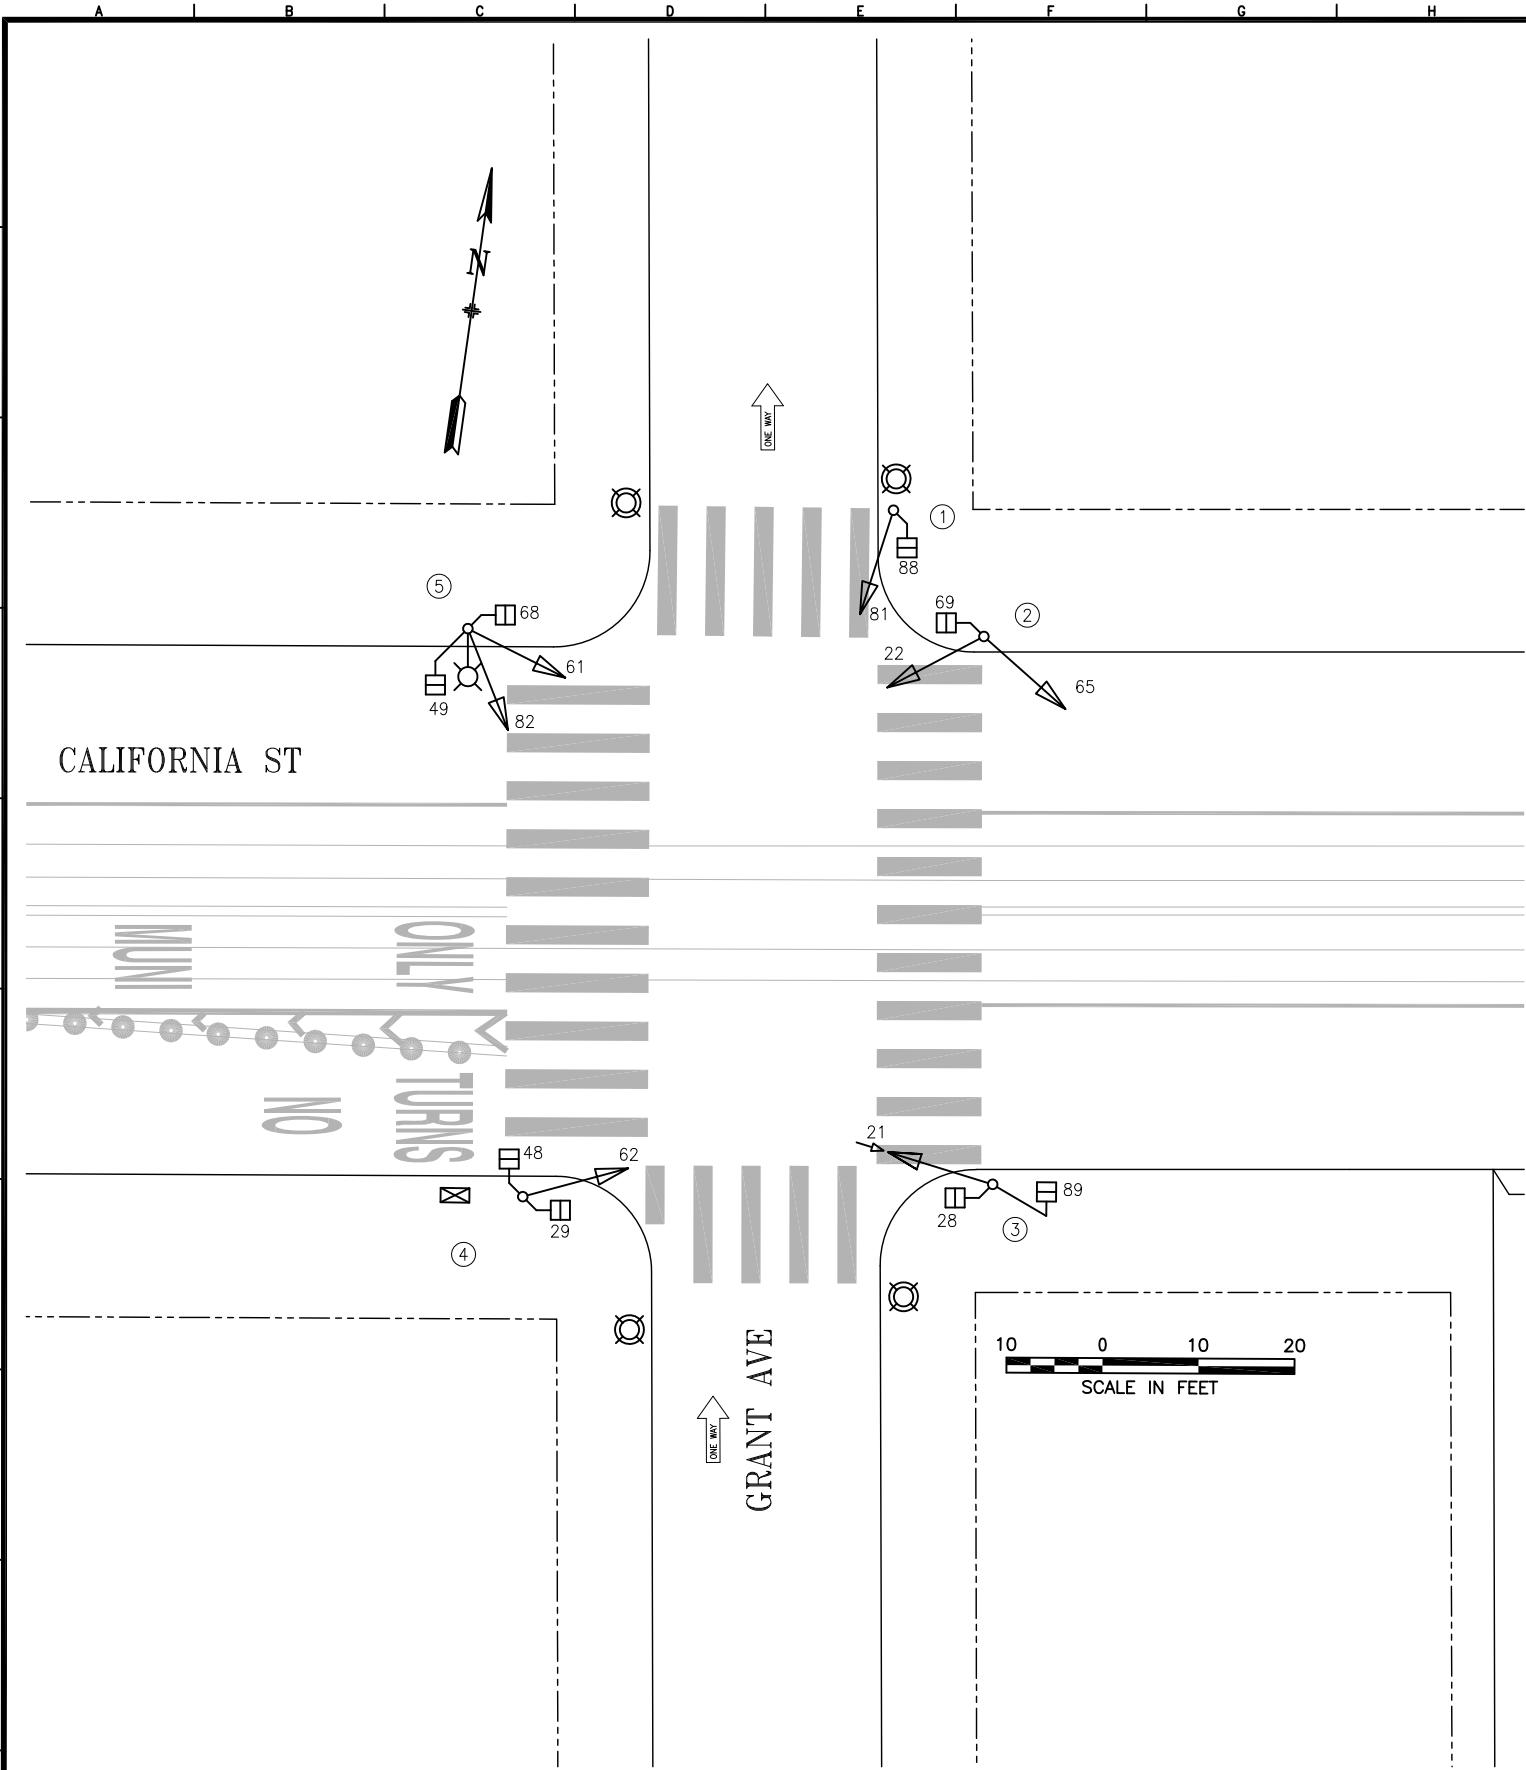

POLE AND EQUIPMENT SCHEDULE										
POLE No.	TYPE OF POLE	VEHICLE SIGNAL					PEDESTRIAN SIGNAL			REMARKS
		No.	TYPE	MOUNTING	VISORS	LOUVERS/BP	No.	TYPE	MOUNTING	
①	PEDESTAL POLE (10')	81	3S12"	TV-1-T	T		88	1S-COUNT	SP-1	
②	UNIQUE PEDESTAL POLE (10')	22 65	3S12" 3S12"	TV-2-T	T T		69	1S-COUNT	SP-1	
③	STREETLIGHT	21	3S12"GSA	SV-1	T		28 89	1S-COUNT 1S-COUNT	SP-2-SF	
④	PEDESTAL POLE (10')	62	3S12"	TV-1-T	T		29 48	1S-COUNT 1S-COUNT	SP-1 SP-1	
⑤	STREETLIGHT	61 82	3S12" 3S12"	SV-2-TC	T T		49 68	1S-COUNT 1S-COUNT	SP-1 SP-1	

Δ	6/7/23	SRC 2023-043: UPGRADE ALL SIGNALS EXCEPT 21 FROM 8 TO 12-INCH	D. YEUNG	G. DE LEON	
Δ	1/5/06	CONVERTED FROM HAND-DRAWN SIGNAL INVENTORY DIAGRAM	D. YEUNG	G. DE LEON	
NO.	DATE	DESCRIPTION	BY	APPROVED	
TABLE OF REVISIONS					
CHECKOUT DRAWING THROUGH THE SID CUSTODIAN FOR THE LATEST REVISION					



SFMTA

DRAWN BY: D. YEUNG	DATE: FEB 2023	SCALE AS SHOWN	TRAFFIC SIGNAL INVENTORY DIAGRAM	CNN NO: 24751000
		SHEET OF SHEETS		REV NO:
		1 OF 1	CALIFORNIA ST AND GRANT AVE	1