




POLE AND EQUIPMENT SCHEDULE											
POLE No.	TYPE OF POLE	LUMINAIRE VOLTAGE/WATTAGE	VEHICLE SIGNAL					PEDESTRIAN SIGNAL			REMARKS
			No.	TYPE	MOUNTING	VISORS	LOUVERS	No.	TYPE	MOUNTING	
①	SL							88 69	1S-COUNT 1S-COUNT	SP-2-SF	
②	STEEL POLE		22 135	3S12" 2S12" LB-	SV-1-T SV-1-T	T T					MOUNT 22 @13'
③	SL		21	3S12"	SV-1-T	T		28	1S-COUNT	SP-1	MOUNT 21 @13'
④	1-B (10')		42	3S12"	TV-1-T	T		89	1S-COUNT	SP-1	
⑤	SL		41 62	3S12" 4S12"G ^{LA}	SV-2-TA	T T		29 48	1S-COUNT 1S-COUNT	SP-2-SF	CCTV CAMERA
⑥	SL		61 131	4S12"G ^{LA} 2S12" LB-	SV-1-T SV-1-T	T T					
⑦	1-B (7')							49 68	1S-COUNT 1S-COUNT	TP-2-T	

4	8/19/21	INSTALL 131 & 135 PER SRC 2021-168. PER FIELD, UPDATE 28 TO POLE 3 & 89 TO POLE 4, ADD CCTV CAMERA TO POLE 5	E. TANG	B. TANNER
3	6/23/21	UPGRADE 21,22 & 42 TO 12-INCH (SRC 2021-173)	D. YEUNG	B. WOO
2	12/9/14	SRC #2012-290 ADDED WBLT	B. WOO	T. FOLKS
1	06/95	SIGNAL MODIFICATION CT22.	C. X. LEUNG	B. WHITEN
NO.	DATE	DESCRIPTION	BY	APPROVED

TABLE OF REVISIONS
CHECKOUT DRAWING THROUGH THE SID CUSTODIAN FOR THE LATEST REVISION

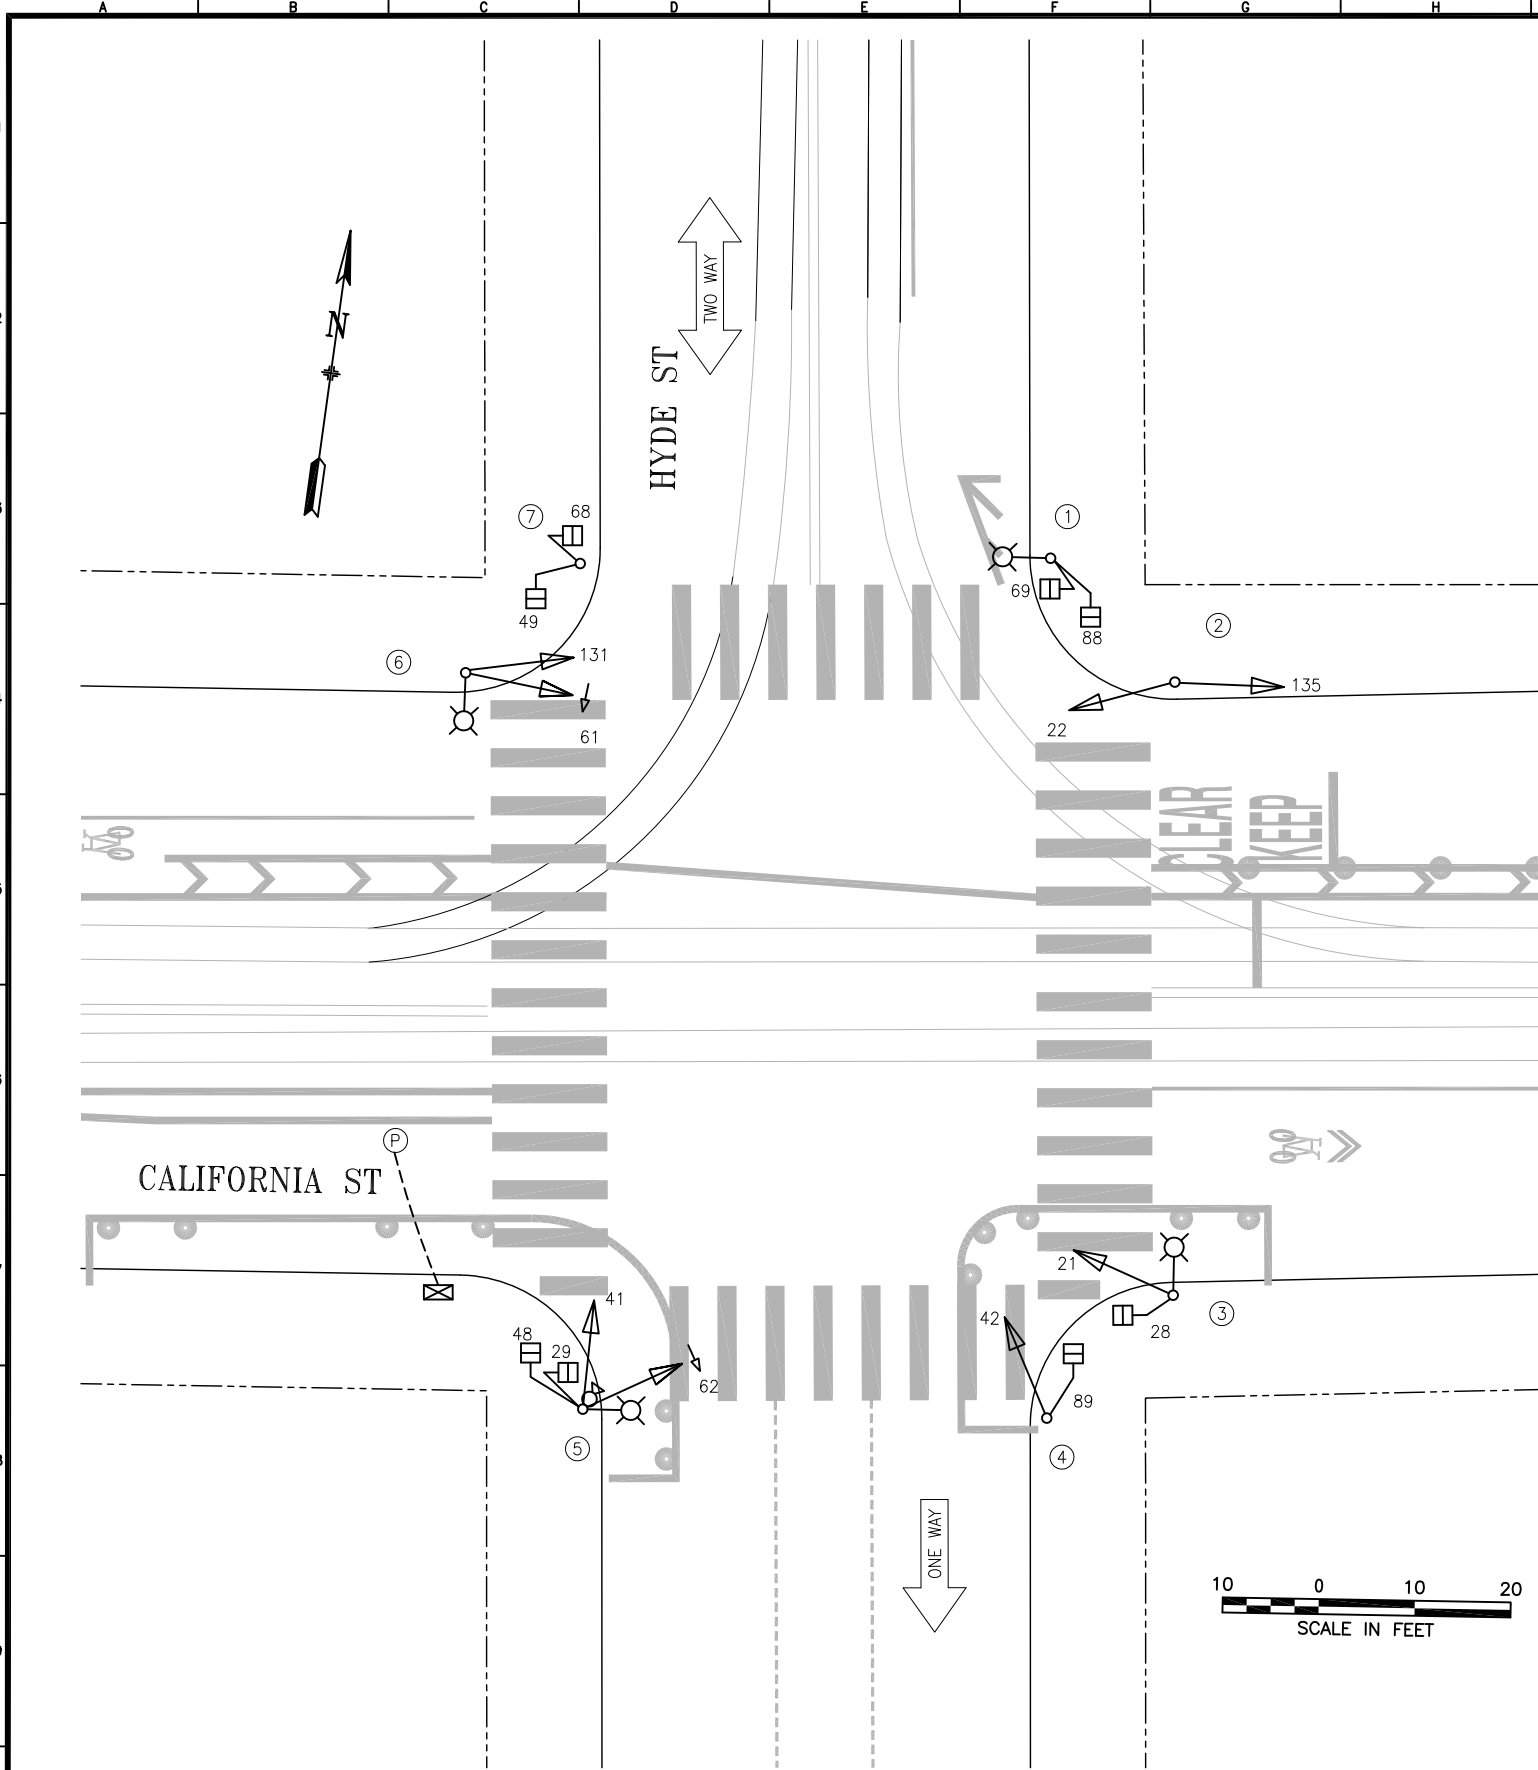

SFMTA

DRAWN BY: CXL	DATE: 07/09/99	SCALE AS SHOWN	TRAFFIC SIGNAL INVENTORY DIAGRAM	CNN NO: 25252000
CHECKED BY:	DATE:	SHEET OF SHEETS 1 OF 1	CALIFORNIA ST & HYDE ST	REV NO: 4

EXTERNAL REFERENCE: 054022.dwg
FONTS USED: ROMANS.SHX romans ROMANS.shx
SCALE: PLOT: 1"=1'
PLOT SCALE: 1"=1'
ORIGIN: SECTION
FILE NAME: California_Pole.dwg
DATE: Aug 24 2000 11:44