


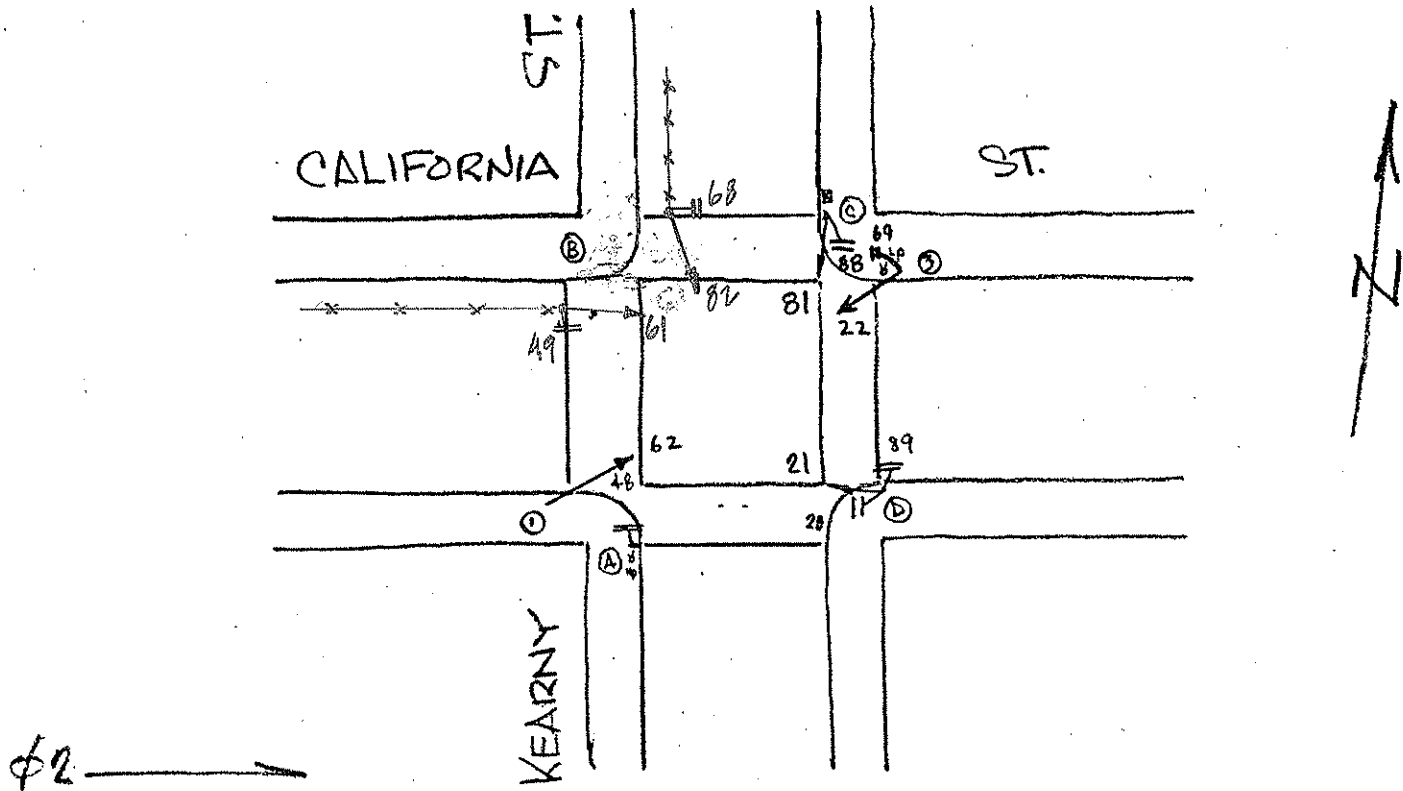

10/5/89
1-2-85

POLE	FUNC.	MAT'L	SIGNAL NO.	MAKE	NO. OF SECT.	SIZE	VISOR	B.P. OR LOUVERS	MOUN'T	PED SIGNAL NO.	LEGEND	MESSAGE		MAKE	MOUN'T
												ELEMENT	COLOR		
A	L	S	62	EC	3	8"	FL 12"	No	S	29	I	IS-1	W/OR	ICC	S
B	L	S	82	EC	3	8"	FL 8"	No	S	48	I	IS-1	W/OR	ICC	S
C	L	S	61	EC	3	8"	FL 8"	No	S	49	I	IS-1	W/OR	ICC	S
D	L	S	22	EC	5	8" R.Y.G 12" Y-G	FL 8" FL 12"	No	S	68	I	IS-1	W/OR	ICC	S
			81	EC	3	8"	FL 12"	No	S	69	I	IS-1	W/OR	ICC	S
1	S	S	21	EC	5	8" R.Y.G 12" Y-G	FL 8" FL 12"	No	S	88	I	IS-1	W/OR	ICC	S
3	S	S								89	I	IS-1	W/OR	ICC	S
										28	I	IS-1	W/OR	ICC	S

CONTROLLER CABINET SIZE : LARGE BASE CABINET: 1000

COMMENTS: Relocated signal to Fence and Light pole to Fence