


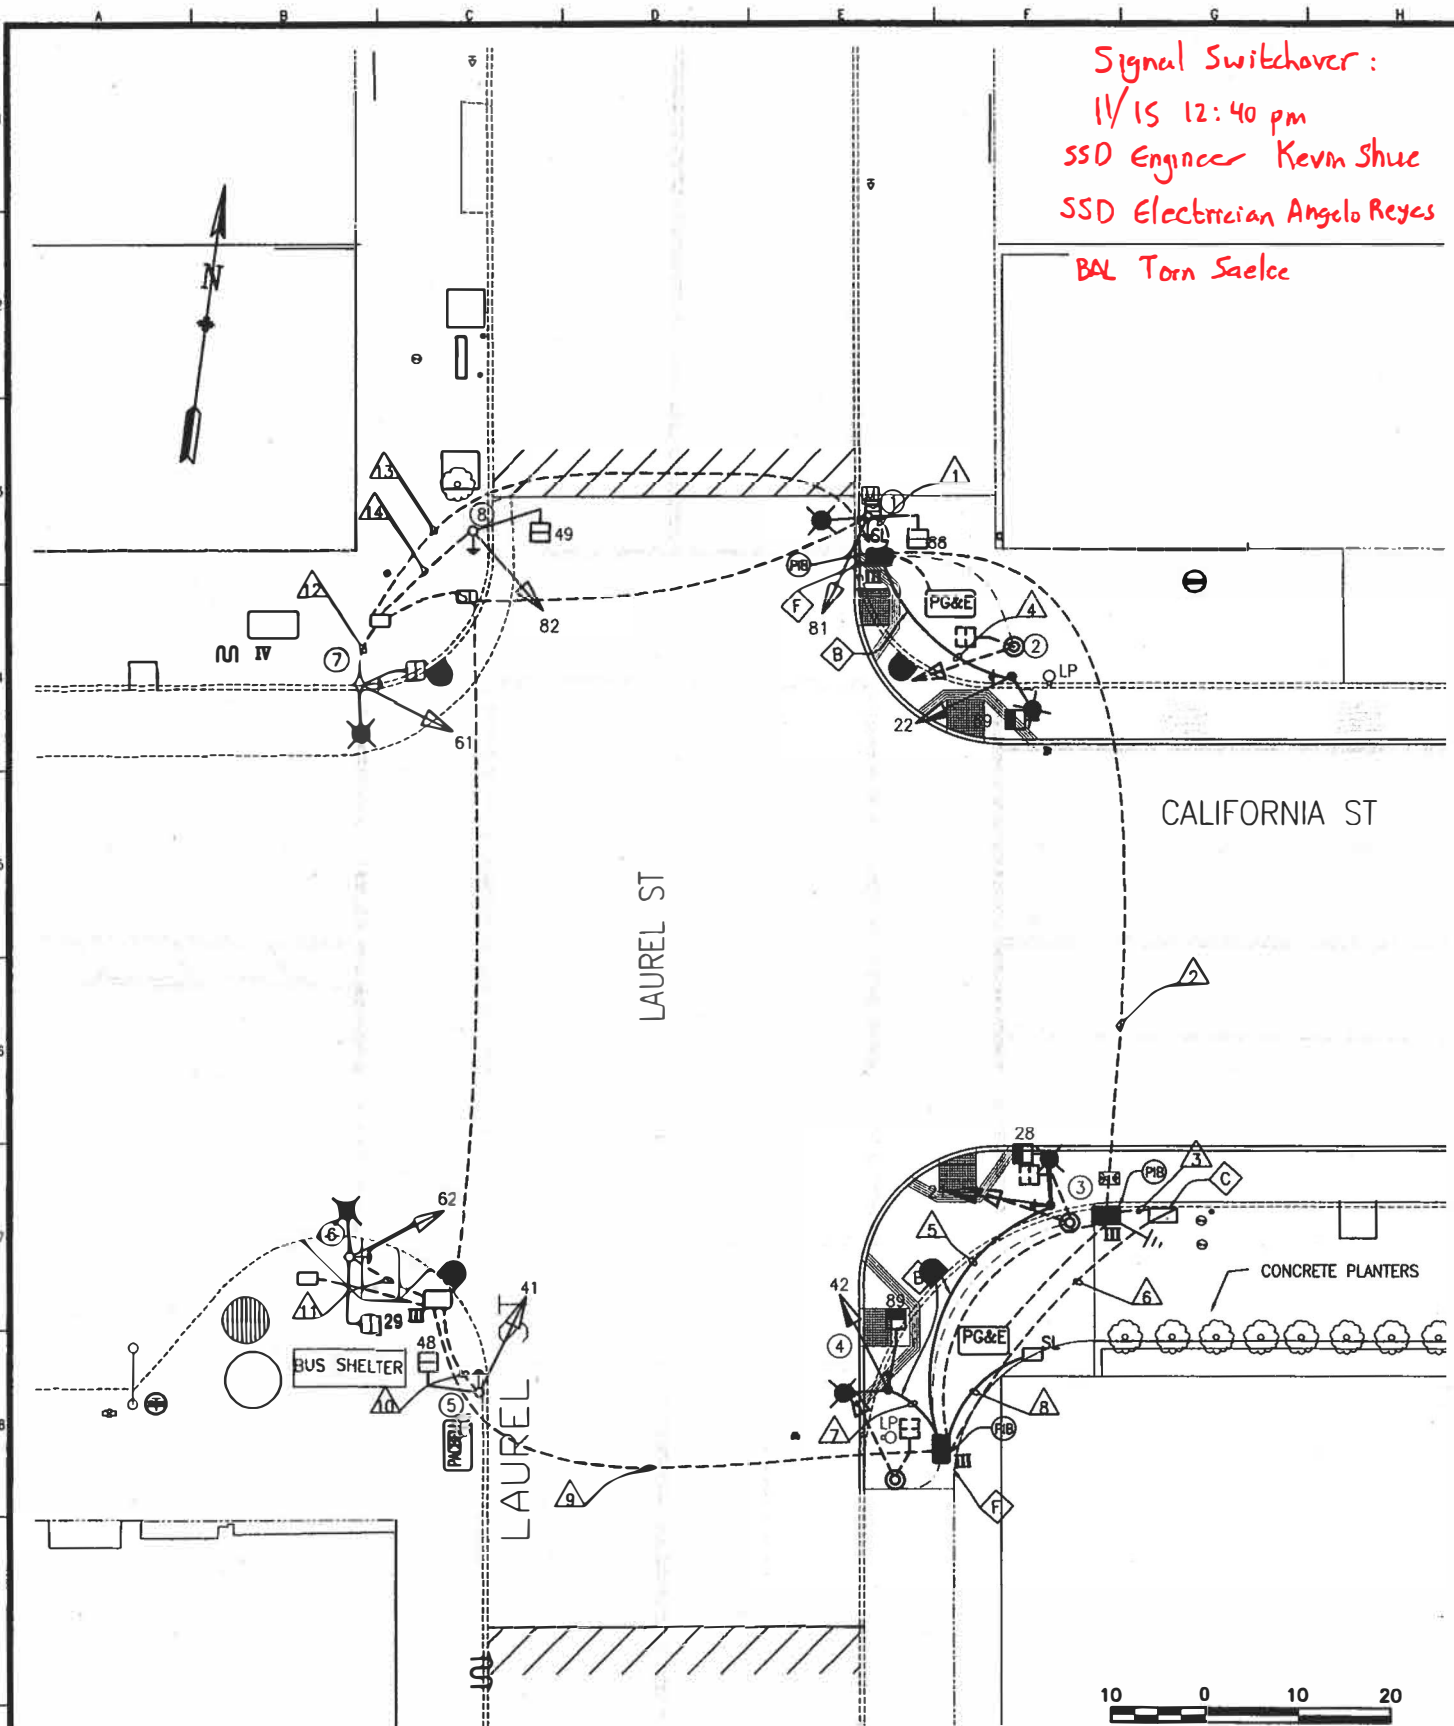


Signal Switchover:
11/15 12:40 pm
SSD Engineer Kevin Shue
SSD Electrician Angelo Reyes
BAL Torn Saelce

POLE AND EQUIPMENT SCHEDULE											
POLE No.	TYPE OF POLE	LUMINAIRE VOLTAGE/ WATTAGE	VEHICLE SIGNAL					PEDESTRIAN SIGNAL			REMARKS 
			No.	TYPE	MOUNTING	VISORS	LOUVERS	No.	TYPE	MOUNTING	
①	SL (MARBELITE W/ WIDE BASE)		81	3S12"	SV-1-T	T		88	1S-COUNT	SP-1	APS
②	CITY STANDARD STREETLIGHT W/ 6' LUMINAIRE ARM		22	3S12"	SV-1-T	T		89	1S-COUNT	SP-1	APS
③	CITY STANDARD STREETLIGHT W/ 6' LUMINAIRE ARM		21	3S12"	SV-1-T	T		28	1S-COUNT	SP-1	APS
④	CITY STANDARD STREETLIGHT W/ 6' LUMINAIRE ARM		42	3S12"	SV-1-T	T		89	1S-COUNT	SP-1	APS
⑤	1-A (10')		41	3S12"	TV-1-T	T		48	1S-COUNT	SP-1	APS
⑥	SL (MARBELITE W/ WIDE BASE)		62	3S12"	SV-1-T	T		29	1S-COUNT	SP-1	APS
⑦	MUNI W/ SL		61	3S12"	SV-1-T	T		68	1S-COUNT	SP-1	APS
⑧	1-A (10')		82	3S12"	TV-1-T	T		49	1S-COUNT	SP-1	APS

- SHEET NOTES:**
- ⬠ CUT CONDUIT ENDS 1-FOOT BELOW GRADE; CAP ENDS ABANDON IN PLACE AFTER CUT OVER TO (N) TRAFFIC SIGNALS.
 - ⬠ F/1 1-2" GRS CONDUIT WITH 3#14 WIRES FOR VEHICLE SIGNAL, 2#14 WIRES FOR PEDESTIAN SIGNAL AND 2#10 WIRES FOR STREETLIGHT. RECONNECT NEW SIGNAL WIRES BACK TO IC CABINET.
 - ⬠ ADJUST CABINET FOUNDATION HEIGHT TO LEVEL WITH NEW SIDEWALK SURFACE.
 - ⬠ CITY FORCES TO INSTALL CITY FURNISHED APS BUTTONS ON POLES AS SHOWN ON INTERSECTION DRAWING AND AS INDICATED ON POLE & EQUIPMENT SCHEDULE. CONTRACTOR TO F/1 APS WIRING, AND ROUTE BACK TO MSF CABINET.
 - ⬠ REMOVE AND REPLACE EXISTING FIXTURE WITH NEW LED FIXTURE. SEE LIGHTING FIXTURES SCHEDULE IN ET-0.1
 - ⬠ SPLICE NEW STREETLIGHTS AND PROVIDE A 10A FUSE FOR EACH STREETLIGHT

PHASE DIAGRAM

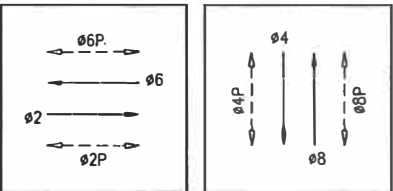

<table><tr><td>NO.</td><td>DATE</td><td>DESCRIPTION</td><td>BY</td><td>APP.</td></tr><tr><td colspan="5">TABLE OF REVISIONS</td></tr></table>	NO.	DATE	DESCRIPTION	BY	APP.	TABLE OF REVISIONS					REFERENCE INFORMATION & FILE NO. OF SURVEYS				DESIGN & ENGINEERING CITY & COUNTY OF SAN FRANCISCO SAN FRANCISCO PUBLIC WORKS 30 VAN NESS AVENUE, 5TH FLOOR SAN FRANCISCO, CA 94102 • 6028		Section Mgr: PHILIP THWIN Deputy Division Mgr: IQBALBHAU DHAPA Division Mgr: PATRICK RIVERA	Date: 5/19/17 5/22/17 5/23/17	DESIGNED: DATE: 3/2017 LV/CL/CF DRAWN: DATE: 3/2017 LV/CL/CF CHECKED: DATE: 5/2017 KK/SL		SCALE: AS SHOWN SHEET OF SHEETS 53 OF 65	CALIFORNIA LAUREL VILLAGE IMPROVEMENT PROJECT CALIFORNIA ST. AND LAUREL ST. TRAFFIC SIGNAL MODIFICATION WORK	CONTRACT NO. 2300J DRAWING NO. ET-3.0 FILE NO. 107,617 REV. NO.
NO.	DATE	DESCRIPTION	BY	APP.																			
TABLE OF REVISIONS																							

