


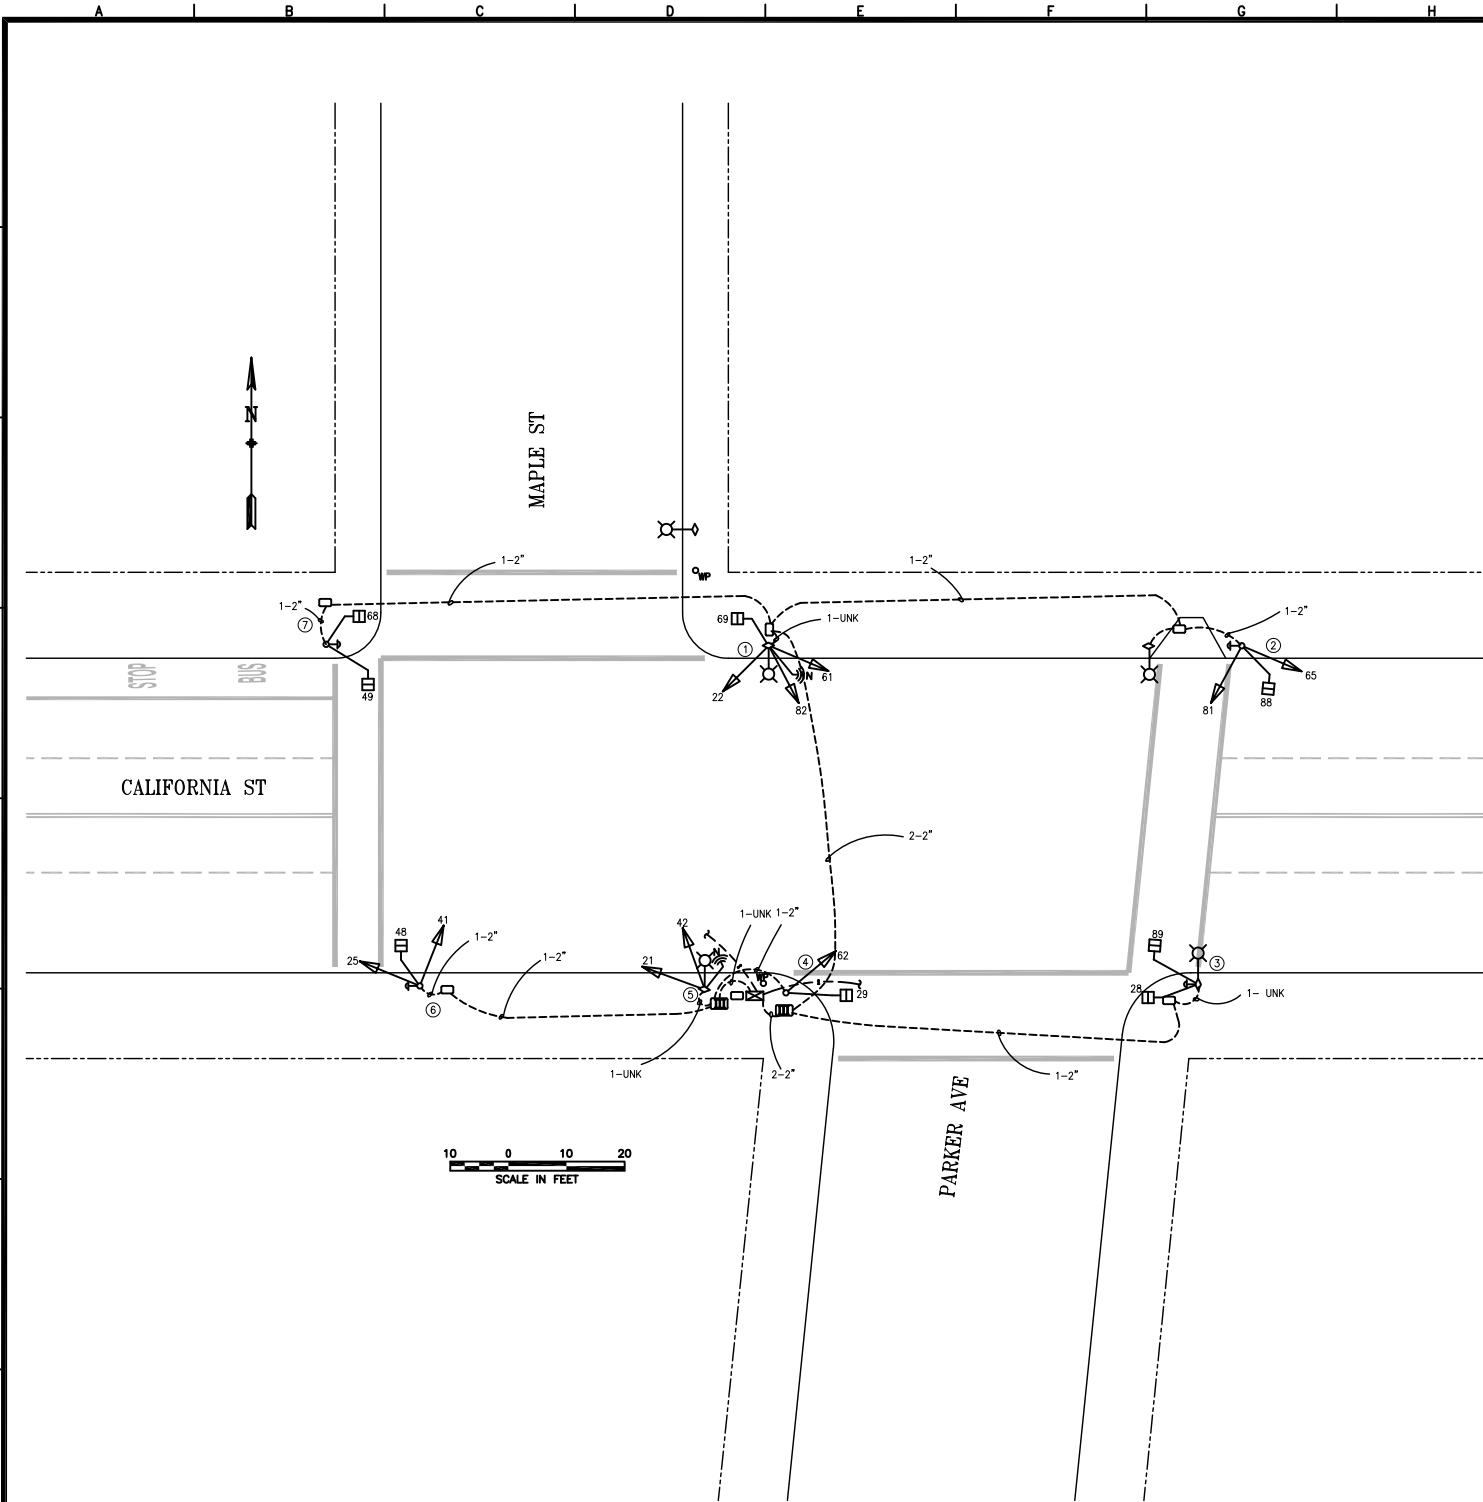

POLE AND EQUIPMENT SCHEDULE										
POLE No.	TYPE OF POLE	VEHICLE SIGNAL					PEDESTRIAN SIGNAL			REMARKS
		No.	TYPE	MOUNTING	VISORS	LOUVERS	No.	TYPE	MOUNTING	
①	EX MUNI / SL	22 61 82	3S12" 3S12" 3S12"	SV-3-TA	T T T		69	1S-COUNT	SP-1	NETWORK RADIO
②	1-A (10')	65 81	3S12" 3S12"	TV-2-T -SF	T T		88	1S-COUNT	SP-1	PPB
③	EX MUNI / SL						28 89	1S-COUNT 1S-COUNT	SP-1 SP-1	PPB
④	1-A (10')	62	3S12"	TV-1	T		29	1S-COUNT	SP-1	
⑤	EX MUNI / SL	21 42	3S12" 3S12"	SV-2-TC	T T					NETWORK RADIO
⑥	1-A (10')	25 41	3S12" 3S12"	TV-2-T	T T		48	1S-COUNT	SP-1	PPB
⑦	1 - A (7')						49 68	1S-COUNT 1S-COUNT	TP-2-T @ 90 DEGREES	PPB

2	08/15/23	PER SRC 2023-088, UPGRADE SIGNALS 22, 82, 42, 25, AND 41 TO 3S12"	S.QIN	A.LAM	
1	06/12/13	UPGRADE SIGNAL 62, 65, AND 81 FROM 3S8" TO 3S12"	C.WONG	B.WOO	
0	11/04/04	SIGNAL UPGRADE BY 0436J; CONVERTED FROM CONTRACT PLAN	E.TSUI	H.QUAN	
NO.	DATE	DESCRIPTION	BY	APPROVED	
TABLE OF REVISIONS					
CHECKOUT DRAWING THROUGH THE SID CUSTODIAN FOR THE LATEST REVISION					



SFMTA

DRAWN BY:	DATE:
C. WONG	03/17/2016
CHECKED BY:	DATE:
B. WOO	03/17/2016

SCALE
AS SHOWN
SHEET OF SHEETS
1 OF 1

TRAFFIC SIGNAL INVENTORY DIAGRAM
CALIFORNIA ST, MAPLE ST, AND PARKER AVE

CNN NO:
26948000
REV NO:
2