


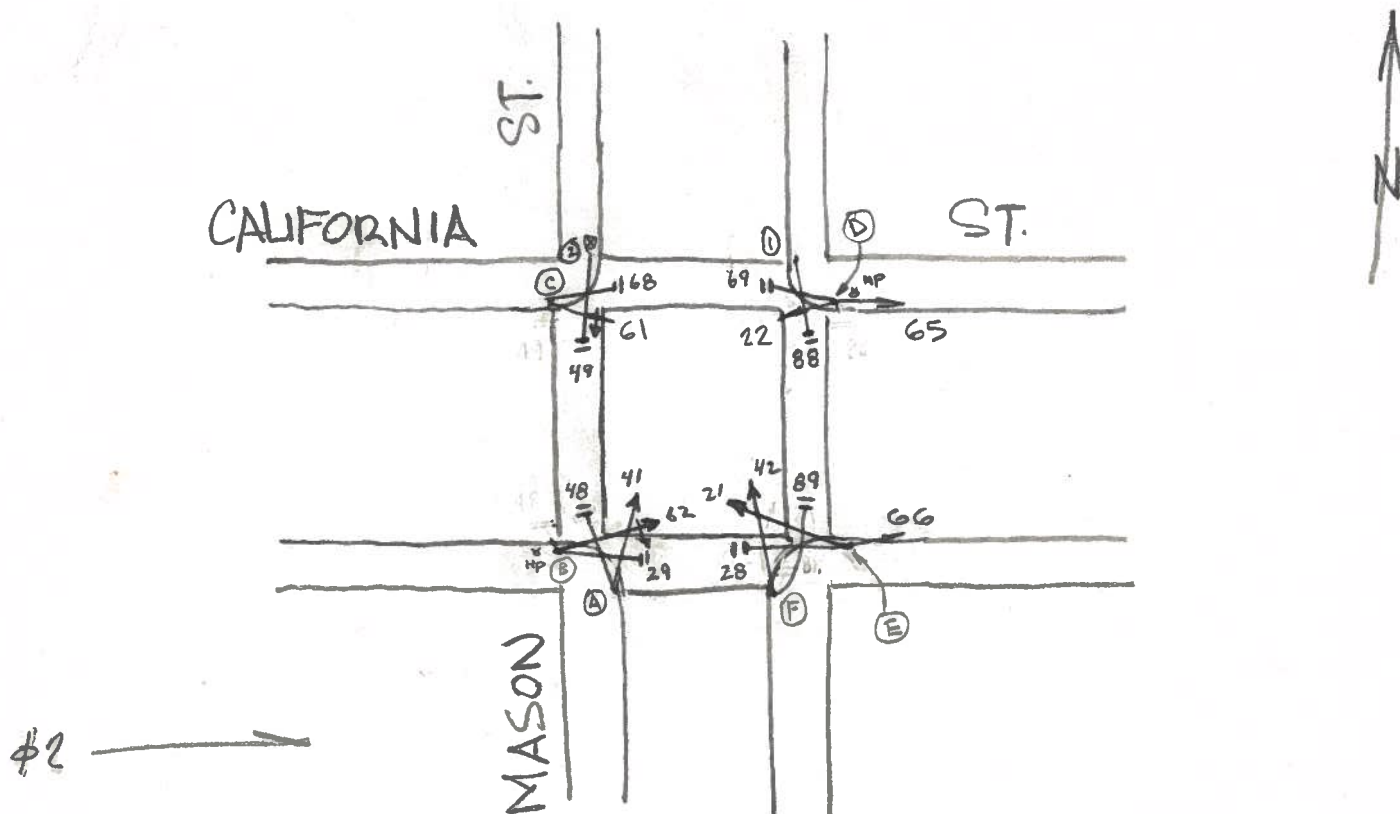

12-03-18

POLE	FUNC.	MAT'L	SIGNAL NO.	MAKE	NO. OF SECT.	SIZE	VISOR	B.P. OR LOUVERS	MOUN'T	PED SIGNAL NO.	LEGEND	MESSAGE		MAKE	MOUN'T
												ELEMENT	COLOR		
A	L	S	41	EC	3	8"	FL 8"	NO	S	48	I	IS-1	OR/W	ICC	S
B	S	S	62	EC	4	12" RYG+GA	FC 8"	NO	T	49	I	IS-1	OR/W	ICC	T
C	L	S	61	EC	4	12" RYG+GA	FC 8"	NO	S	88	I	IS-1	OR/W	ICC	S
D	S	S	22	EA	4	12" RYG+GA	FC 8"	NO	T	89	DW/W	IS-1	OR/W	ICC	S
E	L	S	65	EA	3	12"	FL 8"	NO	T	68	I	IS-1	OR/W	ICC	S
F	S	S	66	EA	3	12"	FL 8"	NO	S	69	DW/W	IS-1	OR/W	ICC	S
			21	EA	4	12" RYG+GA	FC 8"	NO	S	28	I	IS-1	OR/W	ICC	S
			42	EA	3	8"	FL 8"	NO	T	29	DW/W	IS-1	OR/W	ICC	S
1	L	S													
2	S	S													

CONTROLLER CABINET SIZE : ORDINARY BASE CABINET: YES

COMMENTS: 65 & 66 CHANGED TO 12" T HEADS SRC 17-404 (EO)

62 61 22 21 UPDATED PER FIELD CONDITIONS