


CALIFORNIA & MONTGOMERY

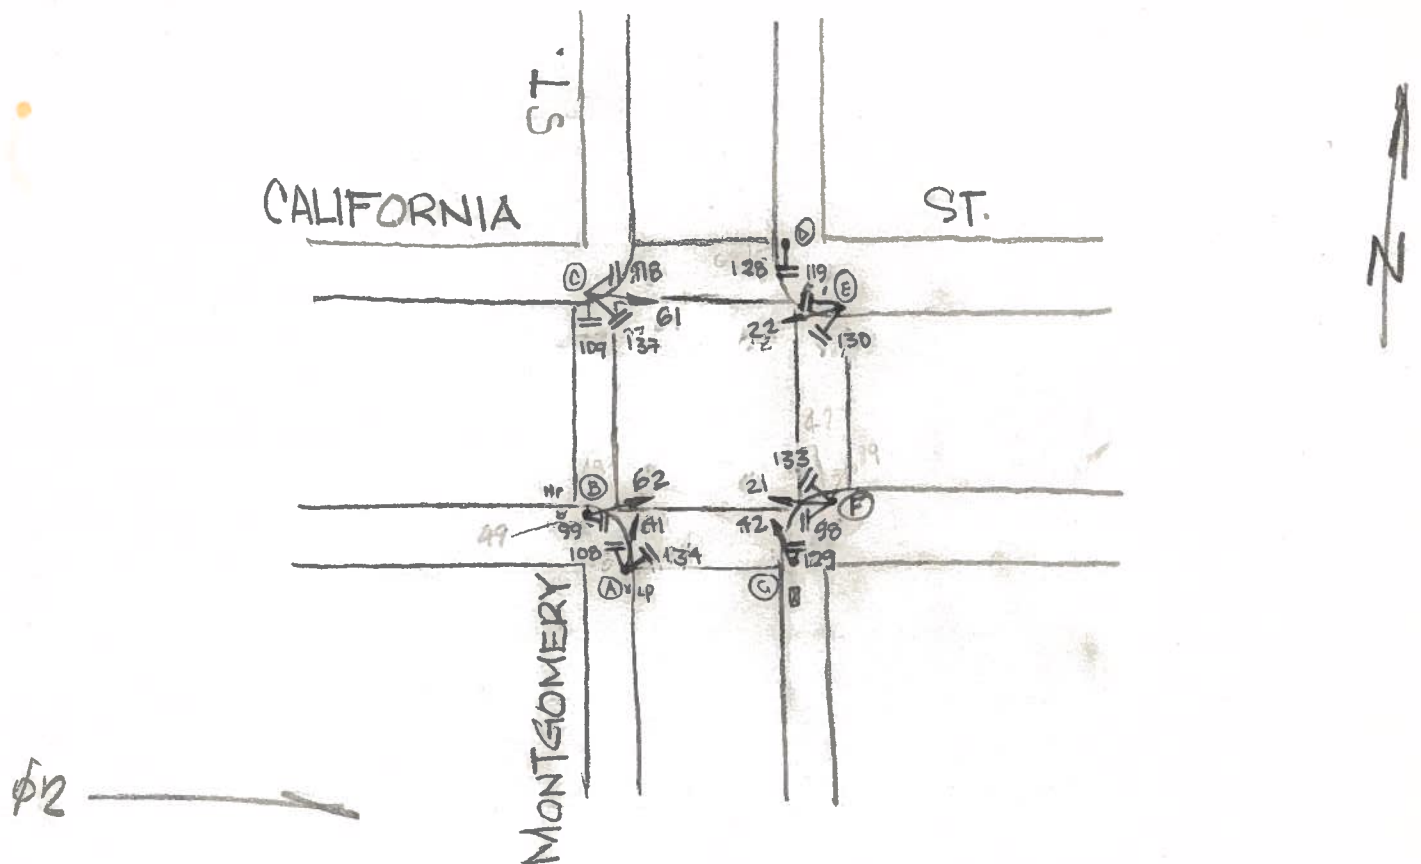

09/29/2019

POLE	FUNC.	MAT'L	SIGNAL NO.	MAKE	NO. OF SECT.	SIZE	VISOR	B.P. OR LOUVERS	MOUN'T	PED SIGNAL NO.	LEGEND	MESSAGE		MAKE	MOUN'T
												ELEMENT	COLOR		
A	L	S	21	EC	3	8"	FL 8"	NO	S	98	COUNT	IS	W/OR	100	S
B	S	S	22	EC	3	8"	FL 12"	NO	TV-1	99	COUNT	IS	W/OR	100	SP-1
C	L	S	41	GA	3	8"	FL 8"	NO	S	108	COUNT	IS	W/OR	100	S
D	L	S	42	EC	3	8"	FL 8"	NO	TV-1	109	COUNT	IS	W/OR	100	S
E	S	S	61	EC	3	8"	FL 12"	NO	S	118	COUNT	IS	W/OR	100	S
F	L	S	62	EC	3	8"	FL 8"	NO	TV-1	119	COUNT	IS	W/OR	100	S
G	S	S			3	8"	FL	NO		128	COUNT	IS	W/OR	100	SP-1
					3	8"	FL	NO		129	COUNT	IS	W/OR	100	SP-1
										130	COUNT	IS	W/OR	100	S
										133	COUNT	IS	W/OR	100	S
										134	COUNT	IS	W/OR	100	S
										137	COUNT	IS	W/OR	100	S

CONTROLLER CABINET SIZE : MSFINARY BASE CABINET : NO

COMMENTS : NOMA - SOMA RETIMING : UPDATE PED PHASE LABEL (SRC 2019-201)
 UPDATE VEH PHASE LABEL AS PER TIMING CARD

- C. SKERRIT 09/29/2019