


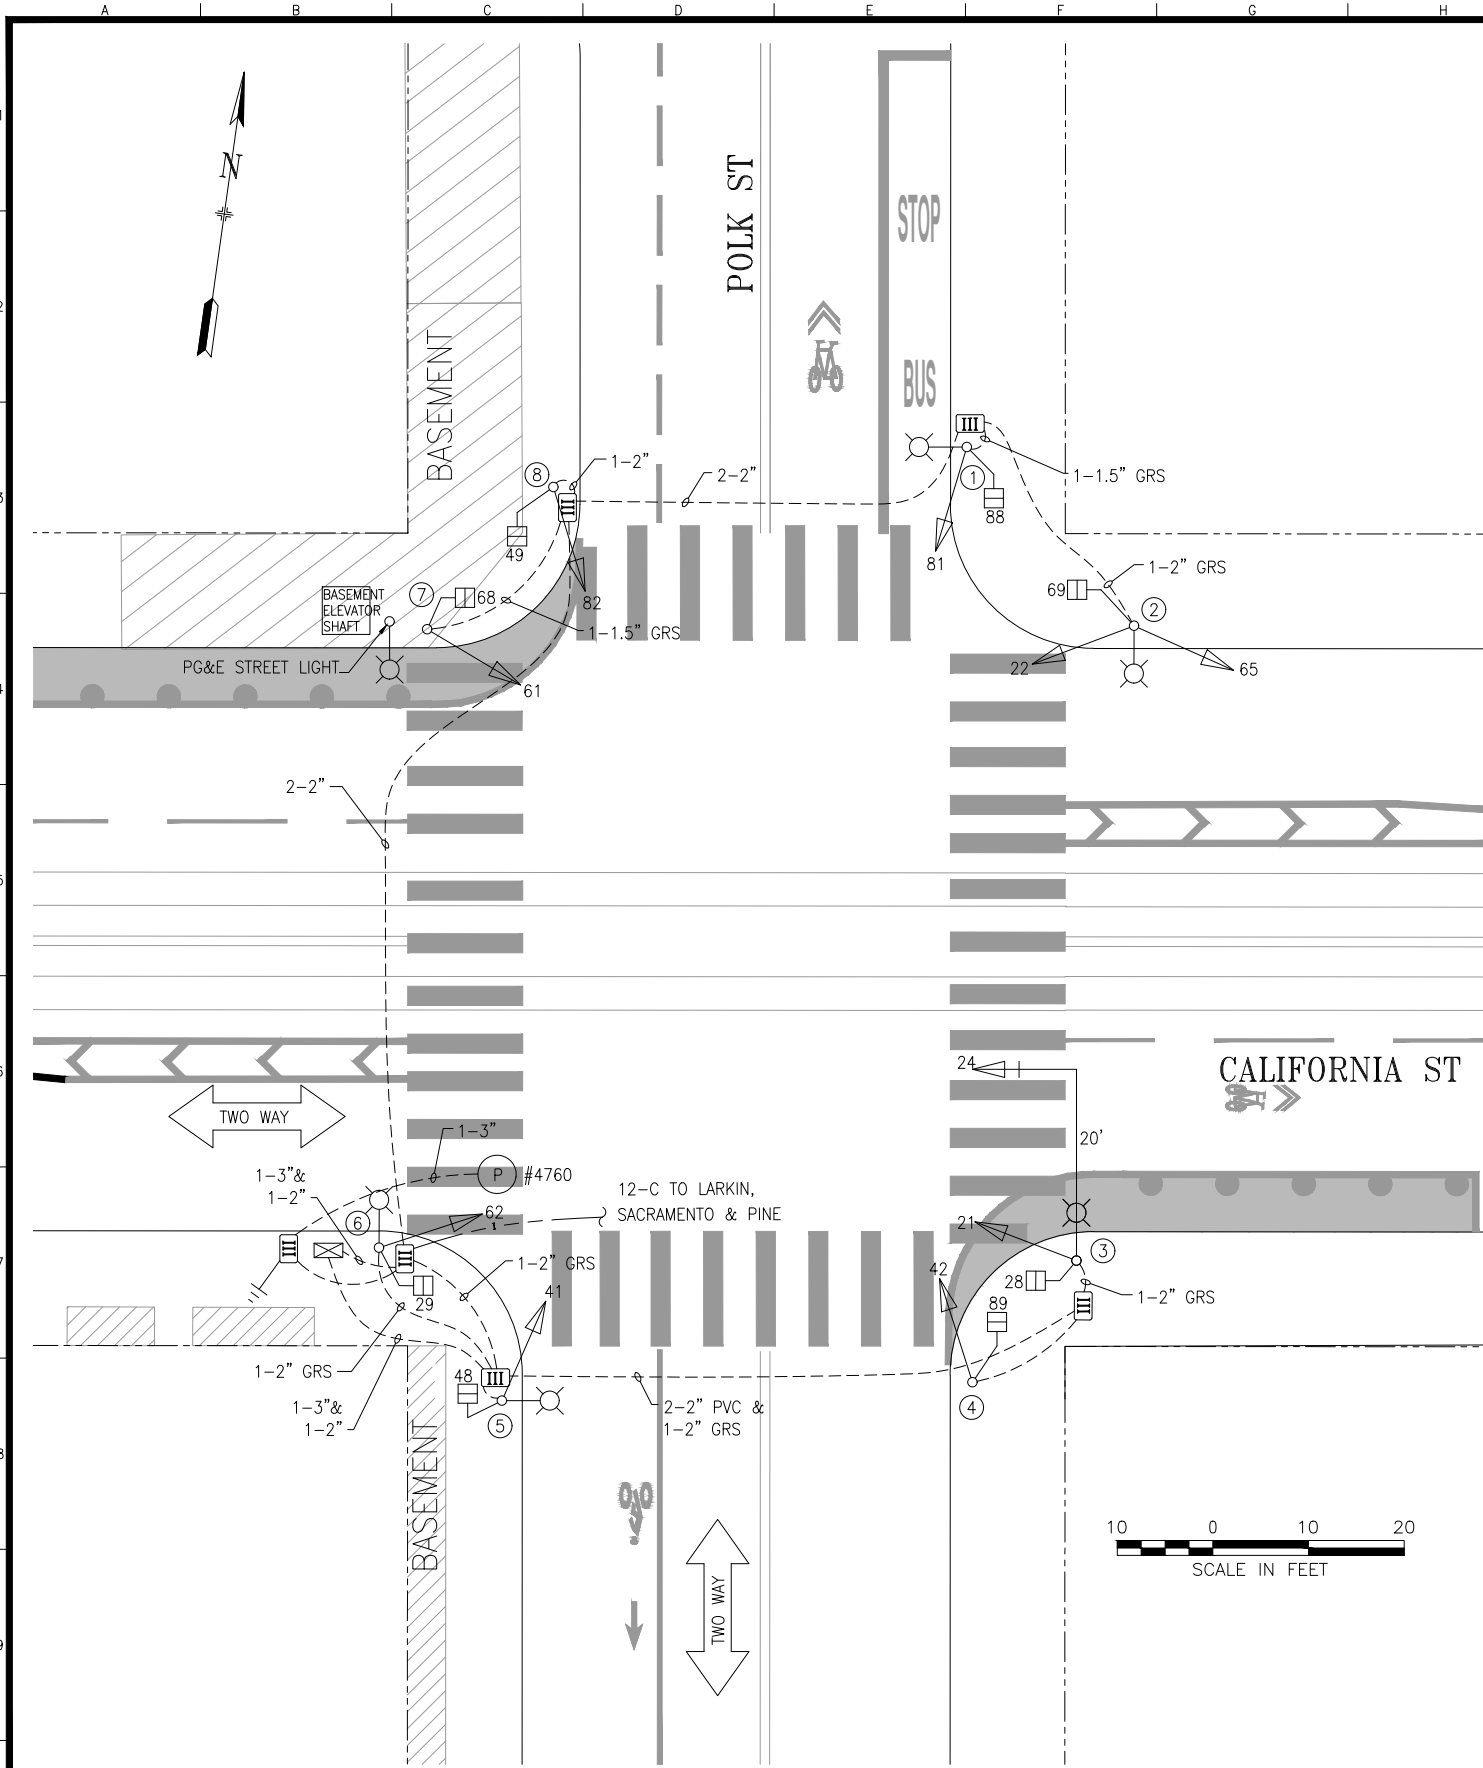

POLE AND EQUIPMENT SCHEDULE										
POLE No.	TYPE OF POLE	LUMINAIRE VOLTAGE/WATTAGE	VEHICLE SIGNAL					PEDESTRIAN SIGNAL		
			No.	TYPE	MOUNTING	VISORS	LOUVERS	No.	TYPE	MOUNTING
①	ORNAMENTAL STREET LIGHT		81	3S12"	SV-1-T	T		88	1S-COUNT	SP-1
②	CITY STANDARD STREET LIGHT	200W	22 65	3S12" 3S12"	SV-2-TA	T T		69	1S-COUNT	SP-1
③	17-2-100 W/ 20' MAST ARM & 6' LUMINAIRE ARM	200W	21 24	3S12" 3S12"	SV-1-T MAS	T T		28	1S-COUNT	SP-1
④	1-A (10')		42	3S12"	TV-1-T	T		89	1S-COUNT	SP-1
⑤	ORNAMENTAL STREET LIGHT		41	3S12"	SV-1-T	T		48	1S-COUNT	SP-1
⑥	CITY STANDARD STREET LIGHT	200W	62	3S12"	SV-1-T	T		29	1S-COUNT	SP-1
⑦	MARBELITE (10')		61	3S12"	TV-1-T	T		68	1S-COUNT	SP-1
⑧	1-A (10')		82	3S12"	TV-1-T	T		49	1S-COUNT	SP-1

0	8/3/17	FULL UPGRADE BY 2586J; CONVERTED FROM AS-BUILTS	JH	GD	
NO.	DATE	DESCRIPTION	BY	APP.	
TABLE OF REVISIONS					
CHECK WITH TRACING TO SEE IF YOU HAVE LATEST REVISION					

REFERENCE INFORMATION & FILE NO. OF SURVEYS



SAN FRANCISCO MUNICIPAL TRANSPORTATION AGENCY

CITY AND COUNTY OF SAN FRANCISCO

		SCALE:	AS SHOWN	TRAFFIC SIGNAL INVENTORY DIAGRAM	CNN NO. 25221000
DRAWN: JH	DATE: 4/2018			SHEET OF SHEETS 01 OF 01	REV NO. 0
CHECKED: GD	DATE: 4/2018			CALIFORNIA STREET AND POLK STREET	