


CALIF. & POWELL

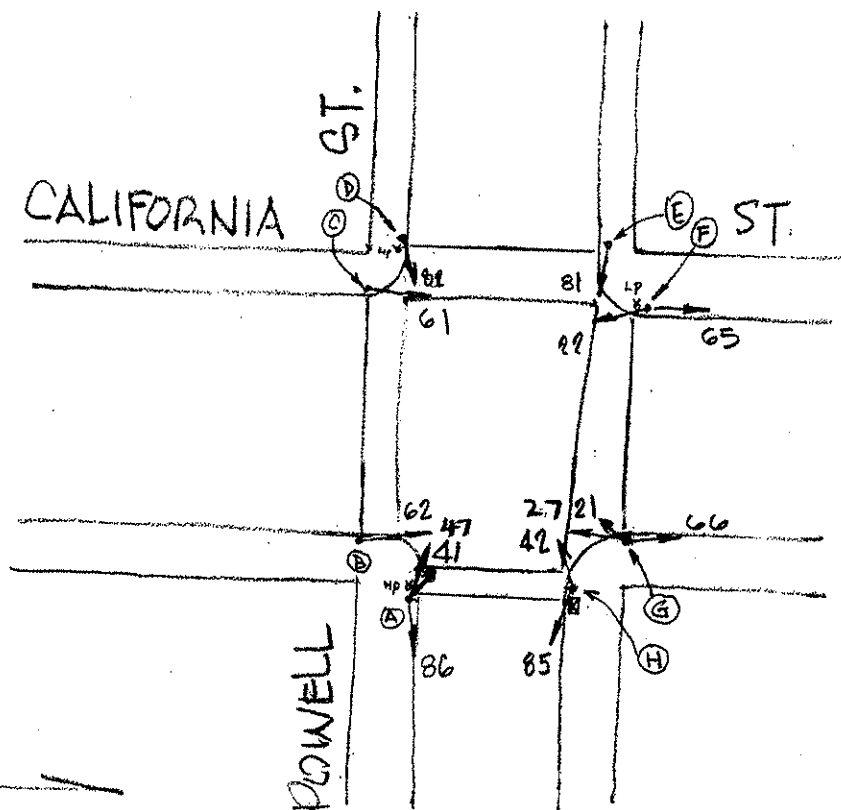

42

9/13/04

POLE	FUNC.	MAT'L	SIGNAL NO.	MAKE	NO. OF SECT.	SIZE	VISOR	B.P. OR LOUVERS	MOUN'T	PED SIGNAL NO.	LEGEND	MESSAGE		MAKE	MOUN'
												ELEMENT	COLOR		
A	L	S	86		1	12" R	T	NO	S						
B	S	S	41		1	12" R	T	NO	S						
C	L	S	62		1	12" R	T	NO	T						
D	S	S	61		1	12" R	T	NO	S						
E	L	S	82		1	12" R	T	NO	T						
F	S	S	81		1	12" R	T	NO	S						
G	L	S	22		1	12" R	T	NO	T						
H	S	S	65		1	12" R	T	NO	S						
			21		1	12" R	T	NO	S						
			66		1	12" R	T	NO	S						
			42		1	12" R	T	NO	T						
			85		1	12" R	T	NO	T						
			27	EC	2	8" Rx, Gx	FC 8"	NO	S						
			47	EC	2	8" Rx, Gx	FC 8"	NO	S						

CONTROLLER CABINET SIZE : LARGE BASE CABINET:

COMMENTS :