


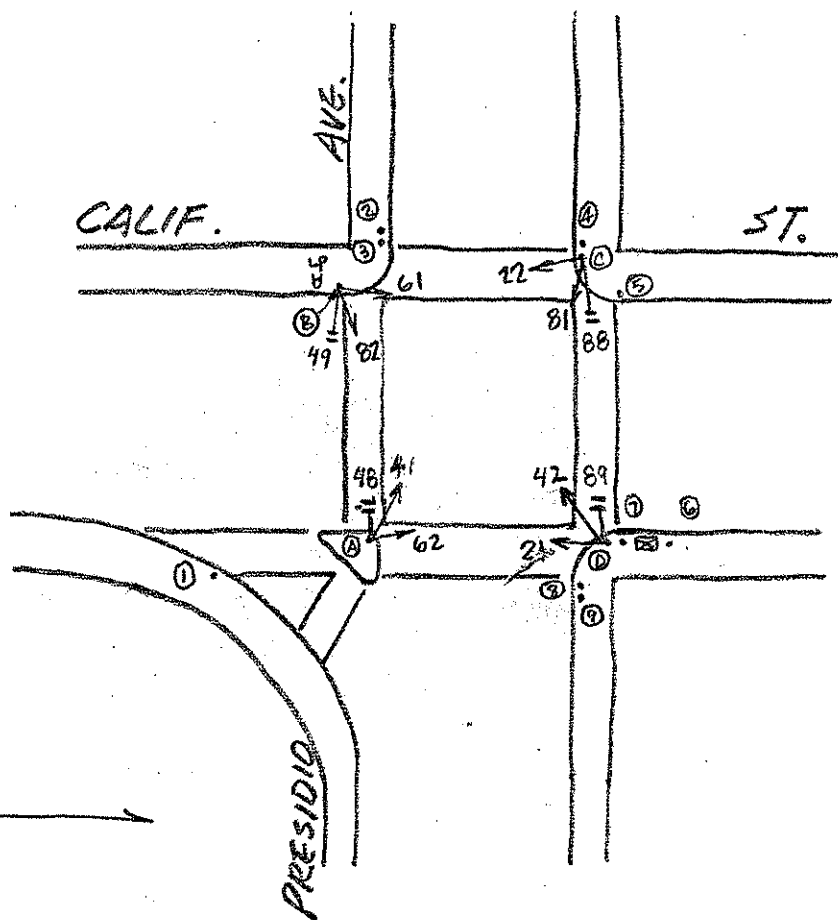

1-29-85

POLE	FUNC.	MAT'L	SIGNAL NO.	MAKE	NO. OF SECT.	SIZE	VISOR	B.P. OR LOUVERS	MOUN'T	PED SIGNAL NO.	LEGEND	MESSAGE		MAKE	MOUN'T
												ELEMENT	COLOR		
A	S	C	62	GA	3	8"	FC 8"	NO	T	48	I	IS-1	OR/W	ICC	S
B	S	C	41	GA	4	8" R.Y.G. 12" G →	FC 9" FC 12"	NO	T	49	I	IS-1	OR/W	ICC	S
C	S	C	82	EC	4	8" R.Y.G. 12" G →	FC 12"	NO	T	88	I	IS-1	OR/W	ICC	S
D	S	C	61	ED	3	8"	FC 12"	NO	T	89	I	IS-1	OR/W	ICC	S
			22	GA	3	8"	FC 8"	NO	T						
			81	GA	4	8" R.Y.G. 12" G →	FC 8" FC 12"	NO	T						
1	L	S	42	EC	4	8" R.Y.G. 12" G →	FC 12"	NO	T						
2	U	W	21	EC	3	8"	FC 12"	NO	T						
3	M	S													
4	L	S													
5	M	S													
6	M	S													
7	U	W													
8	U	W													
9	M	S													

CONTROLLER CABINET SIZE : LARGE BASE CABINET : NO

COMMENTS :