


CALIF. & SCOTT

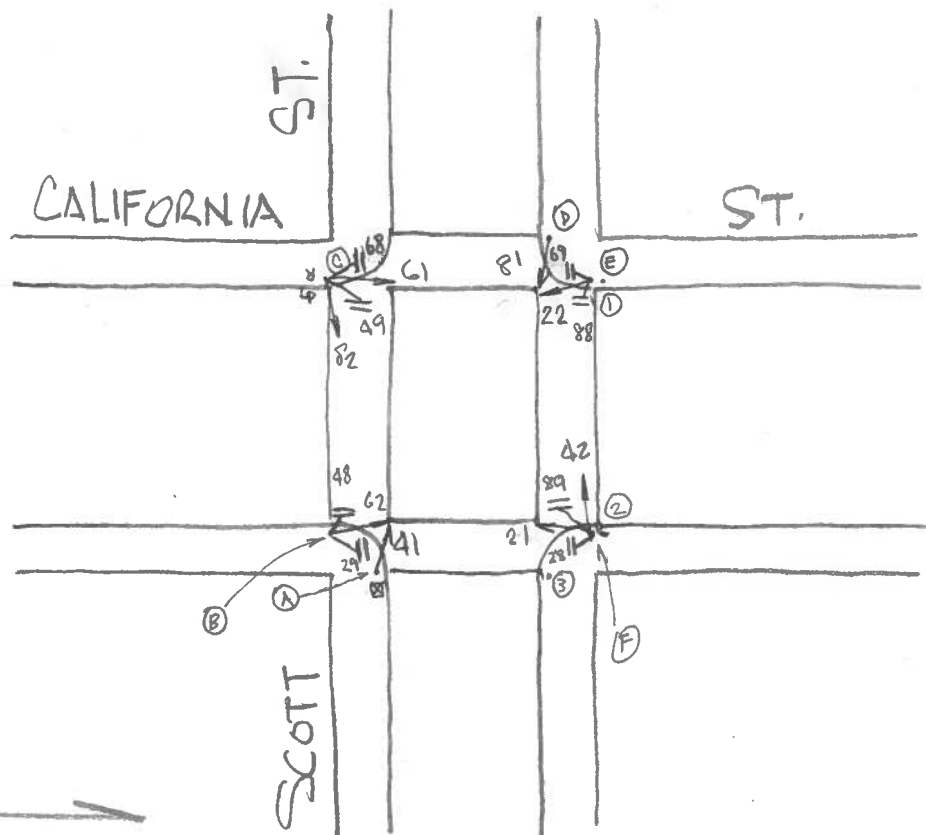

3-24-16

POLE	FUNC.	MAT'L	SIGNAL NO.	MAKE	NO. OF SECT.	SIZE	VISOR	B.P. OR LOUVERS	MOUN'T	PED SIGNAL NO.	LEGEND	MESSAGE		MAKE	MOUN'T
												ELEMENT	COLOR		
A	S	C	41	EC	3	12"	FC 12"	No	T	48	IS-C	GRD	W/BL	EP	S
B	S	C	62	EC	3	12"	FC T	No	T	49	IS-C	GRD	W/BL	ED	S
C	S	C	82	EC	3	12"	FC T	No	T	88	IS-C	GRD	W/BL	ED	S
D	S	C	61	EC	3	12"	FC T	No	T	89	IS-C	GRD	W/BL	ED	S
E	S	C	81	EC	3	12"	FC T	No	T	68	IS-C	GRD	W/BL		S
F	S	C	22	EC	3	12"	FC T	No	T	69	IS-C	GRD	W/BL		S
			42	EC	3	12"	FC T	No	T	28	IS-C	GRD	W/BL		S
			21	EC	3	12"	FC 8"	No	T	29	IS-C	GRD	W/BL		S
1	U	W													
2	U	W													
3	U	W													

CONTROLLER CABINET SIZE : ORDINARY BASE CABINET: YES

COMMENTS: UPGRADE ALL VEHICLE SIGNALS TO 12-INCH

- D. TEUNG