


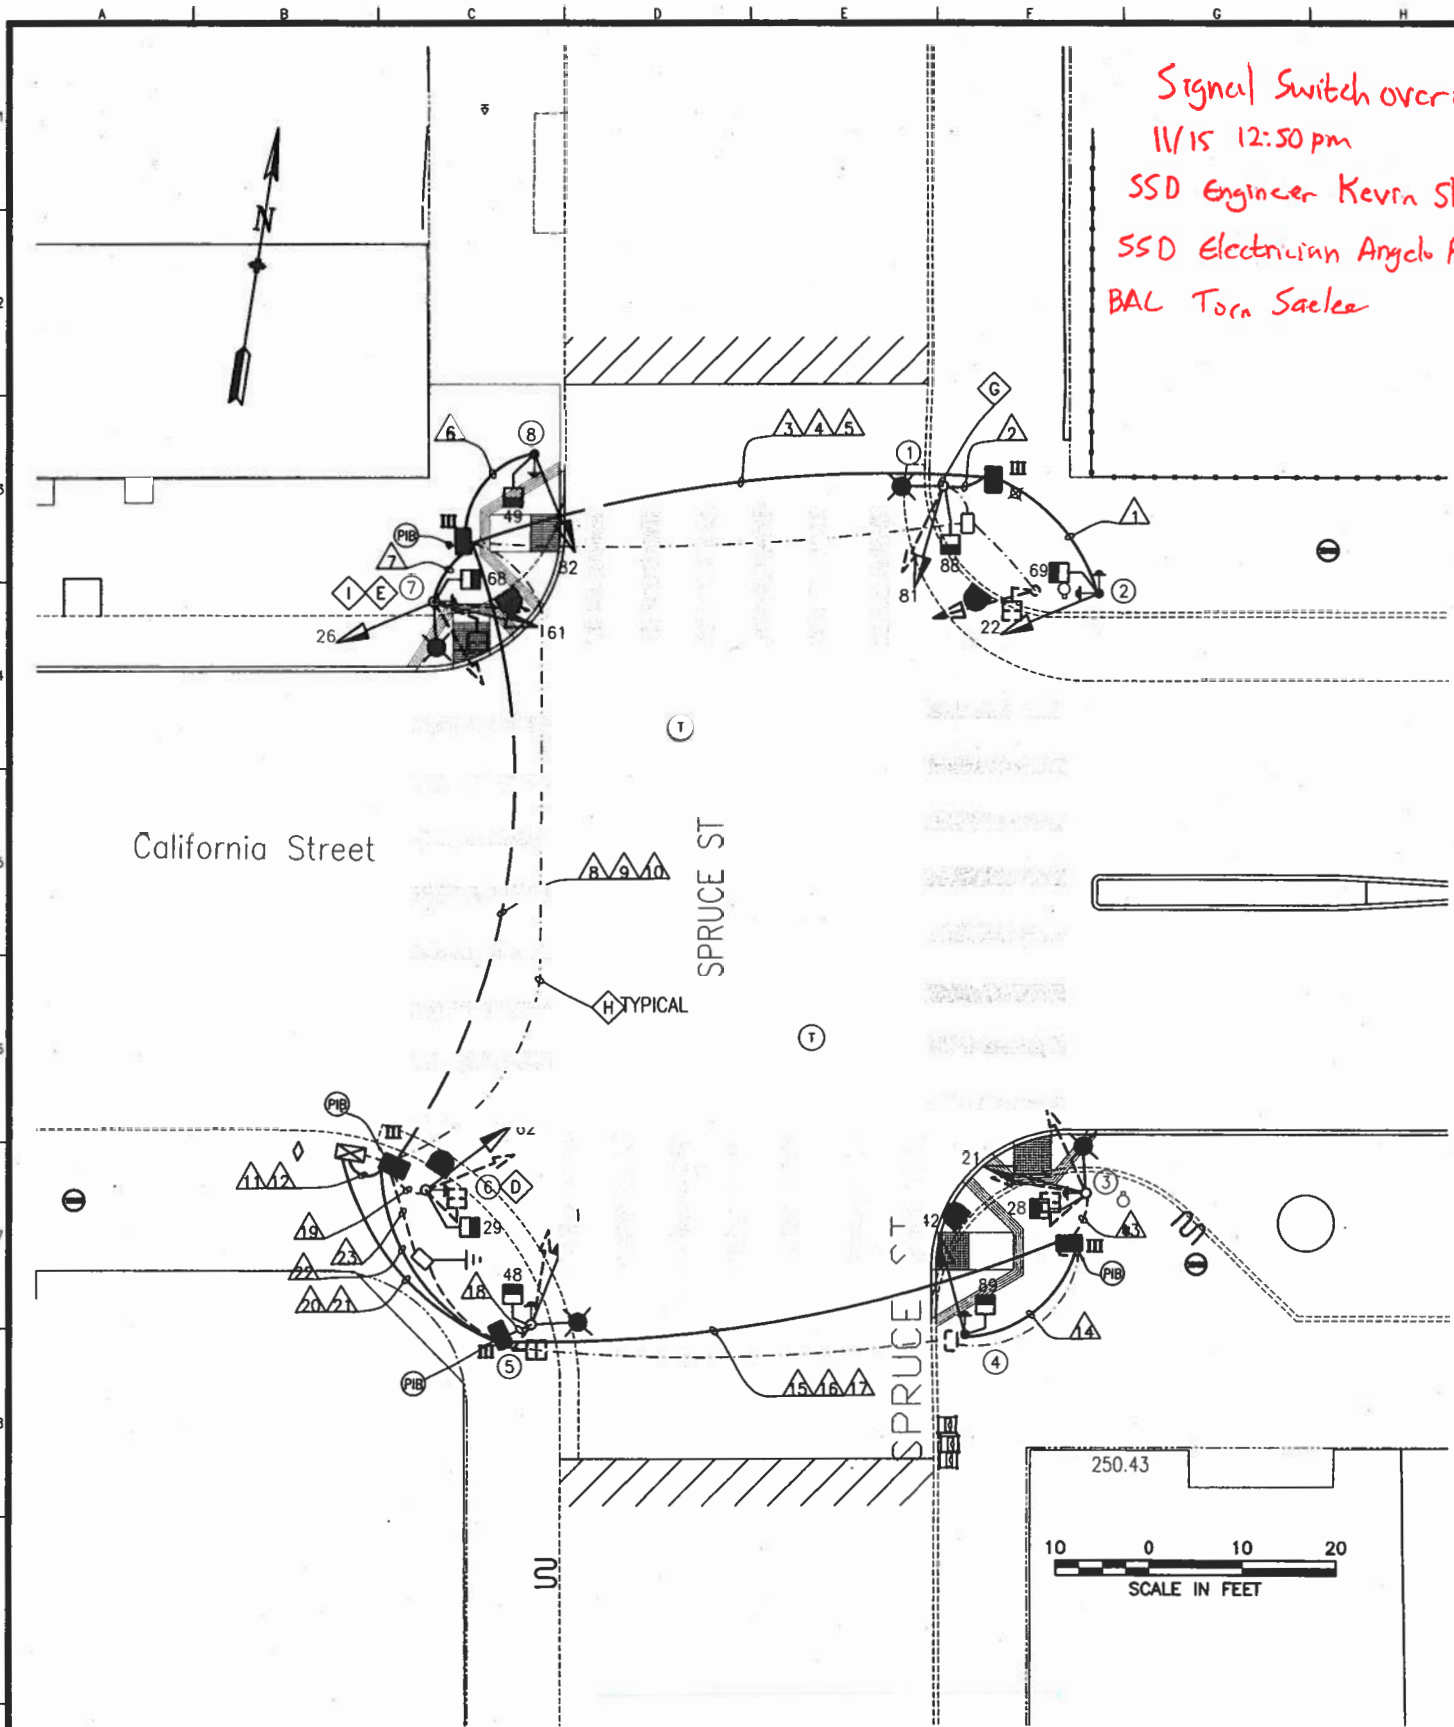


Signal Switch over:
11/15 12:50 pm
SSD Engineer Kevin Shue
SSD Electrician Angelo Reyes
BAL Tom Saelee

POLE AND EQUIPMENT SCHEDULE											
POLE No.	TYPE OF POLE	LUMINAIRE VOLTAGE/WATTAGE	VEHICLE SIGNAL					PEDESTRIAN SIGNAL			REMARKS 
			No.	TYPE	MOUNTING	VISORS	LOUVERS	No.	TYPE	MOUNTING	
①	MARBELITE STREETLIGHT	 	81	3812"	SV-1 w/ 18" Bracket	T		88	1S-COUNT	SP-1-T	
②	1-A (13')		22	3812"	TV-1-T	T		69	1S-COUNT	SP-1	APS APS
③	MARBELITE STREETLIGHT	 	21	3812"	SV-1-T	T		28	1S-COUNT	SP-1	APS
④	1-A (10')		42	3812"	TV-1-T	T		89	1S-COUNT	SP-1	APS
⑤	MARBELITE STREETLIGHT	 	41	3812"	SV-1 w/ 18" Bracket	T		48	1S-COUNT	SP-1-T	APS
⑥	1-A (10') W/ ADAPTER ON EXISTING FOUNDATION		62	3812"	TV-1-T	T		29	1S-COUNT	SP-1	APS
⑦	CITY S/L w/ 6' LUMINAIRE ARM		28 61	3812" 3812"	SV-2-TA	T T		68	1S-COUNT	SP-1	APS
⑧	1-A (10')		82	3812"	TV-1-T	T		49	1S-COUNT	SP-1	APS

SHEET NOTES:

- CUT CONDUIT ENDS 1-FOOT BELOW GRADE; CAP ENDS ABANDON IN PLACE AFTER CUT OVER TO (N) TRAFFIC SIGNALS.
- MAINTAIN 6 FEET OF SLACK FOR APS WIRES.
- CITY FORCES TO INSTALL CITY FURNISHED APS BUTTONS ON POLES TO COMPLY WITH ADA REQUIREMENT CONTRACTOR TO F/I APS WIRING AS SHOWN IN CONDUIT AND WIRING SCHEDULE
- ADAPTER PLATE MUST BE FLUSH WITH GROUND. NO BOLTS SHOULD PROTRUDE ABOVE GROUND.
- CONTRACTOR TO PICK UP AND INSTALL CITY FURNISHED STREETLIGHT POLE, COORDINATE WITH SFPUC, PROVIDE 60 DAYS NOTICE
- REMOVE AND REPLACE EXISTING FIXTURE WITH NEW LED FIXTURE. SEE LIGHTING FIXTURES SCHEDULE IN ET-0.1
- CHIP IN FOUNDATION PER PUC REQUEST
- CONTRACTOR TO REMOVE ALL TRAFFIC SIGNAL WIRING AND MAINTAIN ALL EXISTING CIRCUIT THAT ARE CONNECTED TO REMAIN
- R/C EXISTING POLE AND FIXTURE

PHASE DIAGRAM

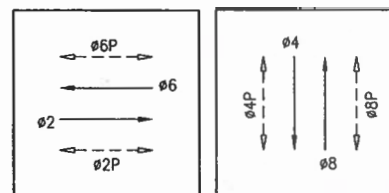

<table><tr><td>NO.</td><td>DATE</td><td>DESCRIPTION</td><td>BY</td><td>APP.</td></tr><tr><td colspan="5">TABLE OF REVISIONS</td></tr></table>	NO.	DATE	DESCRIPTION	BY	APP.	TABLE OF REVISIONS					REFERENCE INFORMATION & FILE NO. OF SURVEYS						DESIGNED: DATE: 5/14/17 LV/CL/CF 3/2017 DRAWN: DATE: 5/22/17 LV/CL/CF 3/2017 CHECKED: DATE: 5/23/17 KK/SL 5/2017				SCALE: AS SHOWN SHEET OF SHEETS 49 OF 65		CALIFORNIA LAUREL VILLAGE IMPROVEMENT PROJECT CALIFORNIA ST. AND SPRUCE ST. TRAFFIC SIGNAL MODIFICATION WORK		CONTRACT NO. 2300J DRAWING NO. ET-1.0 FILE NO. 107,615 REV. NO.	
NO.	DATE	DESCRIPTION	BY	APP.																						
TABLE OF REVISIONS																										

