


POLE AND EQUIPMENT SCHEDULE										CONTRACT WORK IN BOLD
POLE No.	TYPE OF POLE	VEHICLE SIGNAL					PEDESTRIAN SIGNAL			REMARKS
		No.	TYPE	MOUNTING	VISORS	LOUVERS	No.	TYPE	MOUNTING	
①	1-A (10')	EX 22 EX 81	EX 3S8" EX 3S8"	TV-2-T			69 88	1S-COUNT 1S-COUNT	SP-1 (22") SP-1-SF (12")	PPB
②	EX MARBLELITE (10')	EX 21 EX 42	EX 3S8" EX 3S8"				28 89	1S-COUNT 1S-COUNT	SP-1 (22") SP-1-SF (12")	PPB
③	EX MARBLELITE (10')	EX 41 EX 62	EX 3S8" EX 3S8"				29 48	1S-COUNT 1S-COUNT	SP-1 (22") SP-1-SF (12")	PPB
④	EX MARBLELITE (10')	EX 61 EX 82	EX 3S8" EX 3S8"				49 68	1S-COUNT 1S-COUNT	SP-1-SF (12") SP-1 (22")	PPB

PHASE DIAGRAM

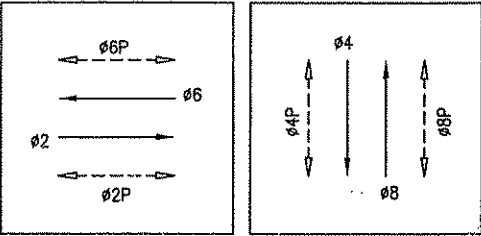

PHASE SEQUENCE

G	Y	R		SILVER AVE
R		G	Y R	CAMBRIDGE ST.
WM	FRH	RH		PED XING CAMBRIDGE ST.
RH		WM	FRH RH	PED XING SILVER AVE


NOTE:
THIS AUTOCAD DRAWING HAS BEEN REVISED AND REPLOTTED SUBSEQUENT TO INTERNAL ENGINEERING APPROVAL AND SIGN-OFF. FOR THOSE SIGNATURES, SEE THE DRAWING PLOTTED AND ISSUED PREVIOUSLY DURING BIDDING. THE SIGNED DRAWING REMAINS VALID EXCEPT FOR THE CHANGES ONLY AS CLEARLY MARKED ON THIS DRAWING AND ISSUED UNDER THIS LATEST REVISION NUMBER AS SHOWN IN THE TABLE OF REVISIONS LOCATED AT THE LOWER LEFT CORNER OF THE DRAWING. ALL ISSUED REVISIONS SUBSEQUENT TO PREVIOUSLY PLOTTED DRAWING DURING BIDDING REMAIN VALID UNLESS SUPERSEDED BY LATER ISSUED REVISIONS. CHECK ALL ISSUED REVISIONS OF THIS DRAWING.

OCTOBER 2005

REFERENCE INFORMATION & FILE NO. OF SURVEYS			
NO.	DATE	DESCRIPTION	BY APP.
1	8/9/06	CHANGE LOCATION OF CONTROLLER, SIGNAL MOD	BC GD
TABLE OF REVISIONS			
CHECK WITH TRACING TO SEE IF YOU HAVE LATEST REVISION			



BUREAU OF ENGINEERING
DEPARTMENT OF PUBLIC WORKS
CITY AND COUNTY OF SAN FRANCISCO

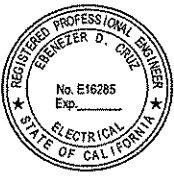

DESIGNED:	DATE:
TP	10/05
DRAWN:	DATE:
NL	10/05
CHECKED:	DATE:
BC	10/05

APPROVED	
SECTION MANAGER	DATE:
DEPUTY BUREAU MANAGER	DATE:
CITY ENGINEER	DATE:

SCALE:
NONE
SHEET OF SHEETS
40 OF 71

CONTRACT 31	SPECIFICATION NO. 0872J
TRAFFIC SIGNAL MODIFICATIONS	DRAWING NO. E-12.2
CAMBRIDGE ST & SILVER AVE SCHEDULE	FILE NO. 86,443
	REV. NO. 0

