
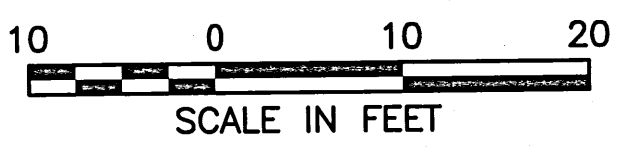


POLE AND EQUIPMENT SCHEDULE											
POLE No.	TYPE OF POLE	LUMINAIRE VOLTAGE/ WATTAGE	VEHICLE SIGNAL					PEDESTRIAN SIGNAL			REMARKS
			No.	TYPE	MOUNTING	VISORS	LOUVERS	No.	TYPE	MOUNTING	
①	MISSION BAY POLE WITH 15' MAST ARM		21 24	3S12" 3S12"	SV-1-T MAS	T T					BACKPLATE ⑦ ⑪ ③
②	MISSION BAY STREET LIGHT ②	⑥4 64	25 62	3S12" 3S12"	SV-2-TA	T T		48	1S-COUNT	SP-1	APS-2W ⑤
③	MISSION BAY POLE WITH 15' MAST ARM & 8' LUMINAIRE	⑥4 64	61 64	3S12" 3S12"	SV-1-T MAS	T T		49	1S-COUNT	SP-1	APS-2W BACKPLATE ⑧ ⑪ ③
④	1-A (10')		22	3S12"	TV-1-T	T					⑨

- GENERAL NOTES:**
- FOR ADDITIONAL MISSION BAY PLANS AND SPECIFICATIONS, MISSION BAY PROJECT, SAN FRANCISCO, CA CONTRACT NO-99334004, DATED FEB 6, 2012. PLEASE CONTACT BILL LAU AT BILL.LAU@SFPD.PW.ORG
  - PULL BOXES SHALL CONFORM TO MISSION BAY STANDARDS FOR PULL BOXES WITH ARCHITECTURAL VAULT COVERS.
  - ALL POLES INSTALLED WILL FOLLOW MISSION BAY STANDARDS, AND SHALL BE FACTORY PAINTED PER SPEC 34 41 13.

- SHEET NOTES:**
- CONTRACTOR SHALL PROTECT SURVEY MONUMENT.
  - R/C (E) STREETLIGHT CONDUIT.
  - REMOVE (E) BRICK AND TREE STUMP. RESTORE TO MATCH SPECIAL SIDEWALK, SEE CURB RAMP PLANS.
  - CONTRACTOR SHALL COORDINATE WITH SFPUC FOR REMOVAL OF (E) WIRELESS EQUIPMENT ON POLE. A MINIMUM OF 10 WORKING DAYS NOTICE REQUIRED. CONTRACTOR SHALL ALSO COORDINATE WITH SFPUC, ONCE THE POLE HAS BEEN RELOCATED TO RE-INSTALL THE WIRELESS EQUIPMENT.
  - RELOCATE (E) 30MB (SMALL POLE DIA.) STREETLIGHT FROM SOUTH SIDE OF OWENS STREET TO LOCATION OF POLE #2. FURNISH AND INSTALL LED OMEGA SERIES 64W RETRO FIT KIT AND NEW CONCRETE FOUNDATION. REFER TO MISSION BAY STANDARD SPEC. DWG LF 3.1 DETAIL 1 BOLT CIRCLE, LF 2.1 DETAIL 1 FOR LUMINAIRE, AND LF 3.3 FOR FOUNDATION.
  - PG&E SERVICE POINT IS A DISTRIBUTION BOX APPROXIMATELY 160' FROM THE SOUTH CAMPUS WAY PROPERTY LINE. COORDINATE WITH PG&E THROUGH SFPUC FOR ACTIVATION OF SERVICE POINT.
  - ⑦ 761MB WITH 15' MAST ARM. REFER TO MISSION BAY STANDARD SPEC. DWG LF 2.2.
  - ⑧ 761MB WITH 15' MAST ARM, LUMINAIRE ARM, AND LED OMEGA SERIES 64W. REFER TO MISSION BAY STANDARD SPEC. DWG LF 2.2.
  - POLE SHALL BE PAINTED AS THE SAME COLOR AS THE MISSION BAY POLES.
  - ⑩ (E) FIRE CALL BOX POLE WILL BE REMOVED BY CITY SERVICES PRIOR TO START OF CONSTRUCTION.
  - ⑪ SEE CYLINDRICAL GROUT BASE DETAIL ② (E-5.1)

**PHASE DIAGRAM**

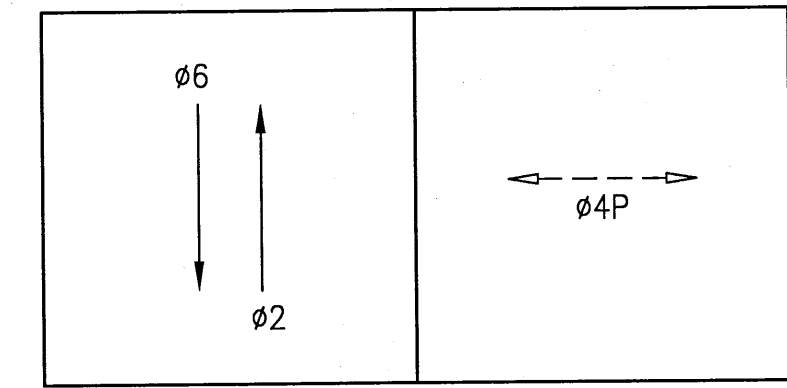

NOTE; THIS AUTOCAD DRAWING HAS BEEN REVISED AND REPLOTTED SUBSEQUENT TO INTERNAL ENGINEERING APPROVAL AND SIGN-OFF. FOR THOSE SIGNATURES, SEE THE DRAWING PLOTTED AND ISSUED PREVIOUSLY DURING BIDDING. THE SIGNED DRAWING REMAINS VALID EXCEPT FOR THE CHANGES ONLY AS CLEARLY MARKED ON THIS DRAWING AND ISSUED UNDER THIS LATEST REVISION NUMBER AS SHOWN IN THE TABLE OF REVISIONS LOCATED AT THE LOWER LEFT CORNER OF THE DRAWING. ALL ISSUED REVISIONS SUBSEQUENT TO PREVIOUSLY PLOTTED DRAWING DURING BIDDING REMAIN VALID UNLESS SUPERSEDED BY LATER ISSUED REVISIONS. CHECK ALL ISSUED REVISIONS OF THIS DRAWING.

TABLE OF REVISIONS				REFERENCE INFORMATION & FILE NO. OF SURVEYS		BUREAU OF DESIGN & ENGINEERING CITY & COUNTY OF SAN FRANCISCO SAN FRANCISCO PUBLIC WORKS 30 VAN NESS AVENUE, 5TH FLOOR SAN FRANCISCO, CA 94102 - 6028		Section Mgr: PHILIP THWIN Deputy Bureau Mgr: IQBALBHAI DHAPA Bureau Mgr: PATRICK RIVERA		Date: 3/2018 Date: 3/2018 Date: 3/2018		DESIGNED: DATE: 3/2018 DRAWN: DATE: 3/2018 CHECKED: DATE: 3/2018		SCALE: 1"=10' SHEET OF SHEETS 18 OF 43		CONTRACT 64 NEW TRAFFIC SIGNALS CAMPUS WAY & OWENS STREET TRAFFIC SIGNAL WORK POLE AND EQUIPMENT SCHEDULE		CONTRACT NO. 1000009385 DRAWING NO. E-5.0 FILE NO. 111,766 REV. NO. 3	
--------------------	--	--	--	---	--	---	--	---	--	--	--	--	--	---	--	---	--	--	--



