



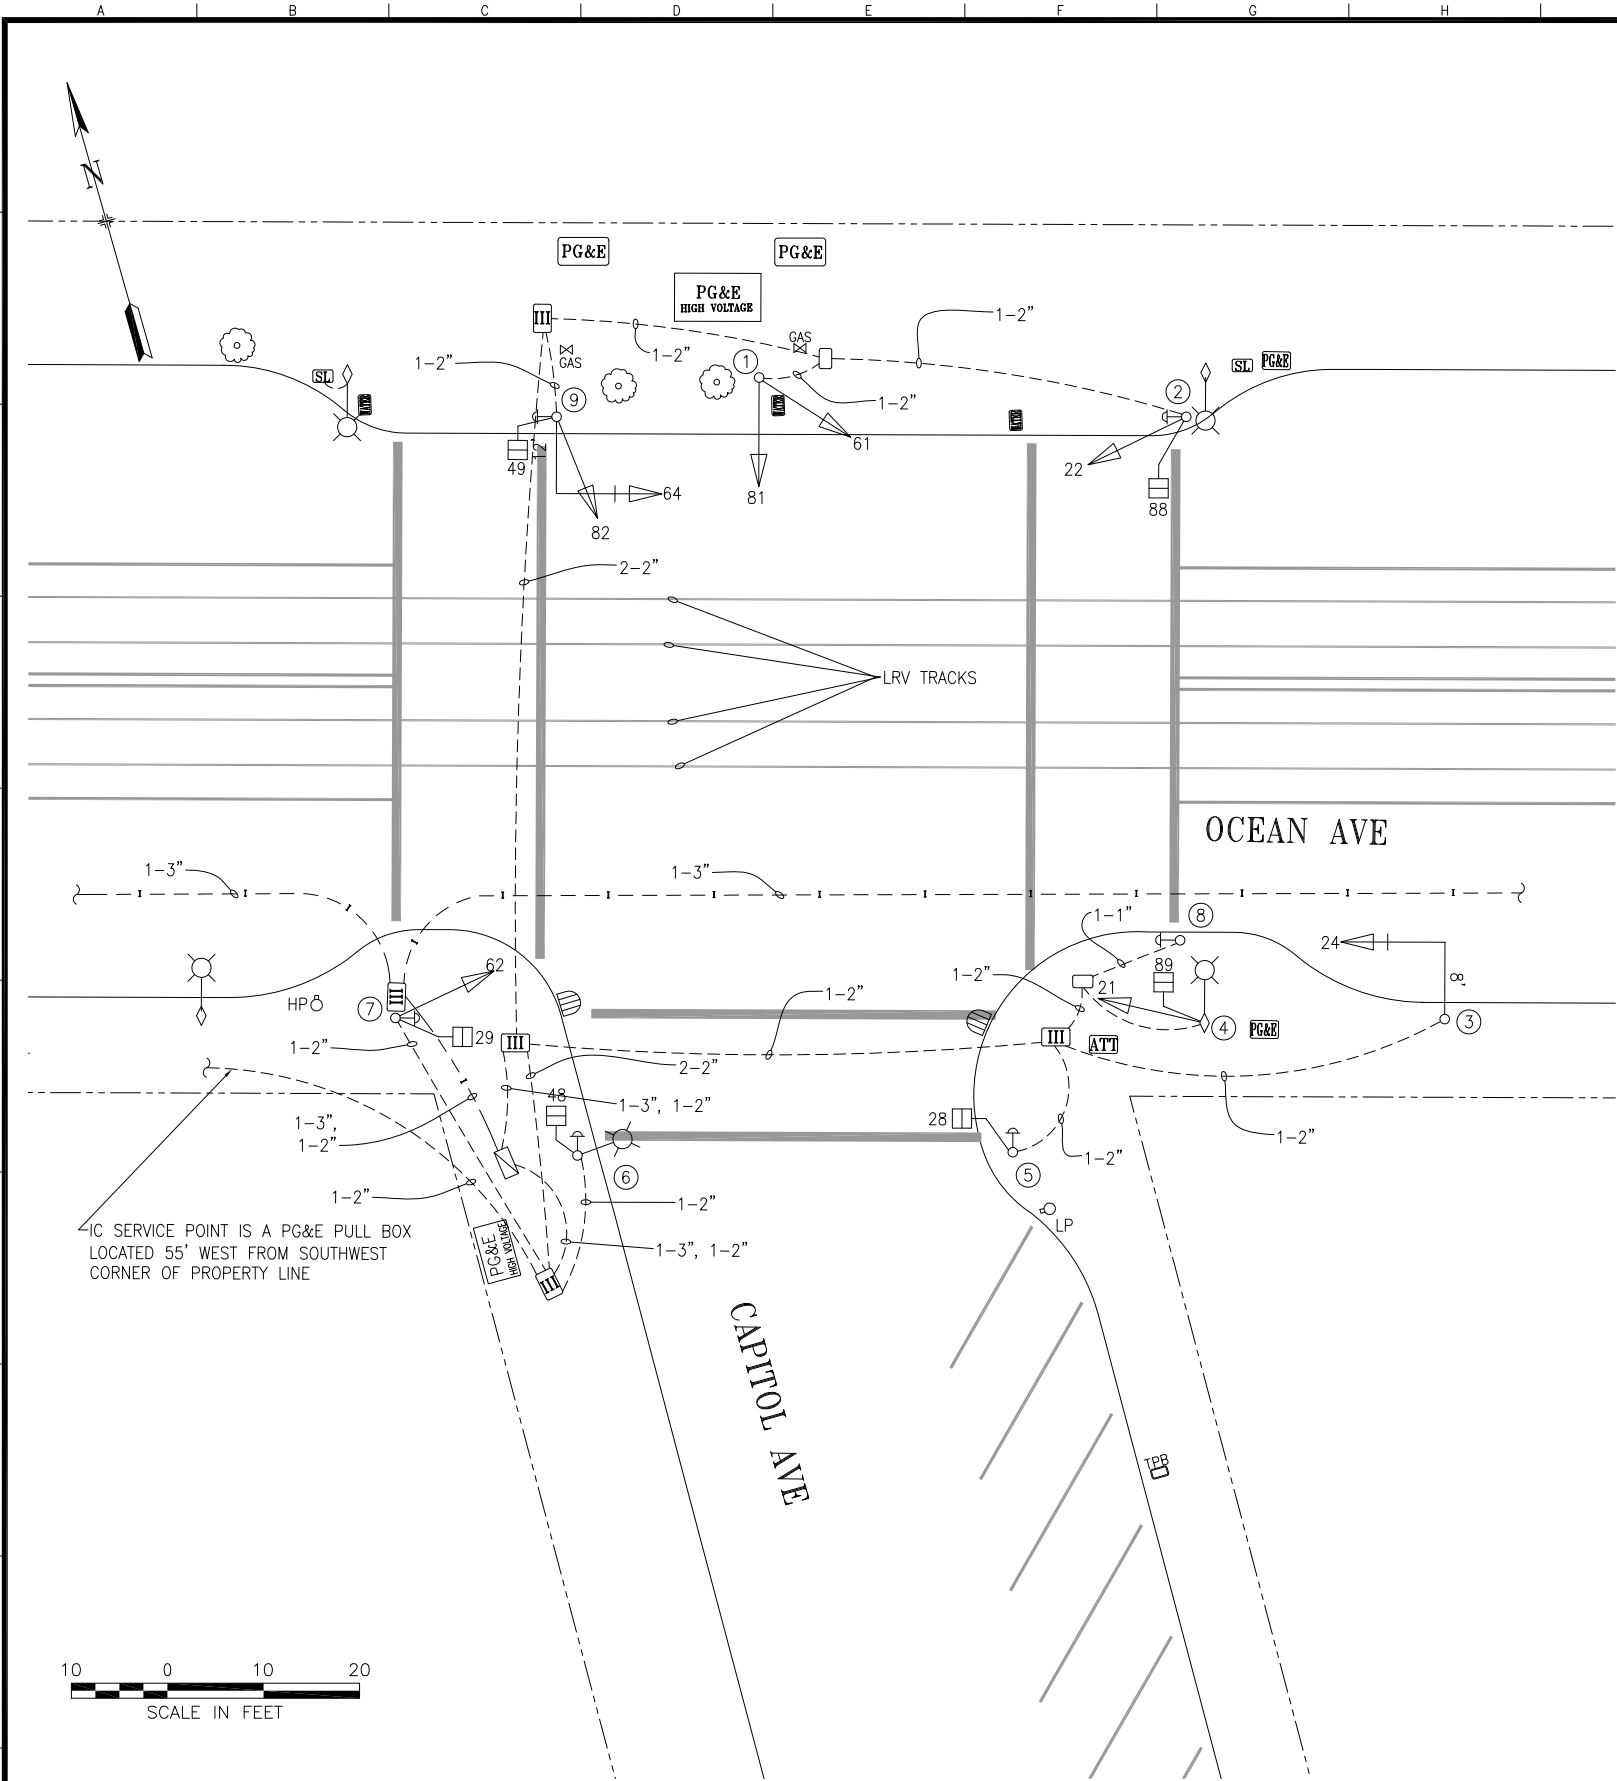

POLE AND EQUIPMENT SCHEDULE											
POLE No.	TYPE OF POLE	LUMINAIRE VOLTAGE/ WATTAGE	VEHICLE SIGNAL					PEDESTRIAN SIGNAL			REMARKS
			No.	TYPE	MOUNTING	VISORS	LOUVERS	No.	TYPE	MOUNTING	
①	1-A (10')		81 61	3S12" 3S12"	TV-2-T	T T					
②	1-A (10')		22	3S12"	TV-1-T	T		88	1S-COUNT	SP-1	APS
③	16-1-100 WITH 8' MAST ARM		24	3S12"	MAS	T			1S-COUNT	SP-1	BACKPLATE
④	EX MUNI W/ LUMINAIRE		21	3S12"	SV-1-T	T		89			
⑤	1-A (7')							28	1S-COUNT	TP-1	APS
⑥	CITY STANDARD STREET LIGHT	120V 150W						48	1S-COUNT	SP-1	APS
⑦	1-A (10')		62	3S12"	TV-1-T	T		29	1S-COUNT	SP-1	APS
⑧	PPB POLE										APS
⑨	16-1-100 WITH 12' MAST ARM		64 82	3S12" 3S12"	MAS SV-1-T	T T		49	1S-COUNT	SP-1	APS BACKPLATE

PHASE DIAGRAM

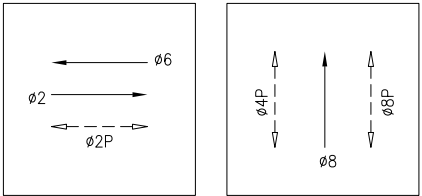

PHASE SEQUENCE
(STEADY DEMAND)

G		Y	R			OCEAN AVE (EB & WB) – Ø2 & Ø6	
R			G		Y	R	CAPITOL AVE (NB) – Ø8
WM	FRH	RH				PED XING CAPITOL AVE (SS) – Ø2P	
RH		WM		FRH	RH	PED XING OCEAN AVE (WS & ES) – Ø4P & Ø8P	

0	05/03/12	NEW SIGNAL ACTIVATED THROUGH CT. 60	GH	GD	
NO.	DATE	DESCRIPTION	BY	APP.	
TABLE OF REVISIONS					
CHECK WITH TRACING TO SEE IF YOU HAVE LATEST REVISION					

REFERENCE INFORMATION
& FILE NO. OF SURVEYS



SAN FRANCISCO MUNICIPAL TRANSPORTATION AGENCY
CITY AND COUNTY OF SAN FRANCISCO

DESIGNED:	DATE:
GD	12/2013
DRAWN:	DATE:
GD	12/2013
CHECKED:	DATE:
MV	12/2013

SCALE:

AS SHOWN

SHEET OF SHEETS

1 OF 1

TRAFFIC SIGNAL INVENTORY DIAGRAM

CAPITOL AVE AND OCEAN AVE

CNN NO.

22628000

REV NO.

0