




POLE AND EQUIPMENT SCHEDULE											
POLE No.	TYPE OF POLE	LUMINAIRE VOLTAGE/WATTAGE	VEHICLE SIGNAL					PEDESTRIAN SIGNAL			REMARKS
			No.	TYPE	MOUNTING	VISORS	LOUVERS	No.	TYPE	MOUNTING	
①	1-A (10')		81	3S8"	TV-1	FC					
②	MAS W/ SL	HPS 120V/200W	21 91 136 24	3S12" BIKE 3S12" BIKE 3S12" BIKE 3S12"	SV-3-TA MAS	LA T T FC					
③	1-A (10')		42	3S8"	TV-1	FC					
④	SL	HPS 120V/200W	41	3S8"	SV-1	T					
⑤	1-A (15')		62 95 132	3S12" BIKE 3S12" BIKE 3S12" BIKE	SV-3-TA	T T T					
⑥	SL	HPS 120V/200W	63	3S12"	SV-1						
⑦	MAS		64 82	3S12" 3S8"	MAS SV-1	FC FC					

1	2/10/22	RE-INSTALL SIGNAL 63 AS 3S12" PER MAINTENANCE	C.SKERRIT	G.DELEON	
0	8/2/12	ADDED BICYCLE SIGNALS FOR CARGO WAY CYCLETRACK	JRS	DRC	
NO.	DATE	DESCRIPTION	BY	APPROVED	
TABLE OF REVISIONS					
CHECKOUT DRAWING THROUGH THE SID CUSTODIAN FOR THE LATEST REVISION					

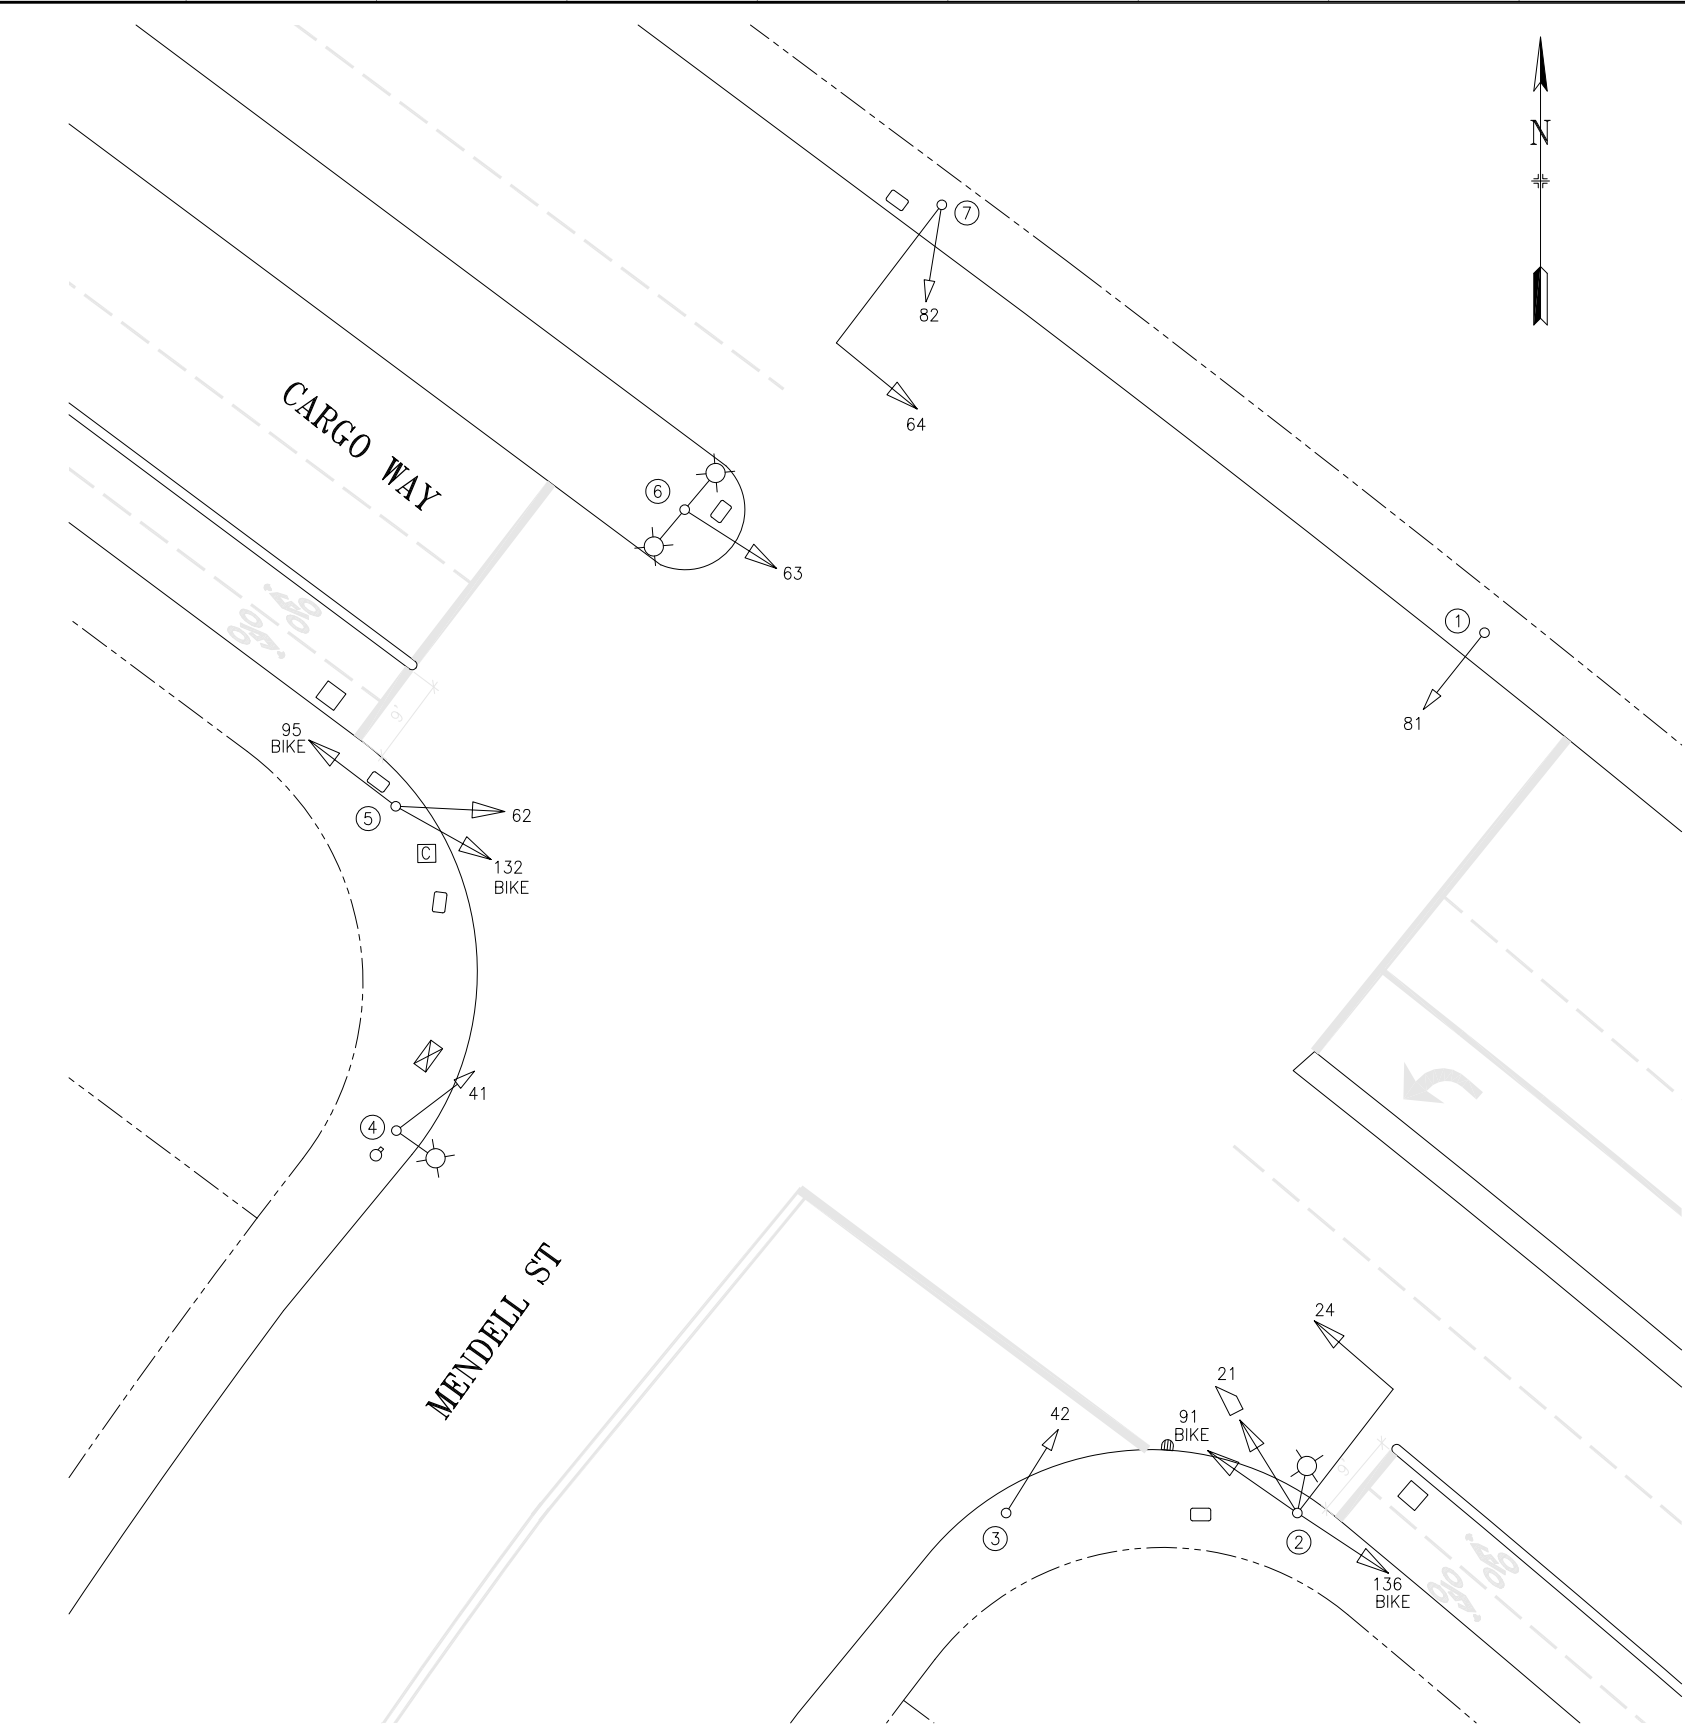

SFMTA

DRAWN BY: JRS	DATE: 2/23/2012	SCALE 1"=10' SHEET OF SHEETS 1 OF 1	TRAFFIC SIGNAL INVENTORY DIAGRAM CARGO WAY & MENDELL STREET	CNN NO: 33105000
CHECKED BY: JRS	DATE: 2/23/2012			REV NO: 1