


ARTER & GENEVA

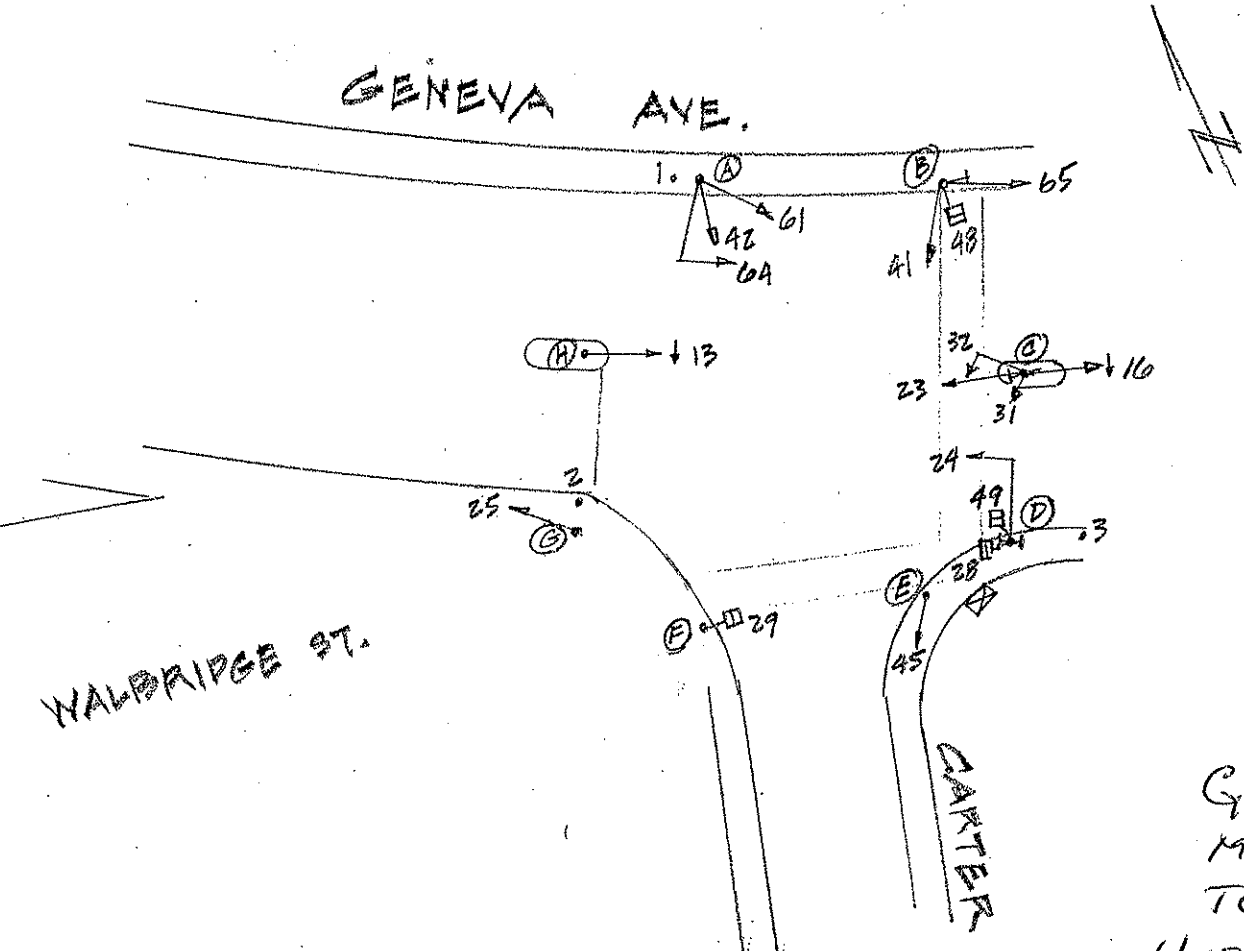

GG
MC
TC

11/12/08

POLE	FUNC.	MAT'L	SIGNAL NO.	MAKE	NO. OF SECT.	SIZE	VISOR	B.P. OR LOUVERS	MOUN'T	PED SIGNAL NO.	LEGEND	MESSAGE		MAKE	MOUN'
												ELEMENT	COLOR		
A	S	S													
B	S	S	25	EC	3	12"	FC12"	BP	T	28	I	13-1	WH/12	ILL	S
C	S	S	13	EC	3	12"	FC12"	*N2	T	29	I	13-1	"	ILL	S
D	S	S	64	EC	3	12"	FC12"	BP	MAS	48	I	13-1	"	ILL	S
E	S	S	42	EC	3	12"	FC12"	BP	S	49	I	13-1	"	ILL	S
F	S	S	61	EC	3	12"	FC12"	BP	S						
G	S	S	41	EC	3	12"	FC12"	BP	T						
H	S	S	65	EC	3	12"	FC12"	BP	T						
			16	EC	3	12"	FC12"	BP	S						
1	U	W	31	PV	3	12"	2AP12"	BP	S						
2	L	S	32	PV	3	12"	2AP12"	BP	MAS						
3	L	S	23	EC	3	12"	FC12"	BP	S						
			24	EC	3	12"	FC12"	BP	MAS						
			45	EC	3	12"	FC12"	BP	T						

CONTROLLER CABINET SIZE : LARGE BASE CABINET : -

COMMENTS : SEE C. 11/12/08 - NOTED FOR SIGNAL 28 & 29