


POLE AND EQUIPMENT SCHEDULE										
POLE No.	TYPE OF POLE	VEHICLE SIGNAL					PEDESTRIAN SIGNAL 1S-COUNT			REMARKS
		No.	TYPE	MOUNTING	VISORS	LOUVERS	No.	TYPE	MOUNTING	
①	MARBLELITE (10')	21	3S8"	TV-1	FC		28	1S-COUNT	SP-1	
②	MARBLELITE (10')	42	3S8"	TV-2-T-SF	FC		89	1S-COUNT	SP-1	
		85	3S8"		FC					
③	STREET LIGHT	41	3S12"	SV-1-T	T		48	1S-COUNT	SP-1	
④	MARBLELITE(10')	62	3S12"	TV-1-T	T		29	1S-COUNT	SP-1	
⑤	MUNI/SL	61	3S12"	SV-1-T	T		68	1S-COUNT	SP-1	
⑥	MARBLELITE (10')	82	3S8"	TV-1	FC		49	1S-COUNT	SP-1	
⑦	MARBLELITE (10')	81	3S8"	TV-1	FC		88	1S-COUNT	SP-1	
⑧	STREET LIGHT	22	3S8"	SV-1	FC		69	1S-COUNT	SP-1	



REFERENCE INFORMATION & FILE NO. OF SURVEYS					
1	5/27/16	SIGNAL #41 REPLACED WITH 3S12"	JH	ET	
0	8/3/06	UPGRADED BY 0872J; CONVERTED FROM CONTRACT PLANS	JH	ET	
NO.	DATE	DESCRIPTION	BY	APP.	
TABLE OF REVISIONS CHECK WITH TRACING TO SEE IF YOU HAVE LATEST REVISION					

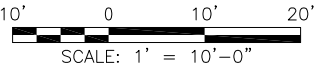

SAN FRANCISCO MUNICIPAL TRANSPORTATION AGENCY
CITY AND COUNTY OF SAN FRANCISCO

DRAWN: JH CHECKED: ET	DATE: 7/2016 DATE: 7/2016	SCALE:	TRAFFIC SIGNAL INVENTORY DIAGRAM		CNN NO. 26005000
		AS SHOWN			REV NO.
		SHEET OF SHEETS 1 OF 1	CASTRO ST & DUBOCE AVE		1