


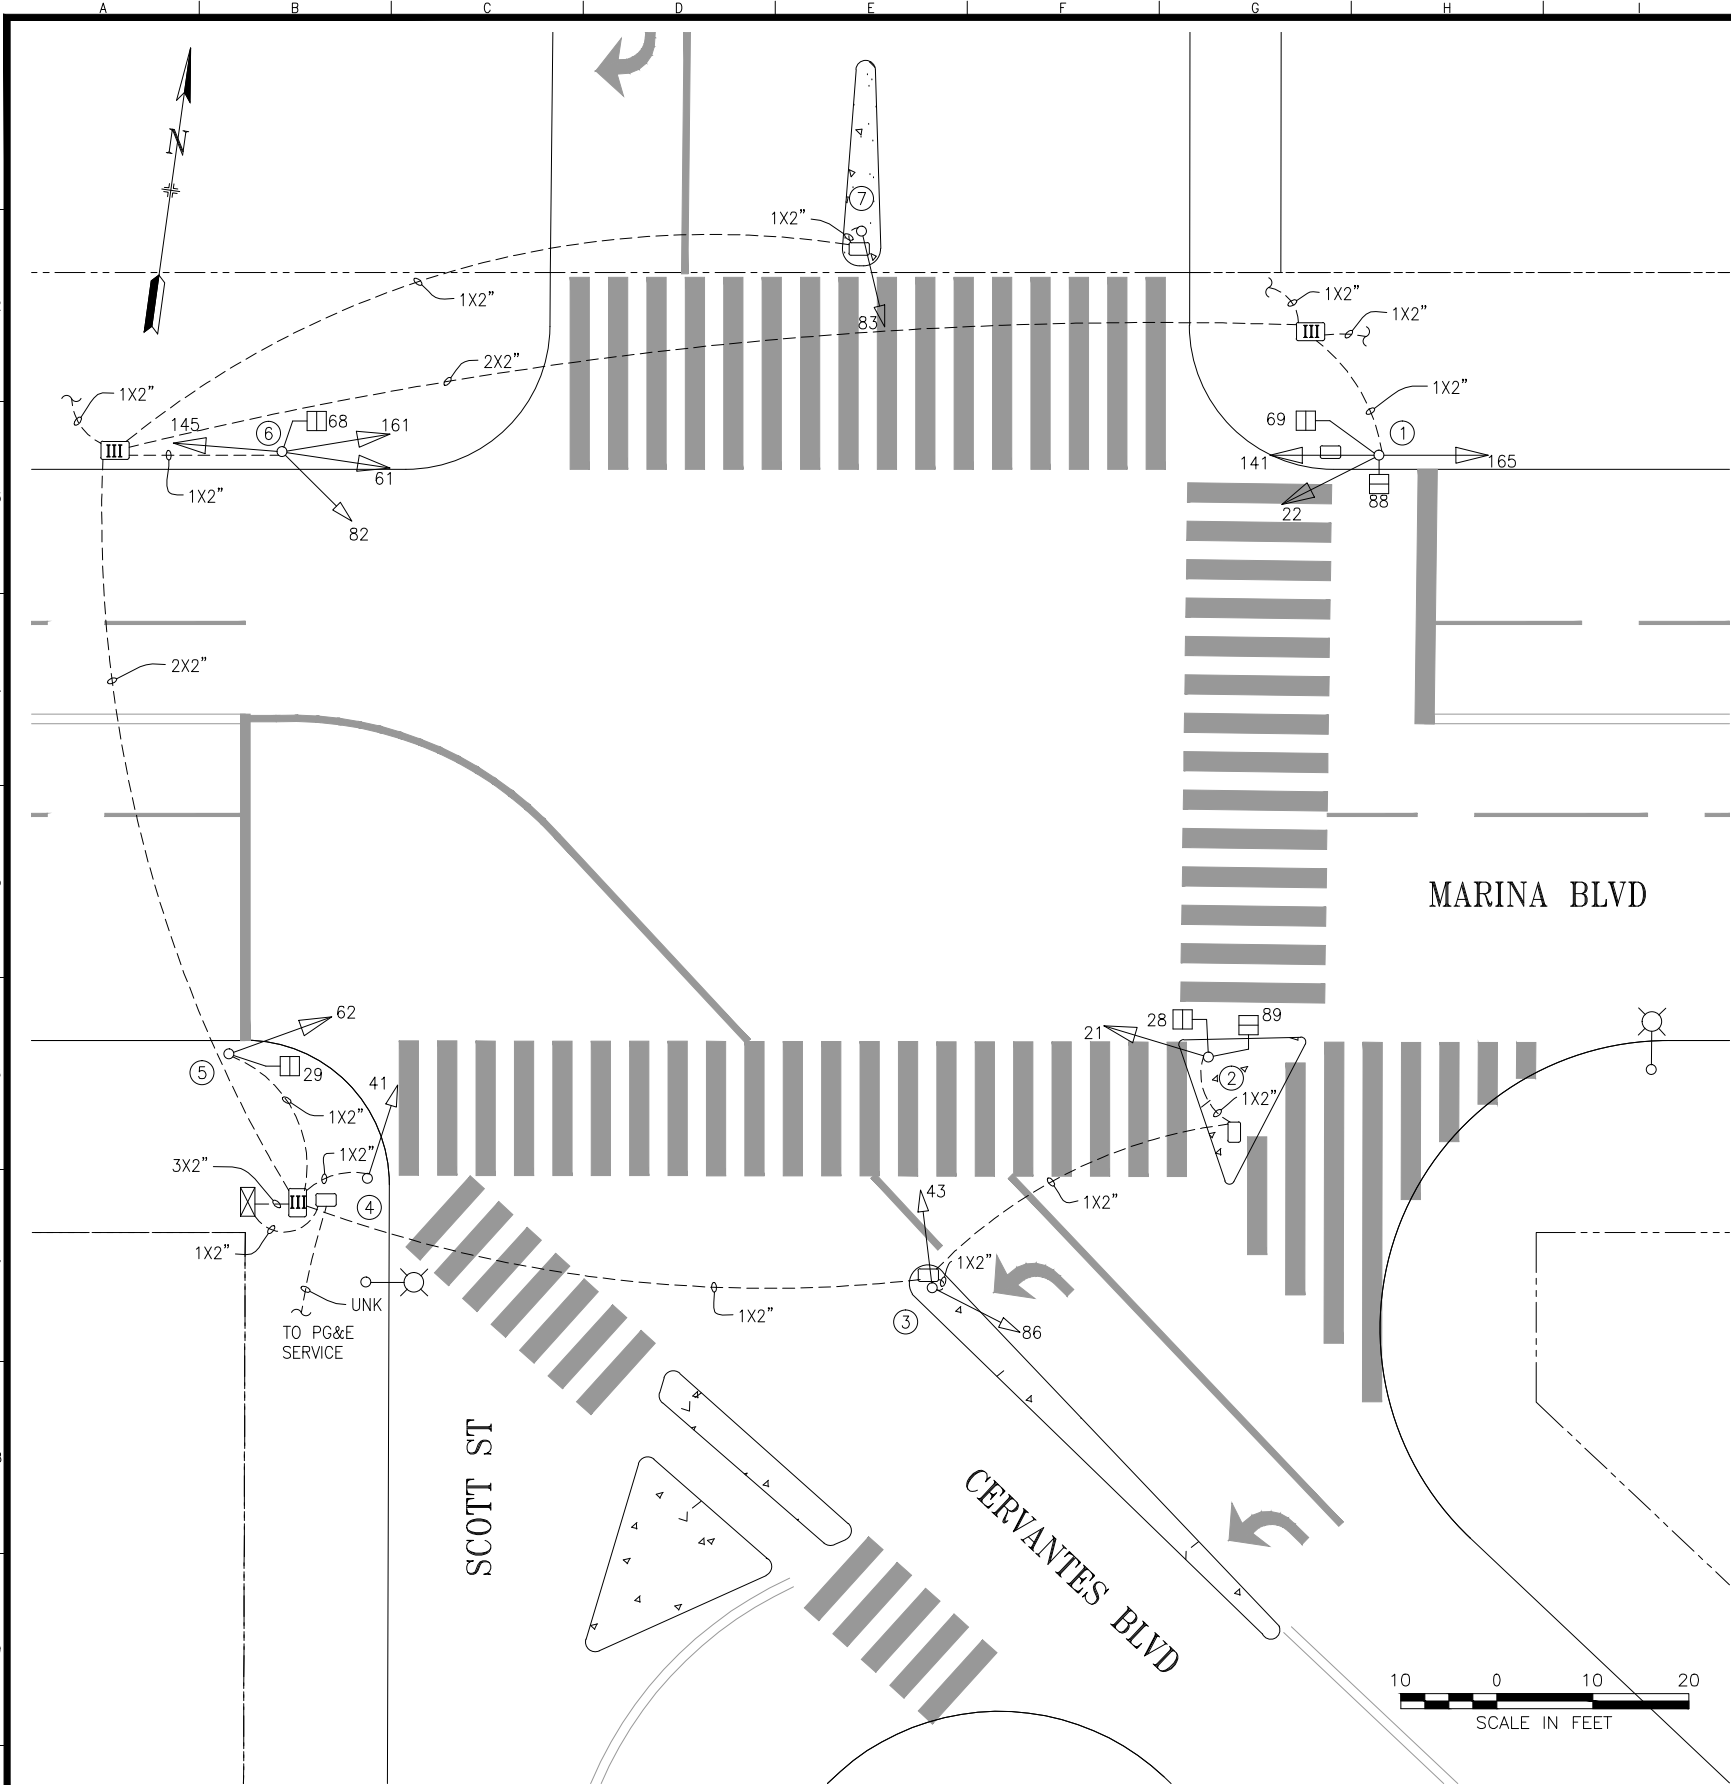

POLE AND EQUIPMENT SCHEDULE										
POLE No.	TYPE OF POLE	LUMINAIRE VOLTAGE/WATTAGE	VEHICLE SIGNAL				PEDESTRIAN SIGNAL			REMARKS
			No.	TYPE	MOUNTING	VISORS	No.	TYPE	MOUNTING	
①	1-A (15')		22 141 165	3S12" 3S12" BIKE 3S12" BIKE	TV-1 SV-2-TA	FC T T	69 88	1S-COUNT 1S-COUNT	SP-1 SP-1	
②	1-A (10')		21	3S12"	TV-1	FC	89 28	1S-COUNT 1S-COUNT	SP-1 SP-1	
③	1-A (10')		43 86	3S8" 3S8"	TV-2-T-SF	T T				
④	1-A (10')		41	3S8"	TV-1	T				
⑤	1-A (10')		62	3S12"	TV-1	T	29	1S-COUNT	SP-1	
⑥	1-A (15')		61 82 145 161	3S12" 3S8" 3S12" BIKE 3S12" BIKE	TV-2-T-SFB SV-2-TA	FC FC T T	68	1S-COUNT	SP-1	
⑦	1-A (10')		83	3S8"	TV-1	FC				

TABLE OF REVISIONS			CHECK WITH TRACING TO SEE IF YOU HAVE LATEST REVISION	
NO.	DATE	DESCRIPTION	BY	APP.
1	8/11/15	ADDED PGS XING SCOTT (SOUTHSIDE) PER SRC 2015-221	AScales	MVelasco
0	05/23/13	BIKE SIGNALS ADDED PER SRC 2013-097	JShamini	DCurtis

REFERENCE INFORMATION & FILE NO. OF SURVEYS



SAN FRANCISCO MUNICIPAL TRANSPORTATION AGENCY
CITY AND COUNTY OF SAN FRANCISCO

DRAWN: AScales	DATE: 11/2015
CHECKED: MVelasco	DATE: 11/2015

SCALE: AS SHOWN
SHEET OF SHEETS 1 OF 1

TRAFFIC SIGNAL INVENTORY DIAGRAM
CERVANTES BLVD, MARINA BLVD, AND SCOTT ST

CNN NO. 26796000
REV NO. 1