


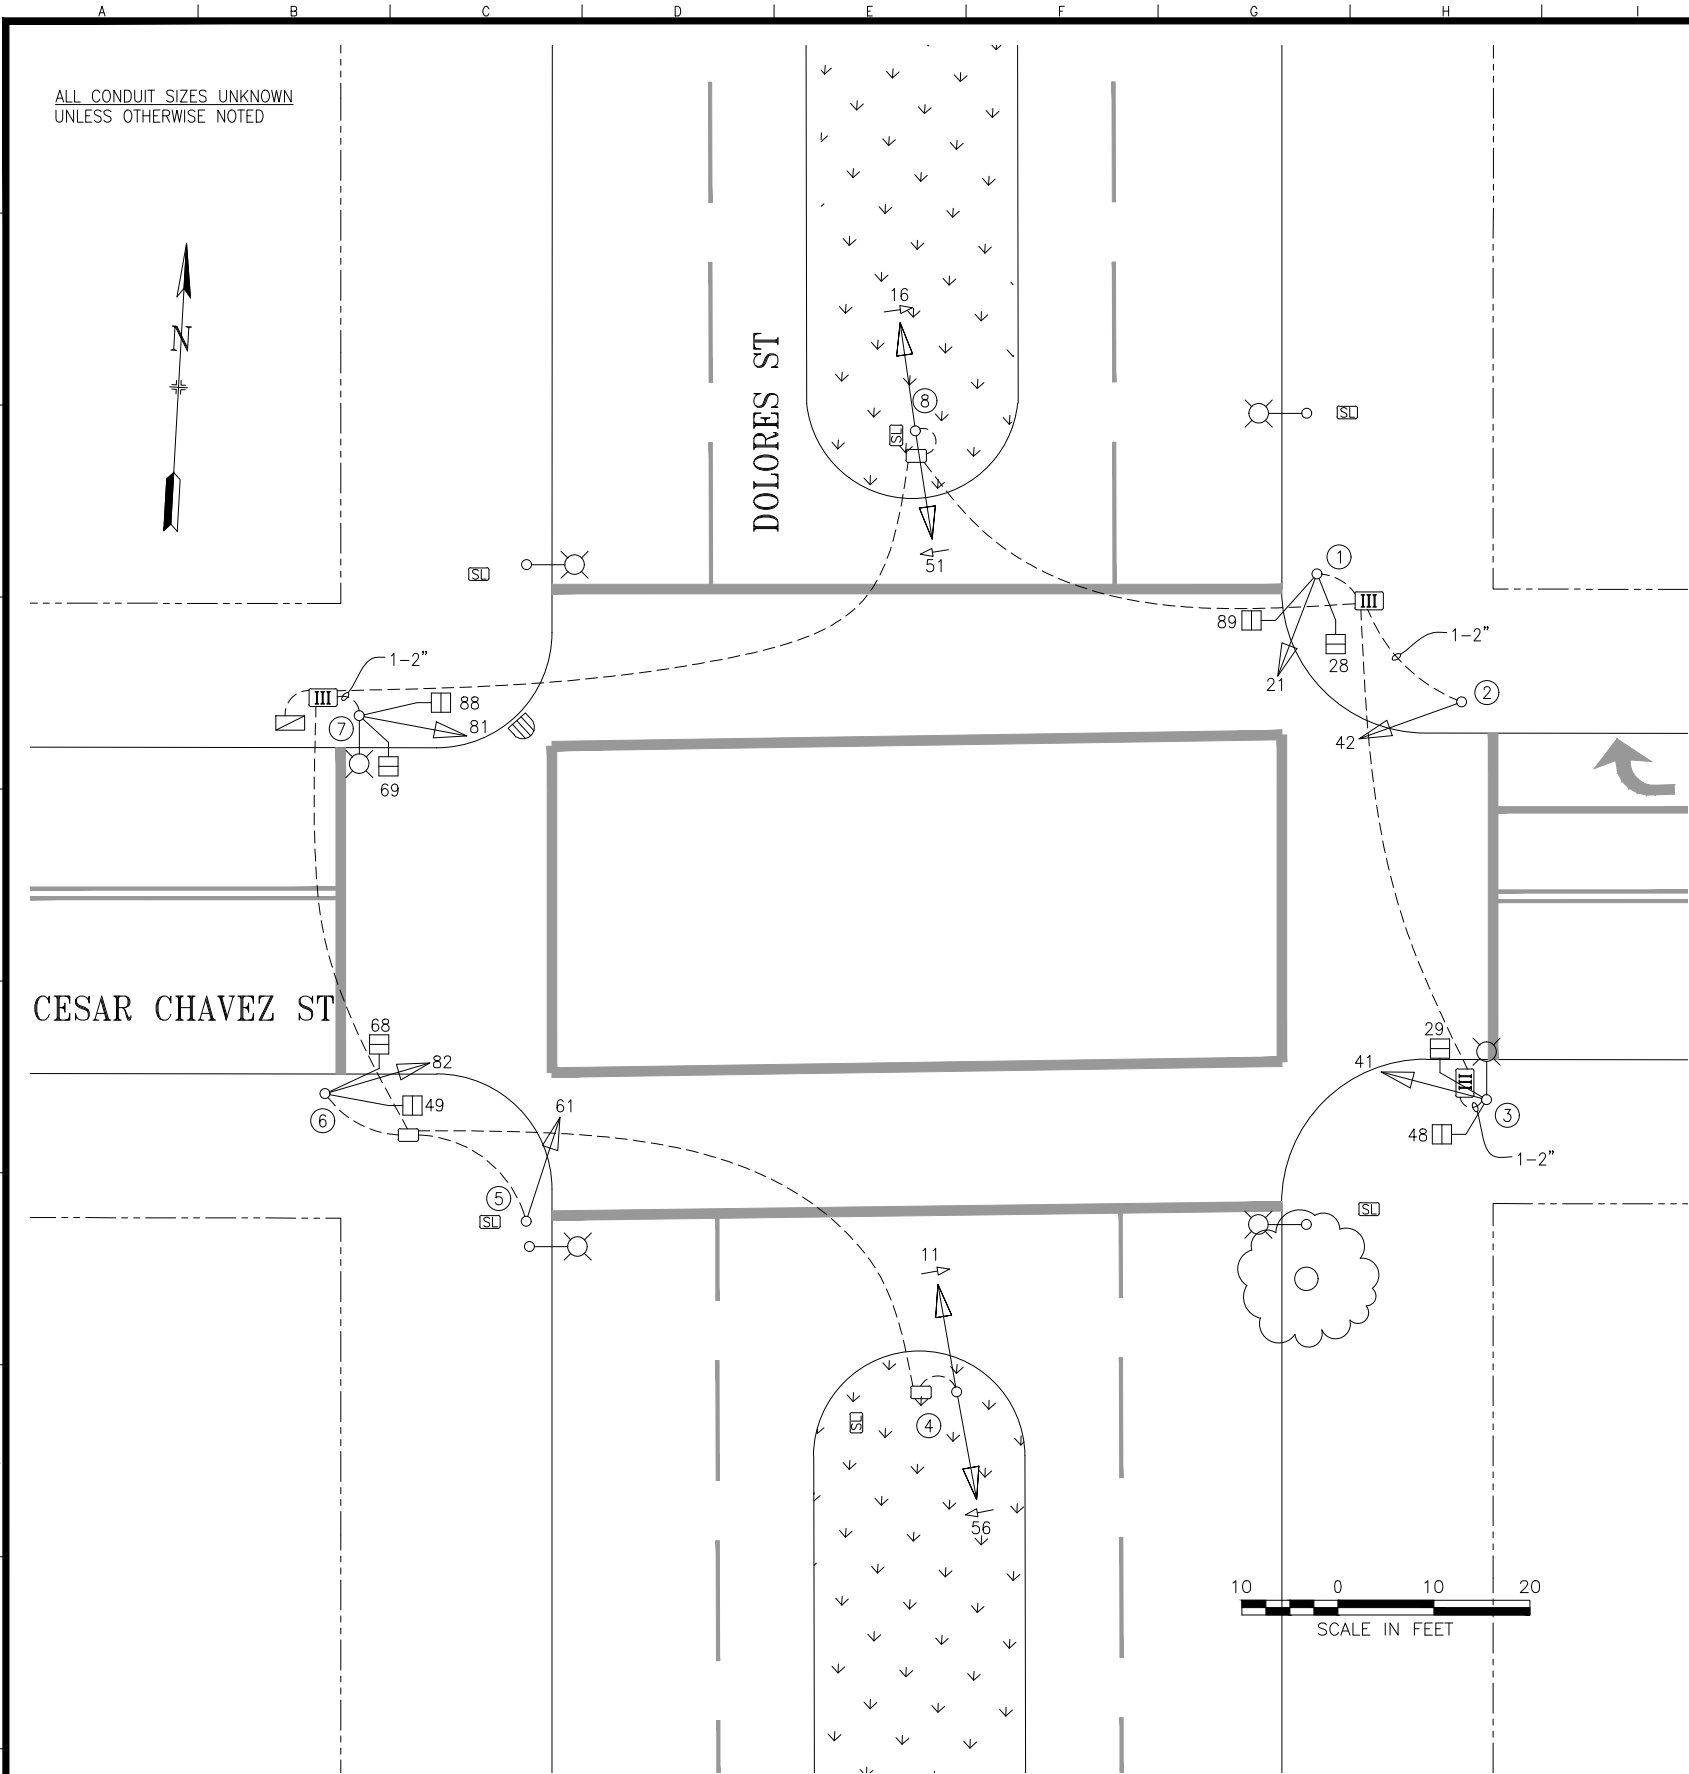

POLE AND EQUIPMENT SCHEDULE											
POLE No.	TYPE OF POLE	LUMINAIRE VOLTAGE/ WATTAGE	VEHICLE SIGNAL					PEDESTRIAN SIGNAL			REMARKS
			No.	TYPE	MOUNTING	VISORS	LOUVERS	No.	TYPE	MOUNTING	
①	1-A (15')		21	3S12"	TV-1-T	T		28 89	1S-COUNT 1S-COUNT	SP-1-SF SP-1	
②	1-A (10')		42	3S12"	TV-1-T	T					
③	CITY STANDARD STREET LIGHT		41	3S12"	SV-1-T	T		29 48	1S-COUNT 1S-COUNT	SP-1-SF SP-1	
④	1-A (10')		11 56	4S12"GLA 4S12"GLA	TV-1-T SV-1	FC FC					
⑤	1-A (10')		61	3S12"	TV-1-T	T					
⑥	1-A (10')		82	3S12"	TV-1-T	T		49 68	1S-COUNT 1S-COUNT	SP-1 SP-1-SF	
⑦	CITY STANDARD STREET LIGHT		81	3S12"	SV-1-T	T		69 88	1S-COUNT 1S-COUNT	SP-1-SF SP-1	
⑧	1-A (15')		16 51	4S12"GLA 4S12"GLA	SV-1 TV-1-T	FC FC					

TABLE OF REVISIONS		CHECK WITH TRACING TO SEE IF YOU HAVE LATEST REVISION	
NO.	DATE	DESCRIPTION	BY APP.
1	9/10/15	PED SIGNALS 48, 49, 88, 89 ACTIVATED BY SRC 2015-173	DY MV
0	8/2015	SIGNAL MODS BY 2260J; CONVERTED FROM CP	JH GD

REFERENCE INFORMATION & FILE NO. OF SURVEYS



SAN FRANCISCO MUNICIPAL TRANSPORTATION AGENCY

CITY AND COUNTY OF SAN FRANCISCO

DRAWN:	DATE:
JH	12/2016
CHECKED:	DATE:
GD	12/2016

SCALE:
AS SHOWN
SHEET OF SHEETS
01 OF 01

TRAFFIC SIGNAL INVENTORY DIAGRAM
CESAR CHAVEZ ST AND DOLORES ST

CNN NO.
21901000
REV NO.
1