


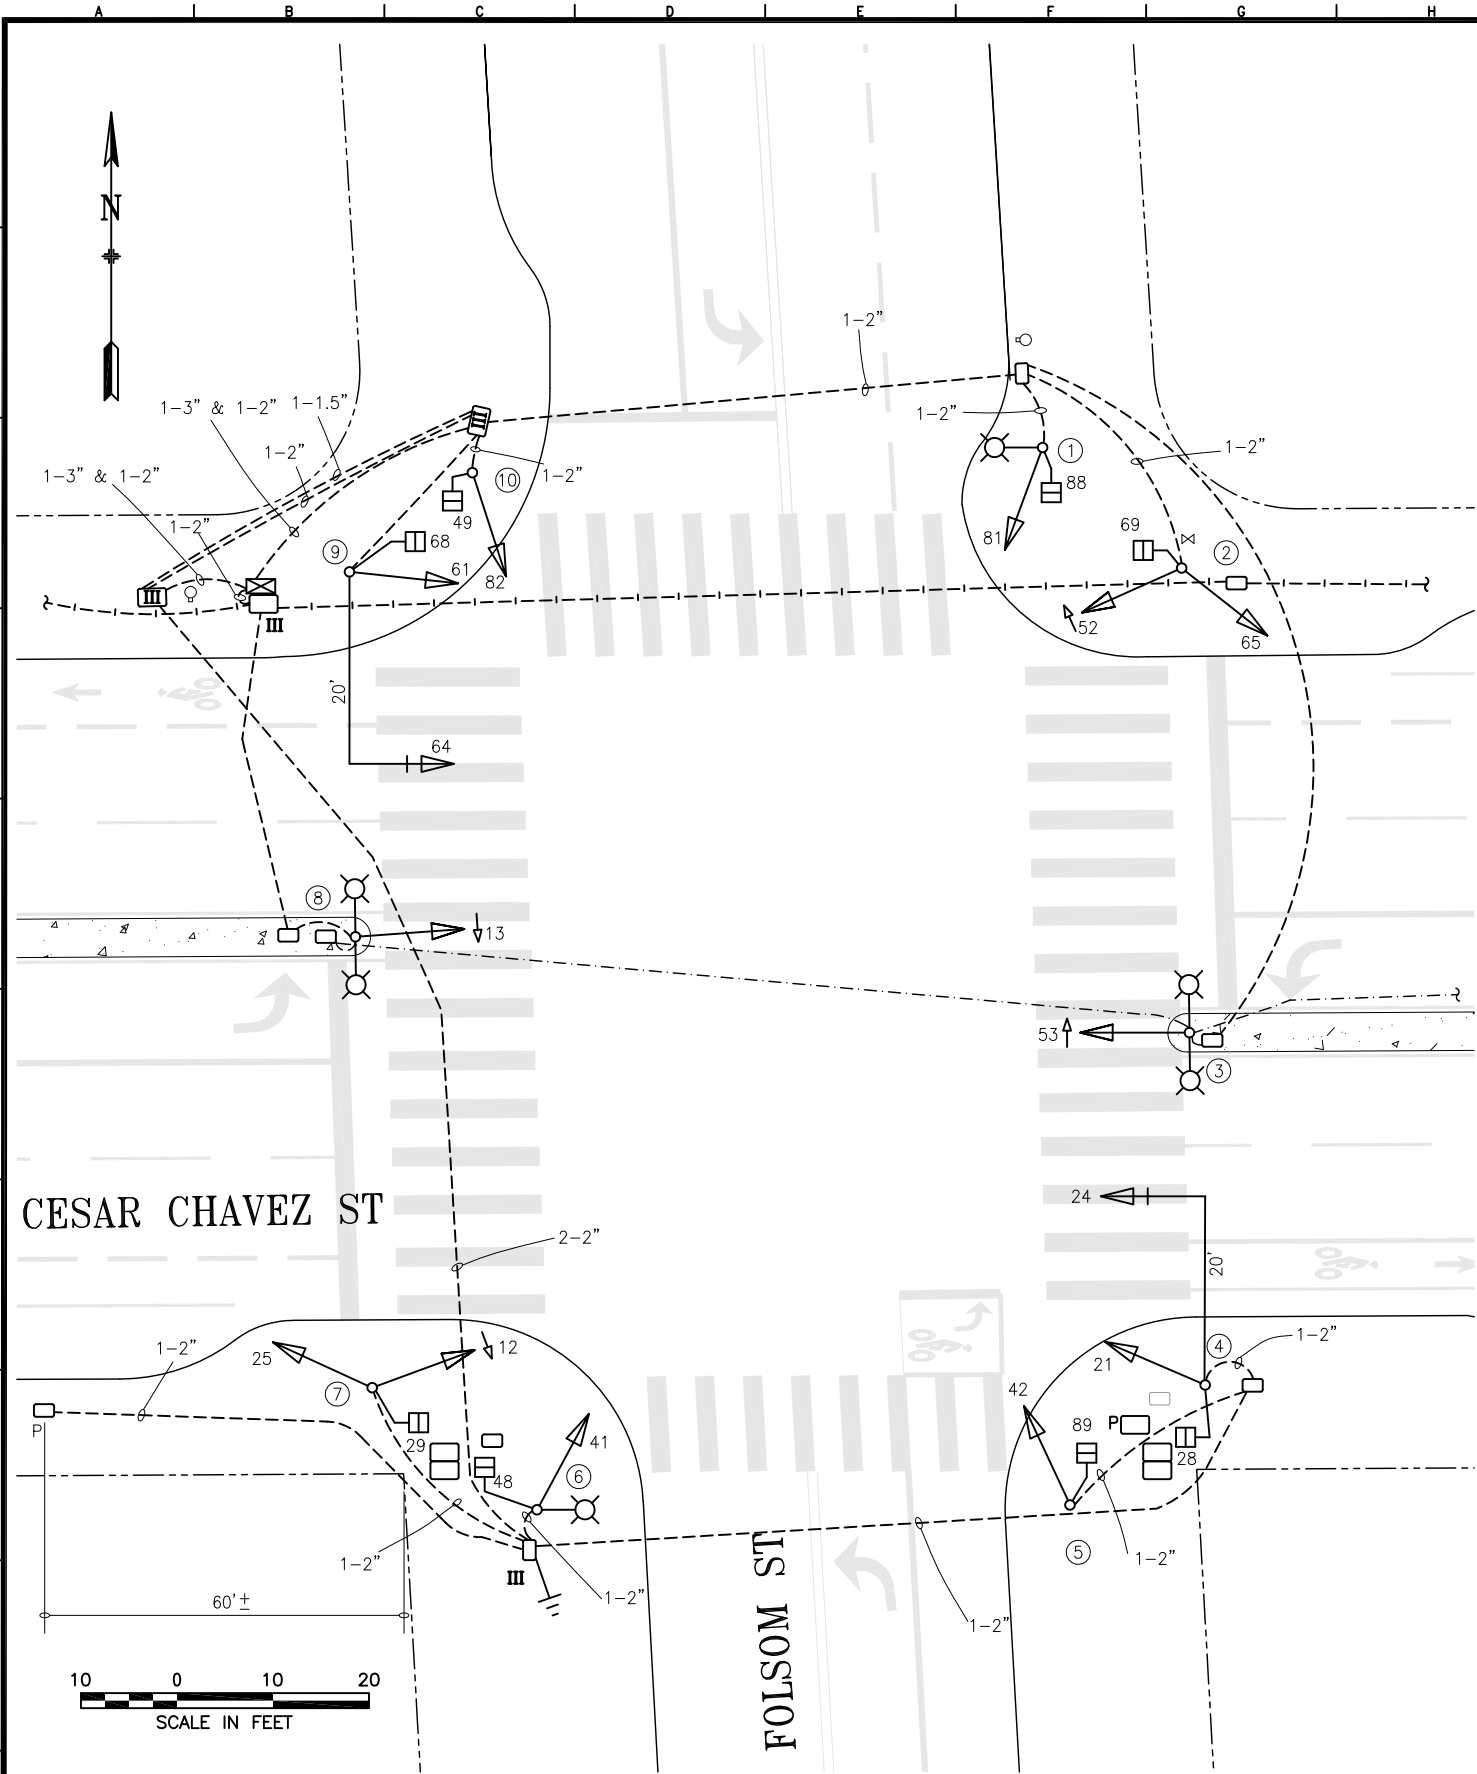

POLE AND EQUIPMENT SCHEDULE											
POLE No.	TYPE OF POLE	LUMINAIRE (HPS) VOLTAGE/ WATTS	VEHICLE SIGNAL					PEDESTRIAN SIGNAL			REMARKS
			No.	TYPE	MOUNTING	VISORS	LOUVERS/BP	No.	TYPE	MOUNTING	
①	CITY STANDARD STREET LIGHT	120V 150W	81	3S12"	SV-1-T	T		88	1S-COUNT	SP-1	
②	1-A (10')		52 65	4S12"GLA 3S12"	TV-2-T	T T		69	1S-COUNT	SP-1	
③	ORNAMENTAL STREET LIGHT		53	4S12"GLA	SV-1	T					
④	16-1-70 with 20' MASTARM		24 21	3S12" 3S12"	MAS SV-1-T	T T	BP	28	1S-COUNT	SP-1	
⑤	1-A (10')		42	3S12"	TV-1-T	T		89	1S-COUNT	SP-1	
⑥	CITY STANDARD STREET LIGHT	120V 150W	41	3S12"	SV-1-T	T		48	1S-COUNT	SP-1	
⑦	1-A (13')		12 25	3S12"LA 3S12"	TV-2-T	T T		29	1S-COUNT	SP-1	
⑧	ORNAMENTAL STREET LIGHT		13	3S12"LA	SV-1	T					
⑨	16-1-70 with 20' MASTARM		64 61	3S12" 3S12"	MAS SV-1-T	T T	BP	68	1S-COUNT	SP-1	
⑩	1-A (10')		82	3S12"	TV-1-T	T		49	1S-COUNT	SP-1	

1	3/23/23	SRC 2022-242: NEW 25, 65 & 3S12"LA WBLT. ADJUST EBLT TO 4S12". POLE 7 13'	DYeung	G de Leon
0	1/2014	SIGNAL UPGRADE ACTIVATED THRU 1068J; CONVERTED FROM 1068J & 0494J CPs	JHornbostel	G de Leon
NO.	DATE	DESCRIPTION	BY	APPROVED
TABLE OF REVISIONS CHECKOUT DRAWING THROUGH THE SID CUSTODIAN FOR THE LATEST REVISION				



SFMTA

DRAWN BY:	DATE:
JHornbostel	8/14
CHECKED BY:	DATE:
G de Leon	8/14

SCALE
AS SHOWN
SHEET OF SHEETS
1 OF 1

TRAFFIC SIGNAL INVENTORY DIAGRAM
CESAR CHAVEZ ST AND FOLSOM ST

CNN NO:
21177000
REV NO:
1