


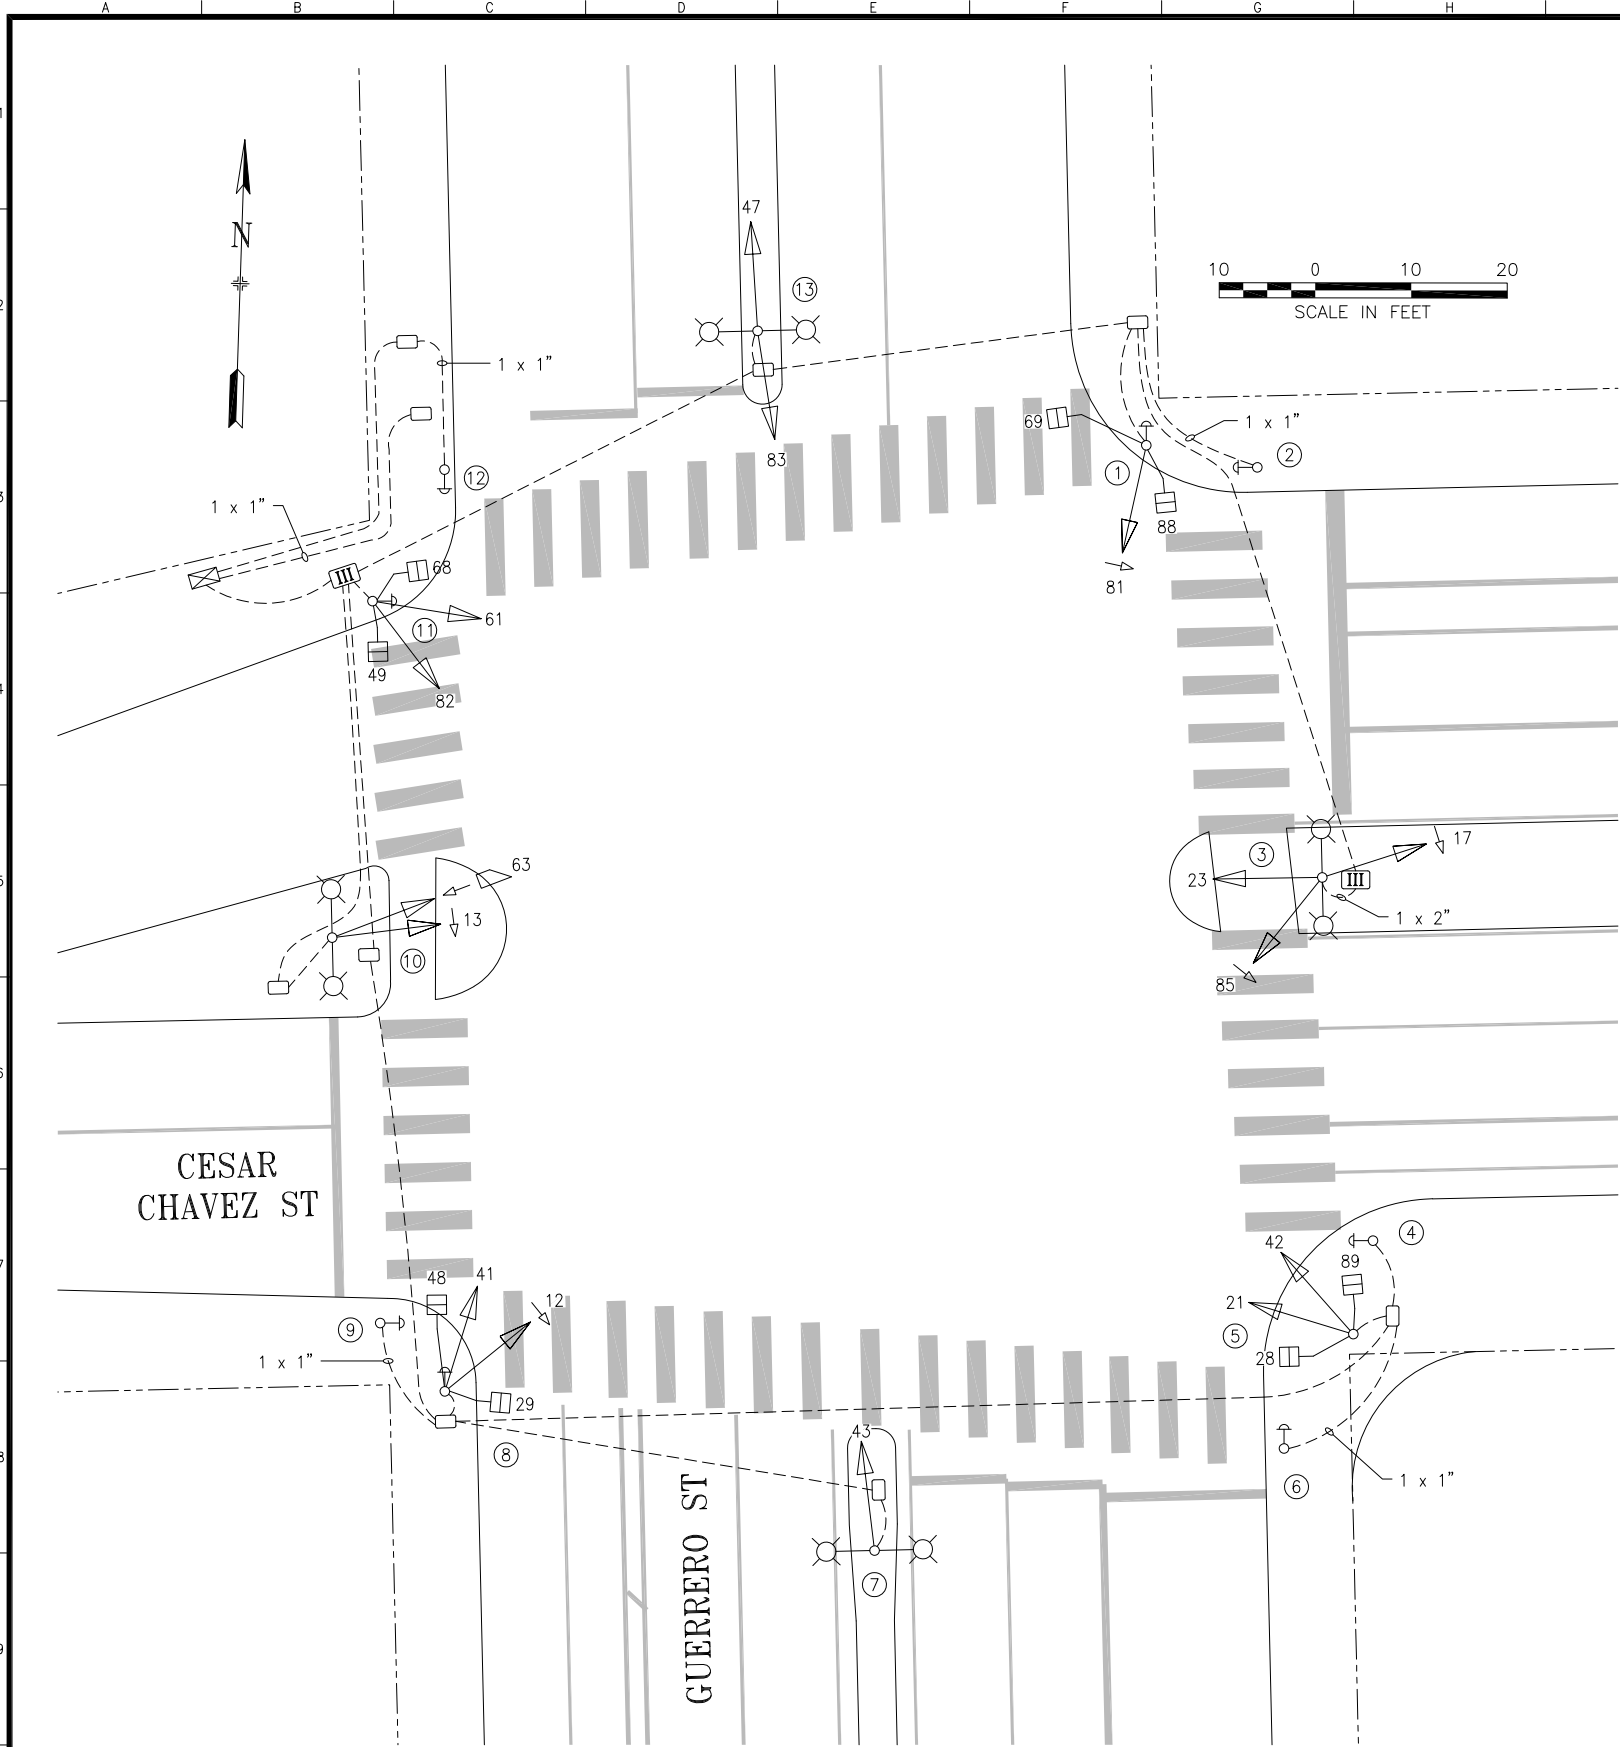

POLE AND EQUIPMENT SCHEDULE											
POLE No.	TYPE OF POLE	LUMINAIRE TYPE	VEHICLE SIGNAL					PEDESTRIAN SIGNAL			REMARKS
			No.	TYPE	MOUNTING	VISORS	LOUVERS/BP	No.	TYPE	MOUNTING	
①	1-A (10')		81	5S12"GYRA	TV-1-T	T		69 88	1S-COUNT 1S-COUNT	SP-2-T	APS-4W
②	PPB POLE										APS-4W
③	DUAL LUMINAIRE SL		17 23 85	3S12"LA 3S12" 5S12"GYRA	SV-1-T(36") SV-2-TC	T T T					17 - MOUNT @4.5', NIPPLE POINTS NORTH
④	PPB POLE										APS-4W
⑤	1-A (10')		21 42	3S12" 3S12"	TV-2-T	T T		28 89	1S-COUNT 1S-COUNT	SP-2-T	
⑥	PPB POLE										APS-4W
⑦	DUAL LUMINAIRE SL		43	3S12"	SV-1	T					
⑧	1-A (10')		12 41	3S12"LA 3S12"	TV-2-T-SFA	T T		29 48	1S-COUNT 1S-COUNT	SP-2-T	APS-4W
⑨	PPB POLE										APS-4W
⑩	DUAL LUMINAIRE SL		13 63	3S12"LA 3S12"GVA	SV-1-T SV-1-T(36")	T RT ANGLE					63 - MOUNT @17', NIPPLE POINTS NORTH
⑪	1-A (10')		61 82	3S12" 3S12"	TV-2-T	T T		49 68	1S-COUNT 1S-COUNT	SP-2-T	APS-4W
⑫	PPB POLE										APS-4W
⑬	DUAL LUMINAIRE SL		47 83	3S12" 3S12"	SV-1 SV-1	T T					

5	06/03/21	SRC 2021-024: ADD SIGNALS 47, 63; ADD 3S12"LA 12, 13, 17; REPLACE 21, 23 WITH 3S12". PER FIELD: UPDATE POLES, APS	ELUJ	G.DOLEON	REFERENCE INFORMATION & FILE NO. OF SURVEYS			
4	9/12/16	REPLACED SIGNALS 23 AND 21 WITH 4S12" GLA	JH	ET				
3	01/14	UPGRADED TO 12"; NEW POLE 2, 9, 10, 11, 12	LY	PW				
2	06/00	ADDED 12" TO 43 & 83	CXL	RO				
1	06/95	SIGNAL MODIFICATION CT22.	CXL	BW				
NO.	DATE	DESCRIPTION	BY	APP.				
TABLE OF REVISIONS								
CHECK WITH TRACING TO SEE IF YOU HAVE LATEST REVISION								



SAN FRANCISCO MUNICIPAL TRANSPORTATION AGENCY
CITY AND COUNTY OF SAN FRANCISCO

DRAWN: DATE:
CXL 07/09/99
CHECKED: DATE:

SCALE:
AS SHOWN
SHEET OF SHEETS
1 OF 1

TRAFFIC SIGNAL INVENTORY DIAGRAM		CNN NO. 21897000
CESAR CHAVEZ STREET AND GUERRERO STREET		REV NO. 5