



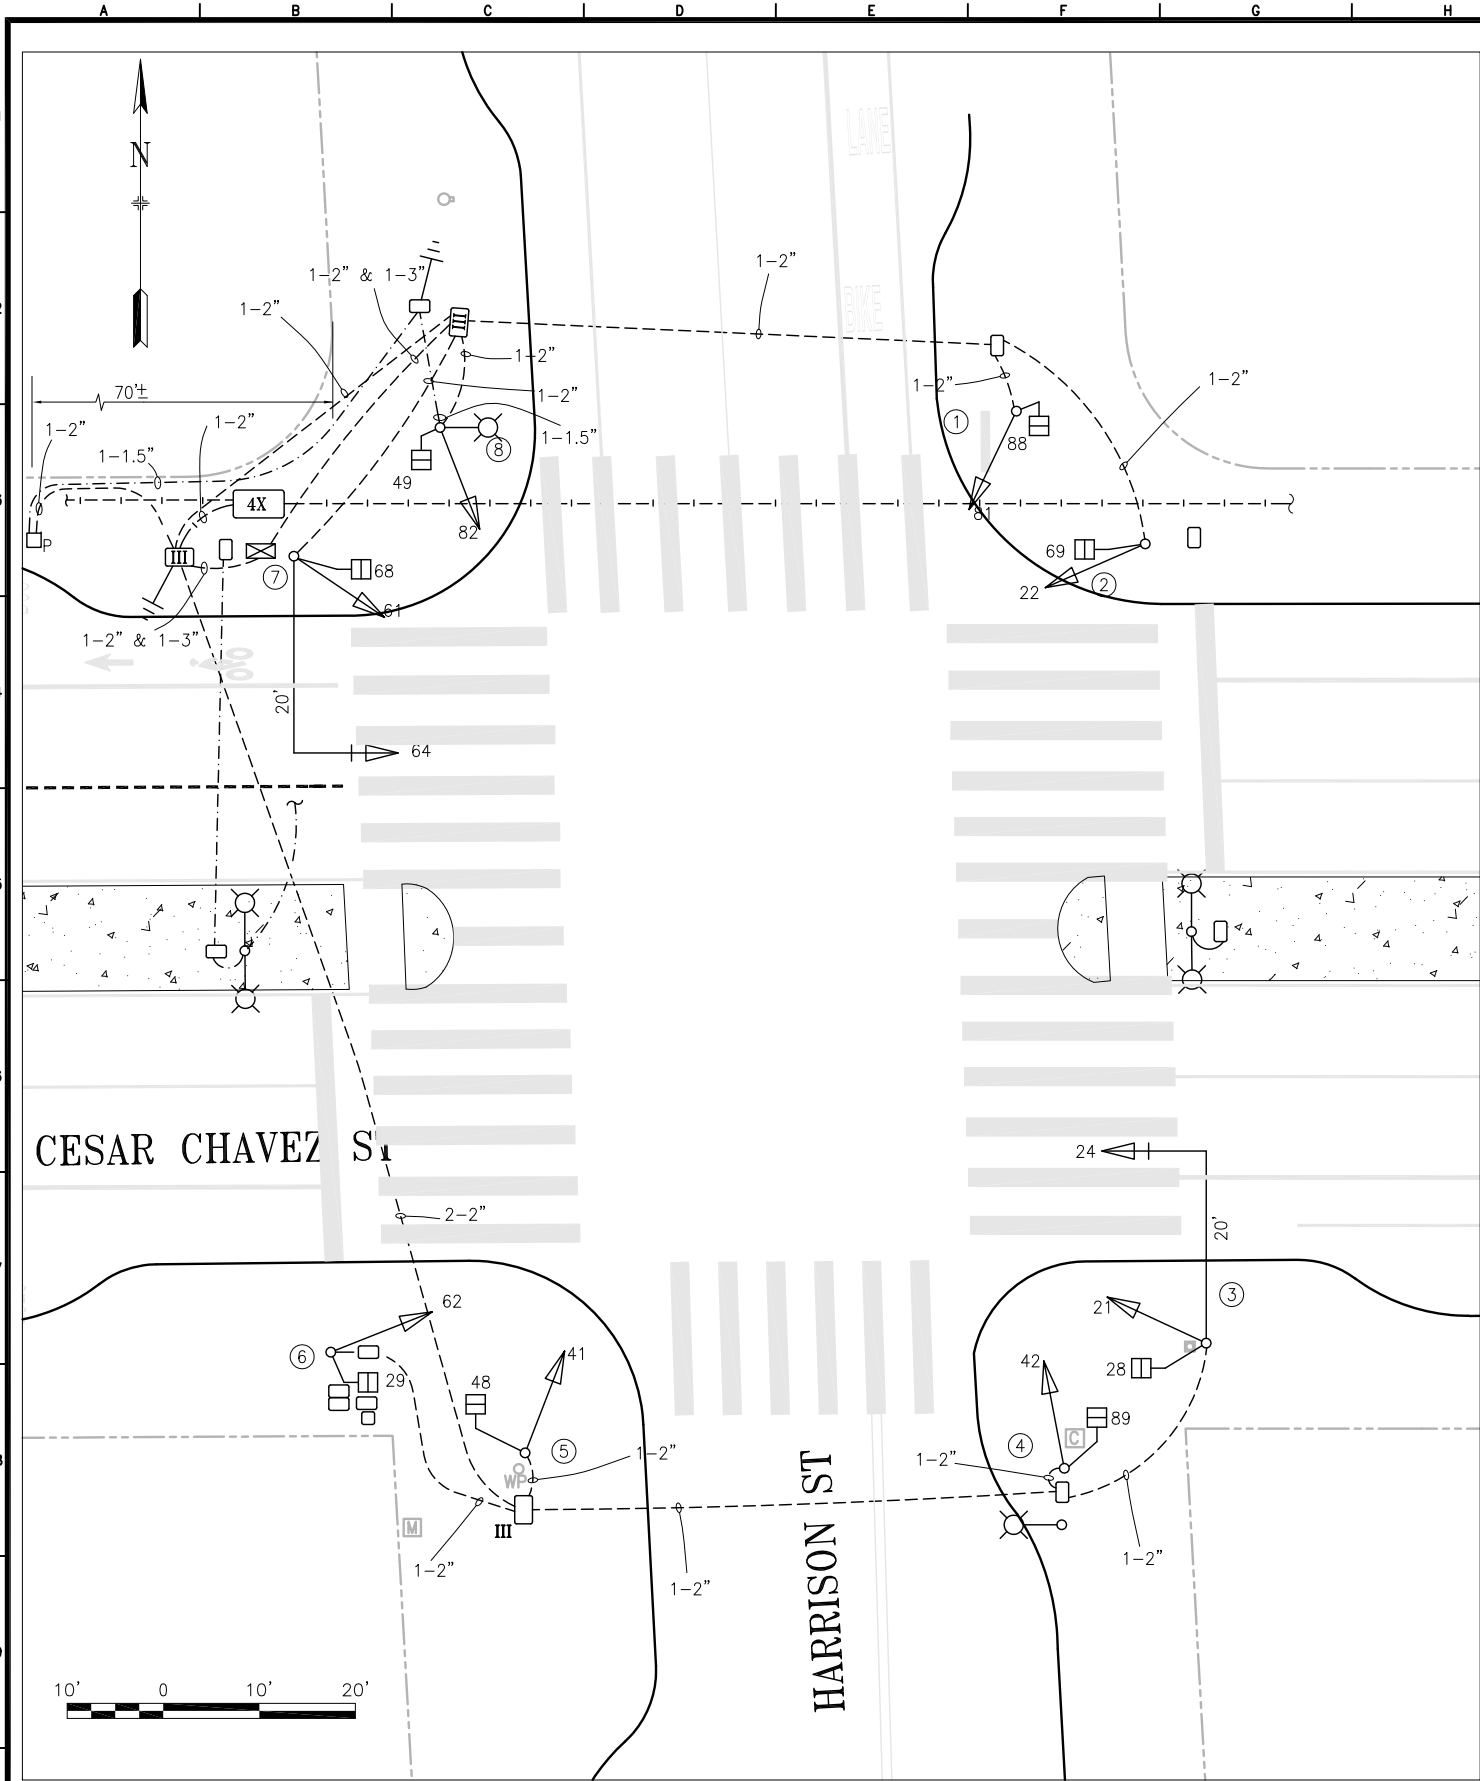

POLE AND EQUIPMENT SCHEDULE											
POLE No.	TYPE OF POLE	LUMINAIRE (HPS) VOLTAGE/ WATTS	VEHICLE SIGNAL					PEDESTRIAN SIGNAL			REMARKS
			No.	TYPE	MOUNTING	VISORS	LOUVERS	No.	TYPE	MOUNTING	
①	1-A (10')		81	3S12"	TV-1-T	T		88	1S-COUNT	SP-1	
②	1-A (10')		22	3S12"	TV-1-T	T		69	1S-COUNT	SP-1	
③	16-1-70 with 20' MASTARM		24 21	3S12" 3S12"	MAS SV-1-T	T T		28	1S-COUNT	SP-1	BACKPLATE
④	1-A (10')		42	3S12"	TV-1-T	T		89	1S-COUNT	SP-1	
⑤	1-A (10')		41	3S12"	TV-1-T	T		48	1S-COUNT	SP-1	
⑥	1-A (10')		62	3S12"	TV-1-T	T		29	1S-COUNT	SP-1	
⑦	16-1-70 with 20' MASTARM		64 61	3S12" 3S12"	MAS SV-1-T	T T		68	1S-COUNT	SP-1	BACKPLATE
⑧	CITY STANDARD STREET LIGHT	120V 150W	82	3S12"	SV-1-T	T		49	1S-COUNT	SP-1	

PHASE DIAGRAM

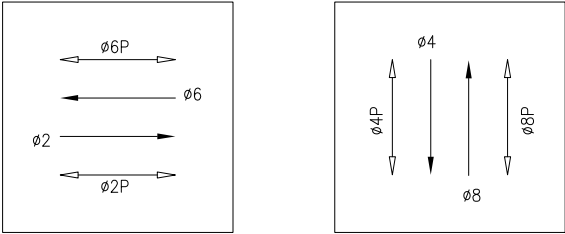

PHASE SEQUENCE

G	Y	R	CESAR CHAVEZ STREET (EB & WB) - ø2 & ø6		
R		G	Y	R	HARRISON STREET (SB & NB) - ø4 & ø8
WM	FRH	RH			PED XING HARRISON STREET (SS & NS) - ø2P & ø6P
RH		WM	FRH	RH	PED XING CESAR CHAVEZ STREET (ES & WS) - ø4P & ø8P

NO.	DATE	DESCRIPTION	BY	APP.
0	1/14	SIGNAL UPGRADE ACTIVATED THRU 1068J; CONVERTED FROM 1068J AND 0494J CPs	JH	GD
TABLE OF REVISIONS CHECK WITH TRACING TO SEE IF YOU HAVE LATEST REVISION				

REFERENCE INFORMATION
& FILE NO. OF SURVEYS



SAN FRANCISCO MUNICIPAL TRANSPORTATION AGENCY
CITY AND COUNTY OF SAN FRANCISCO

DRAWN:	DATE:
JH	8/14
CHECKED:	DATE:
GD	8/14

SCALE:

AS SHOWN

SHEET OF SHEETS

1 OF 1

TRAFFIC SIGNAL INVENTORY DIAGRAM

CESAR CHAVEZ ST AND HARRISON ST
SCHEDULE

CNN NO.

21173000

REV NO.

0