


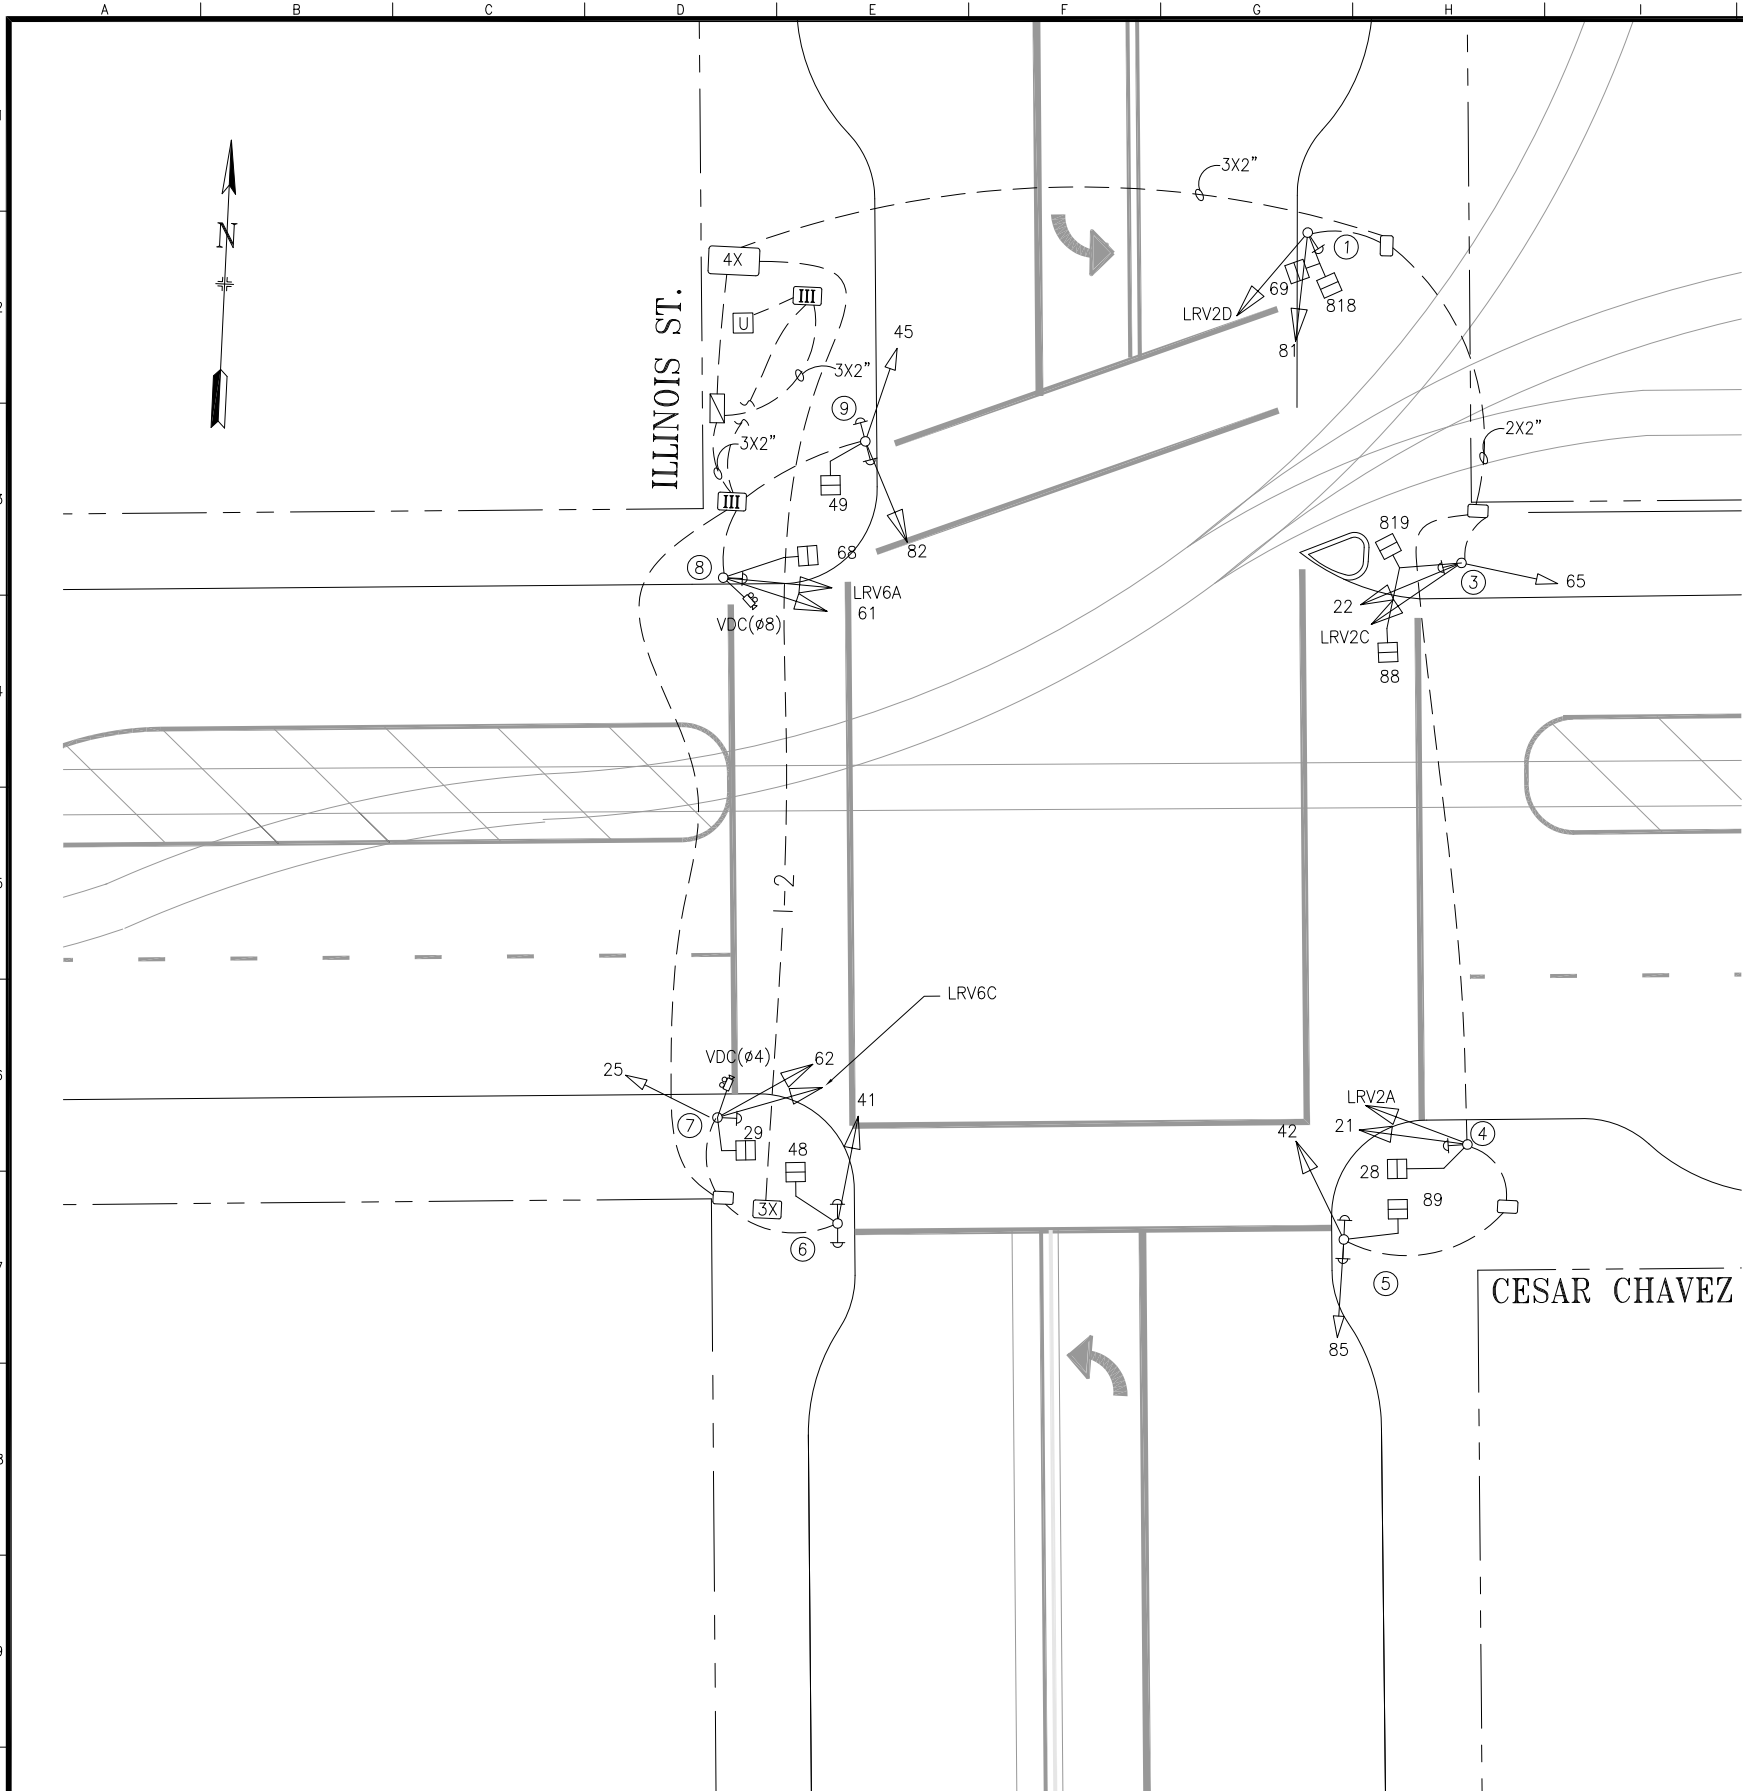

POLE AND EQUIPMENT SCHEDULE											
POLE No.	TYPE OF POLE	LUMINAIRE VOLTAGE/WATTAGE	VEHICLE SIGNAL					PEDESTRIAN SIGNAL			REMARKS
			No.	TYPE	MOUNTING	VISORS	LOUVERS	No.	TYPE	MOUNTING	
①	1-A (10')		LRV2D 81	2S12" LB 3S12"	TV-2-T			69 818	1S-COUNT 1S-COUNT	SP-1	PPB
②	REMOVED										
③	1-A (16')		22 65 LRV2C	3S12" 3S8" 2S12" LB	SV-2-T TV-1-T			88 818	1S-COUNT 1S-COUNT	SP-2-T	PPB
④	1-A (16')		21 LRV2A	3S12" 2S12" LB	SV-1 TV-1			28	1S-COUNT	SP-1	PPB
⑤	1-A (10')		42 85	3S12" 3S8"	TV-2-T			89	1S-COUNT	SP-1	PPB PPB
⑥	1-A (10')		41	3S12"	TV-1-T			48	1S-COUNT	SP-1	PPB PPB
⑦	MUNI COMBINATION		62 25 LRV6C	3S12" 3S8" 2S12" LB	SV-2-T SV-1			29	1S-COUNT	SP-1	PPB VIDEO DETECTION (ø4) SB ILLINOIS
⑧	MUNI COMBINATION		61 LRV6A	3S12" 2S12" LB	SV-1-T SV-1			68	1S-COUNT	SP-1	PPB VIDEO DETECTION (ø8) NB ILLINOIS
⑨	1-A (10')		82 45	3S12" 3S8"	TV-2-T			49	1S-COUNT	SP-1	PPB PPB

NOTES:
1. CABINET FOUNDATION TYPE: M-SF
2. SIGNALS WERE SWITCHED ON MAY 22, 2008

NO.	DATE	DESCRIPTION	BY	APP.
2	12/16/18	SRC 2018-196: CONVERT "T" TO BAR FOR SIGNALS LRV2A, LRV2C, LRV2D, LRV6A & LRV6C.	TY	MV
1	8/2014	PER FIELD: SIGNAL LRV2A (12-INCH), SIGNALS 25 & 62 (3-COLOR), POLE 2 REMOVED	TY	MV
0	5/22/08	MUNI METRO EAST PROJECT	DRP	AH
			BY	APP.
TABLE OF REVISIONS				
CHECK WITH TRACING TO SEE IF YOU HAVE LATEST REVISION				

COMPLETION DATE /
ELECTRICIAN INITIAL



DEPARTMENT OF PARKING AND TRAFFIC
DIVISION OF TRAFFIC ENGINEERING
CITY AND COUNTY OF SAN FRANCISCO

DRAWN: DATE: SCALE:

DRP 06/5/08 1" = 10'

CHECKED: DATE: SHEET OF SHEETS

AH 06/5/08 1 OF 1

TRAFFIC SIGNAL INVENTORY DIAGRAM

CESAR CHAVEZ STREET AND ILLINOIS STREET

CNN NO.

23548000

REV. NO.

2