


CEGAR CHAVEZ KANSAS

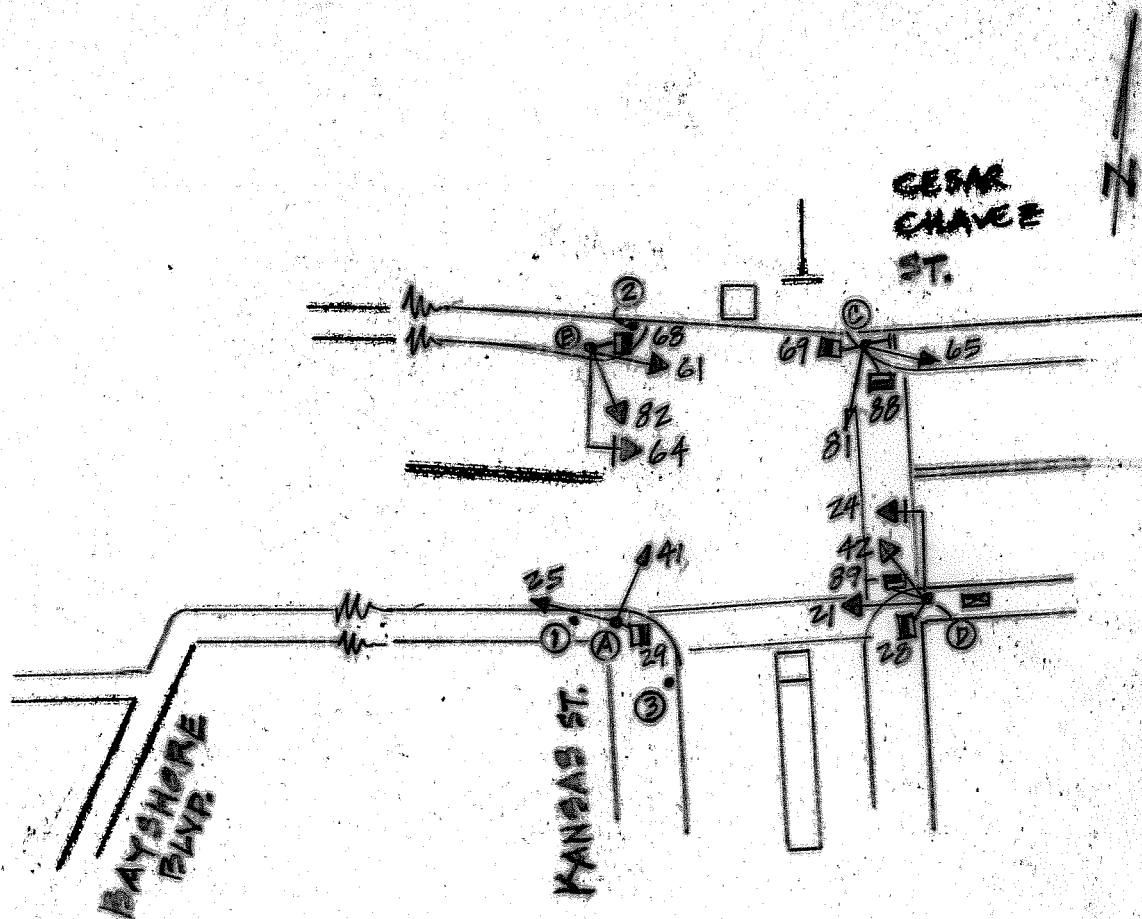

K-28-15

POLE	FUNC	MATL	SIGNAL NO.	MAKE	NO. OF SECT.	SIZE	VISOR	B.P. OR LOUVERS	MOUNT	PED SIGNAL NO.	LEGEND	MESSAGE		MAKE	MOUNT
												ELEMENT	COLOR		
A	S	S	21	ECO	3	8"	FC 8"	NO	S	28	I	15-1	W/O	ICC	S
B	L	S	24	ECO	3	12"	FC 12"	B.P.	MAS	29	I	15-1	W/O	ICC	S
C	S	S	25	ECO	3	8"	FC 8"	NO	T	68	I	15-1	W/O	ICC	S
D	L	S	41	ECO	3	8"	FC 8"	NO	T	69	I	15-1	W/O	ICC	S
			42	ECO	3	8"	FC 8"	NO	S	88	I	15-1	W/O	ICC	S
			61	ECO	3	8"	FC 8"	NO	S	89	I	15-1	W/O	ICC	S
			64	ECO	3	12"	FC 12"	B.P.	MAS						
①	L	S	65	ECO	3	8"	FC 8"	NO	T						
②	U	W	81	ECO	3	8"	FC 8"	NO	T						
③	U	W	82	ECO	3	8"	FC 8"	NO	S						
			91	ECO	1	12"	FC 12"	B.P.	T						
			92	ECO	1	12"	FC 12"	B.P.	T						

CONTROLLER CABINET SIZE : M BASE CABINET : —

COMMENTS : SRC 2013-333

REMOVE YELLOW BEACONS ON NB BAYSHORE AND EB CESAR CHAVEZ