


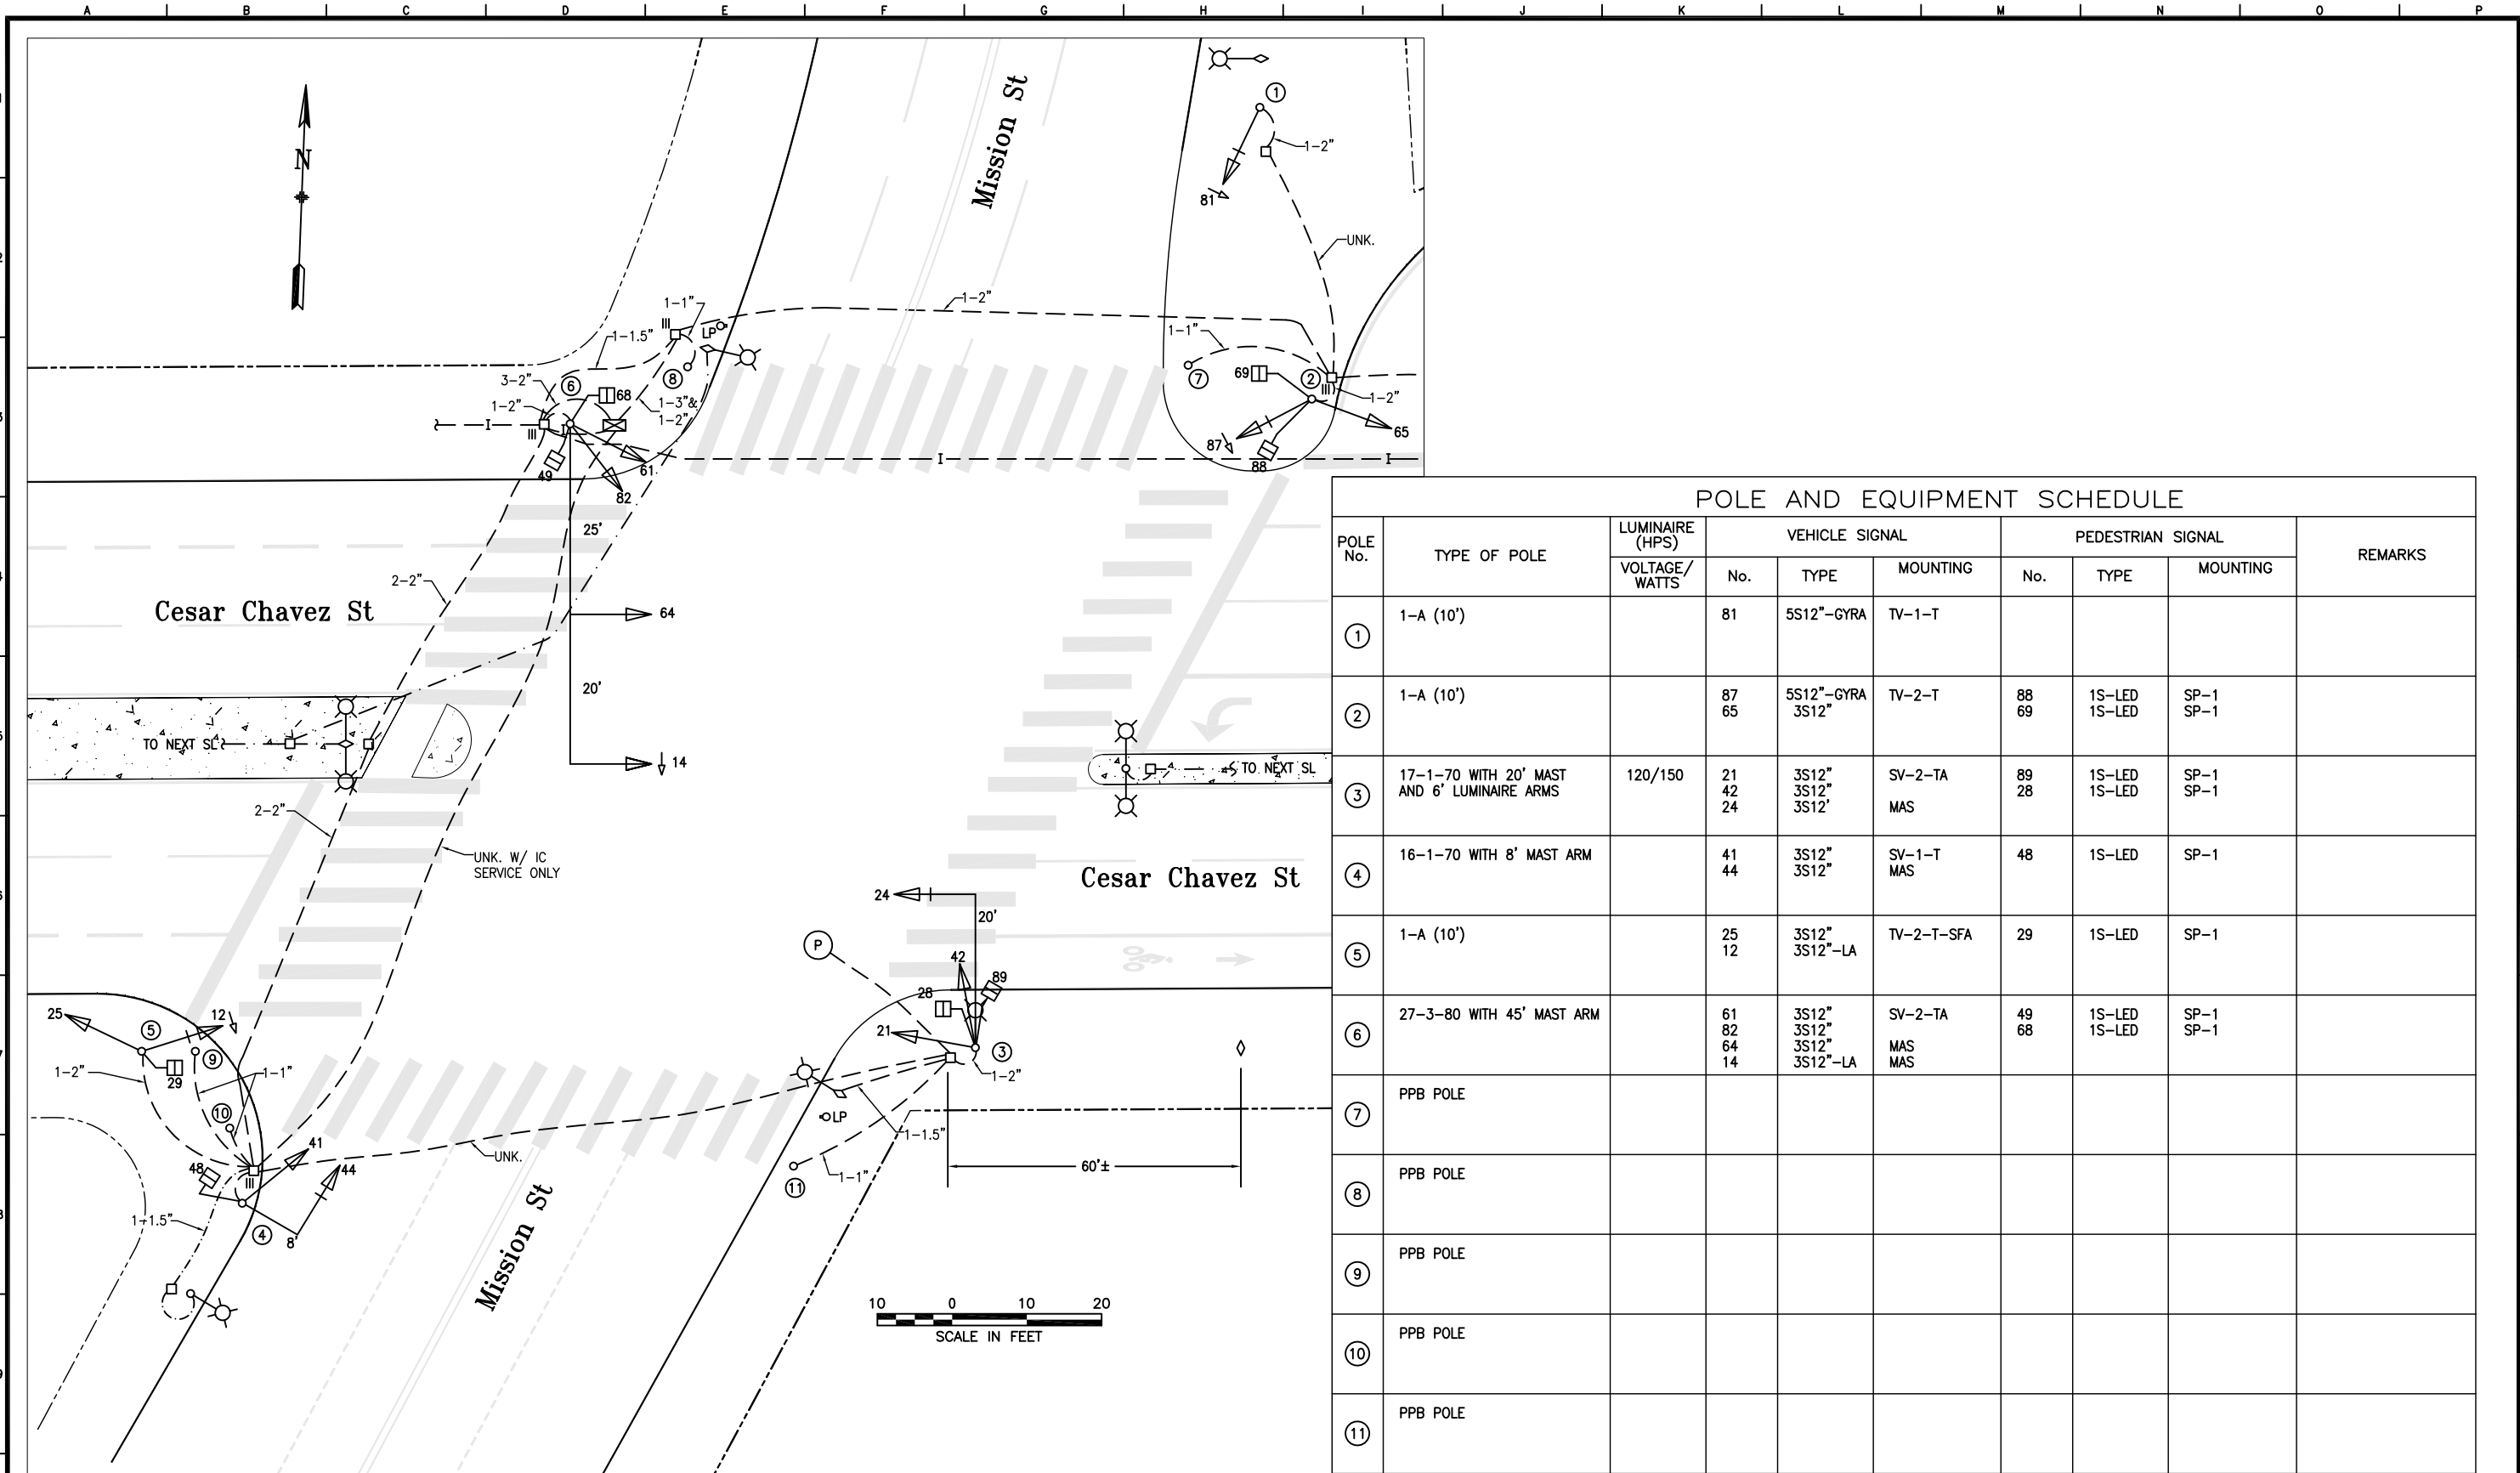

POLE AND EQUIPMENT SCHEDULE									
POLE No.	TYPE OF POLE	LUMINAIRE (HPS)	VEHICLE SIGNAL			PEDESTRIAN SIGNAL			REMARKS
		VOLTAGE/ WATTS	No.	TYPE	MOUNTING	No.	TYPE	MOUNTING	
①	1-A (10')		81	5S12"-GYRA	TV-1-T				
②	1-A (10')		87 65	5S12"-GYRA 3S12"	TV-2-T	88 69	1S-LED 1S-LED	SP-1 SP-1	
③	17-1-70 WITH 20' MAST AND 6' LUMINAIRE ARMS	120/150	21 42 24	3S12" 3S12" 3S12'	SV-2-TA MAS	89 28	1S-LED 1S-LED	SP-1 SP-1	
④	16-1-70 WITH 8' MAST ARM		41 44	3S12" 3S12"	SV-1-T MAS	48	1S-LED	SP-1	
⑤	1-A (10')		25 12	3S12" 3S12"-LA	TV-2-T-SFA	29	1S-LED	SP-1	
⑥	27-3-80 WITH 45' MAST ARM		61 82 64 14	3S12" 3S12" 3S12" 3S12"-LA	SV-2-TA MAS MAS	49 68	1S-LED 1S-LED	SP-1 SP-1	
⑦	PPB POLE								
⑧	PPB POLE								
⑨	PPB POLE								
⑩	PPB POLE								
⑪	PPB POLE								

NO.	DATE	DESCRIPTION	BY	APP.
1	4/5/16	SRC 2016-069: REPLACED 3S12" W/5S12"GYRA ON POLES 1 & 2	LV	MV
0	01/2014	SIGNAL UPGRADE ACTIVATED THRU 1068J; CONVERTED FROM 1068J AND 1987N GPS	JH	MV
TABLE OF REVISIONS CHECK WITH TRACING TO SEE IF YOU HAVE LATEST REVISION				

REFERENCE INFORMATION & FILE NO. OF SURVEYS



SAN FRANCISCO MUNICIPAL TRANSPORTATION AGENCY
CITY AND COUNTY OF SAN FRANCISCO

DRAWN:	DATE:
JH	12/2014
CHECKED:	DATE:
MV	12/2014

SCALE:
AS SHOWN
SHEET OF SHEETS
01 OF 01

TRAFFIC SIGNAL INVENTORY DIAGRAM
CESAR CHAVEZ AND MISSION STREETS

CNN NO.
21304000
REV NO.