


REFER TO DWG. C-E-2.1  
REFER TO DWG. C-E-2.2

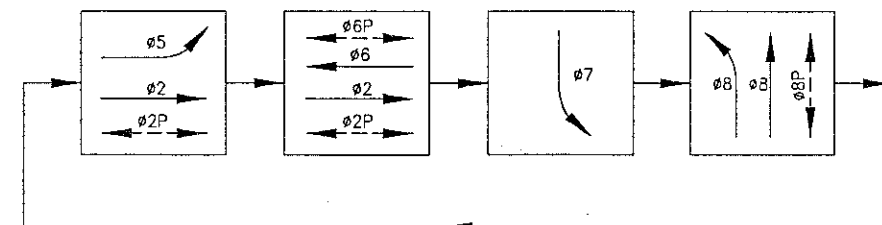

STEADY DEMAND SEQUENCE  
PHASE DIAGRAM  
(EXISTING TO REMAIN)

REFERENCE INFORMATION & FILE NO. OF SURVEYS			
1	3-3-22	CHANGE PPB TO APS PER SRC 2021-308	D.Yeung G. de Leon
NO.	DATE	DESCRIPTION	BY APP.
TABLE OF REVISIONS			
CHECK WITH TRACING TO SEE IF YOU HAVE LATEST REVISION			

**BUREAU OF ENGINEERING**  
**DEPARTMENT OF PUBLIC WORKS**  
**CITY AND COUNTY OF SAN FRANCISCO**

DESIGNED: JM	DATE: 5/97	APPROVED:	DATE:
DRAWN: DB/EF/JS	DATE: 5/97	SECTION MANAGER:	DATE:
CHECKED: HLK	DATE: 5/97	DIVISION MANAGER:	DATE:
		CITY ENGINEER:	DATE:

SCALE:	1"=20'-0"
SHEET OF SHEETS:	53 OF 88

SAN FRANCISCO  
CESAR CHAVEZ WIDENING AND  
BAYSHORE CHANNELIZATION PROJECTS  
TRAFFIC SIGNAL IMPROVEMENTS  
CESAR CHAVEZ ST./PENNSYLVANIA AVE.

SPECIFICATION NO.	1109N
DRAWING NO.	C-E-2
FILE NO.	66,172
REV. NO.	1



CONC ABUTMENT WALL  
AC WALK

CESAR CHAVEZ STREET

PENNSYLVANIA AVE.

STATE RIGHT OF WAY LINE  
RECORD MAP 174.8

EX CALTRANS  
TRAFFIC OPERATION SYSTEM (TOS)

MATCH LINE 'A', SEE DWG. C-E-2.2

**SHEET NOTES:**

1. THE EXISTING CALTRANS OPERATING SYSTEM SHALL BE PROTECTED. ANY INTERRUPTION AND/OR DAMAGE SHALL BE THE RESPONSIBILITY OF THE CONTRACTOR.

**DETAIL NOTES:**

- B EX CONDUIT AND WIRING. R/C EX WIRING. ABANDON CONDUIT IN PLACE.
- K R/C EX WIRES EXCEPT CALTRANS SERVICE WIRES.
- M F/I 40A FUSE AND WATER PROOF FUSE BOOT FOR TRAFFIC SIGNAL SERVICE.
- N R/C EX PULL BOX, RESTORE SIDEWALK OR PAVEMENT TO MATCH EX OR NEW CONDITION.
- T R/C EX WIRES EXCEPT STREET LIGHT WIRES. F/I WIRING AS SHOWN ON SCHEDULE.

DRAWING INFORMATION:  
FILE NAME: C-E-2.1  
ORIGIN: ELECTRICAL  
DATE: --/--/--

LIMITS: (0,0), (34',22')  
PLOT SCALE: 1"=120'

REFERENCE INFORMATION & FILE No. OF SURVEYS			
1	3-3-22	CHANGE PPB TO APS PER SRC 2021-308	D. Yeung, G. de Leon
NO.	DATE	DESCRIPTION	BY APP.
TABLE OF REVISIONS			
CHECK WITH TRACING TO SEE IF YOU HAVE LATEST REVISION			

**BUREAU OF ENGINEERING**  
**DEPARTMENT OF PUBLIC WORKS**  
**CITY AND COUNTY OF SAN FRANCISCO**


DESIGNED: JM  
DATE: 5/97  
DRAWN: DB/EF/RT  
DATE: 5/97  
CHECKED: HLK  
DATE: 5/97

APPROVED  
SECTION MANAGER  
DATE:  
DIVISION MANAGER  
DATE:  
CITY ENGINEER  
DATE:

SCALE:  
1"=10'-0"  
SHEET OF SHEETS  
54 OF 88

SAN FRANCISCO  
CESAR CHAVEZ WIDENING AND  
BAYSHORE CHANNELIZATION PROJECTS  
TRAFFIC SIGNAL IMPROVEMENTS  
CESAR CHAVEZ ST./PENNSYLVANIA AVE.

SPECIFICATION NO.  
1109N  
DRAWING NO.  
C-E-2.1  
FILE NO.  
66,173  
REV. NO.  
1

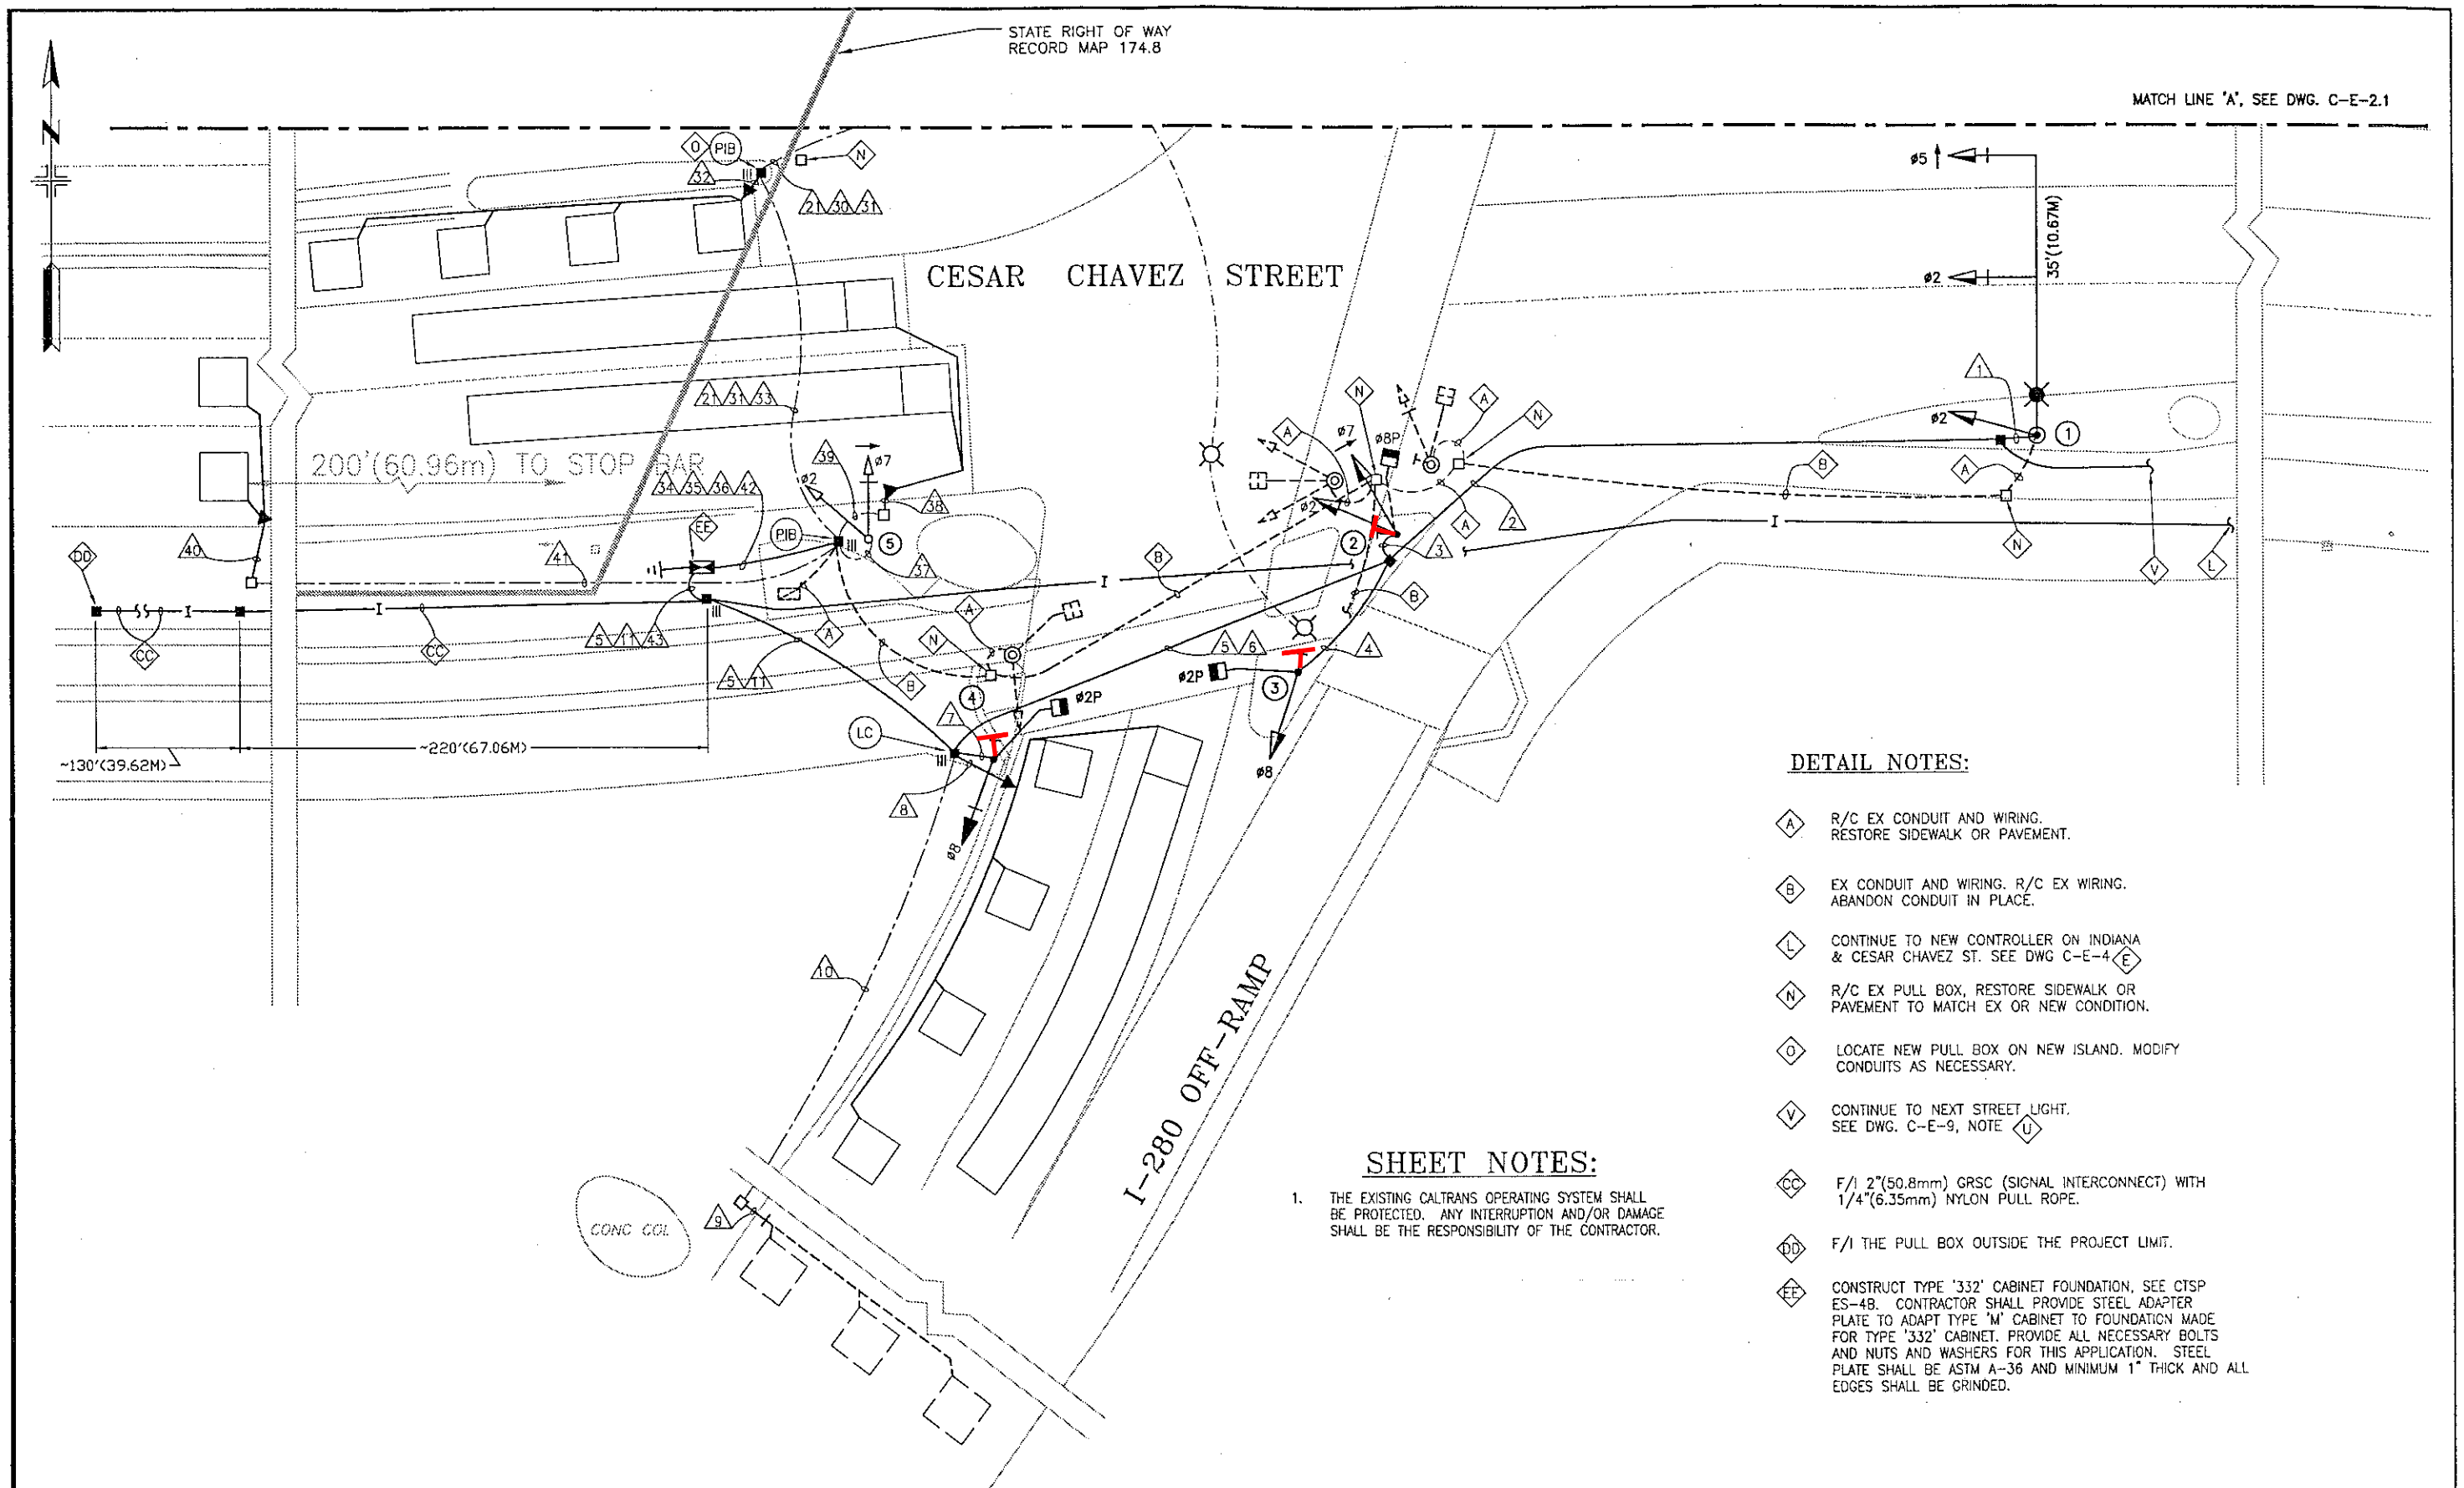

																																																																																																																																																																																																																																																																																																																																																																																																																																																																																																																																																																																																																																																																																																																																																																																																																																																																																																																																																																																																																																																																																																																																																																																																																																																																																																																																																																																																																					</
--	--	----

[illegible]

				REFERENCE INFORMATION & FILE No. OF SURVEYS		<p align="center"><b>BUREAU OF ENGINEERING</b></p> <p align="center"><b>DEPARTMENT OF PUBLIC WORKS</b></p> <p align="center"><b>CITY AND COUNTY OF SAN FRANCISCO</b></p>		DESIGNED: DATE: JM 5/97		APPROVED		SCALE: NONE		SPECIFICATION NO. 1109N	
								DRAWN: DATE: DB/JS 5/97		SECTION MANAGER DATE:				DRAWING NO. C-E-3	
								CHECKED: DATE: HLK 5/97		DIVISION MANAGER DATE:				FILE NO. 66,175	
										CITY ENGINEER DATE:				REV. NO.	
NO.		DATE		DESCRIPTION		BY		APP.				SHEET OF SHEETS 56 OF 88		<p align="center"><b>SAN FRANCISCO</b></p> <p align="center"><b>CESAR CHAVEZ WIDENING AND</b></p> <p align="center"><b>BAYSHORE CHANNELIZATION PROJECTS</b></p> <p align="center"><b>TRAFFIC SIGNAL IMPROVEMENTS</b></p> <p align="center"><b>CESAR CHAVEZ ST./PENNSYLVANIA ST.</b></p> <p align="center"><b>SCHEDULE</b></p>	
<p align="center">TABLE OF REVISIONS</p> <p align="center">CHECK WITH TRACING TO SEE IF YOU HAVE LATEST REVISION</p>															