



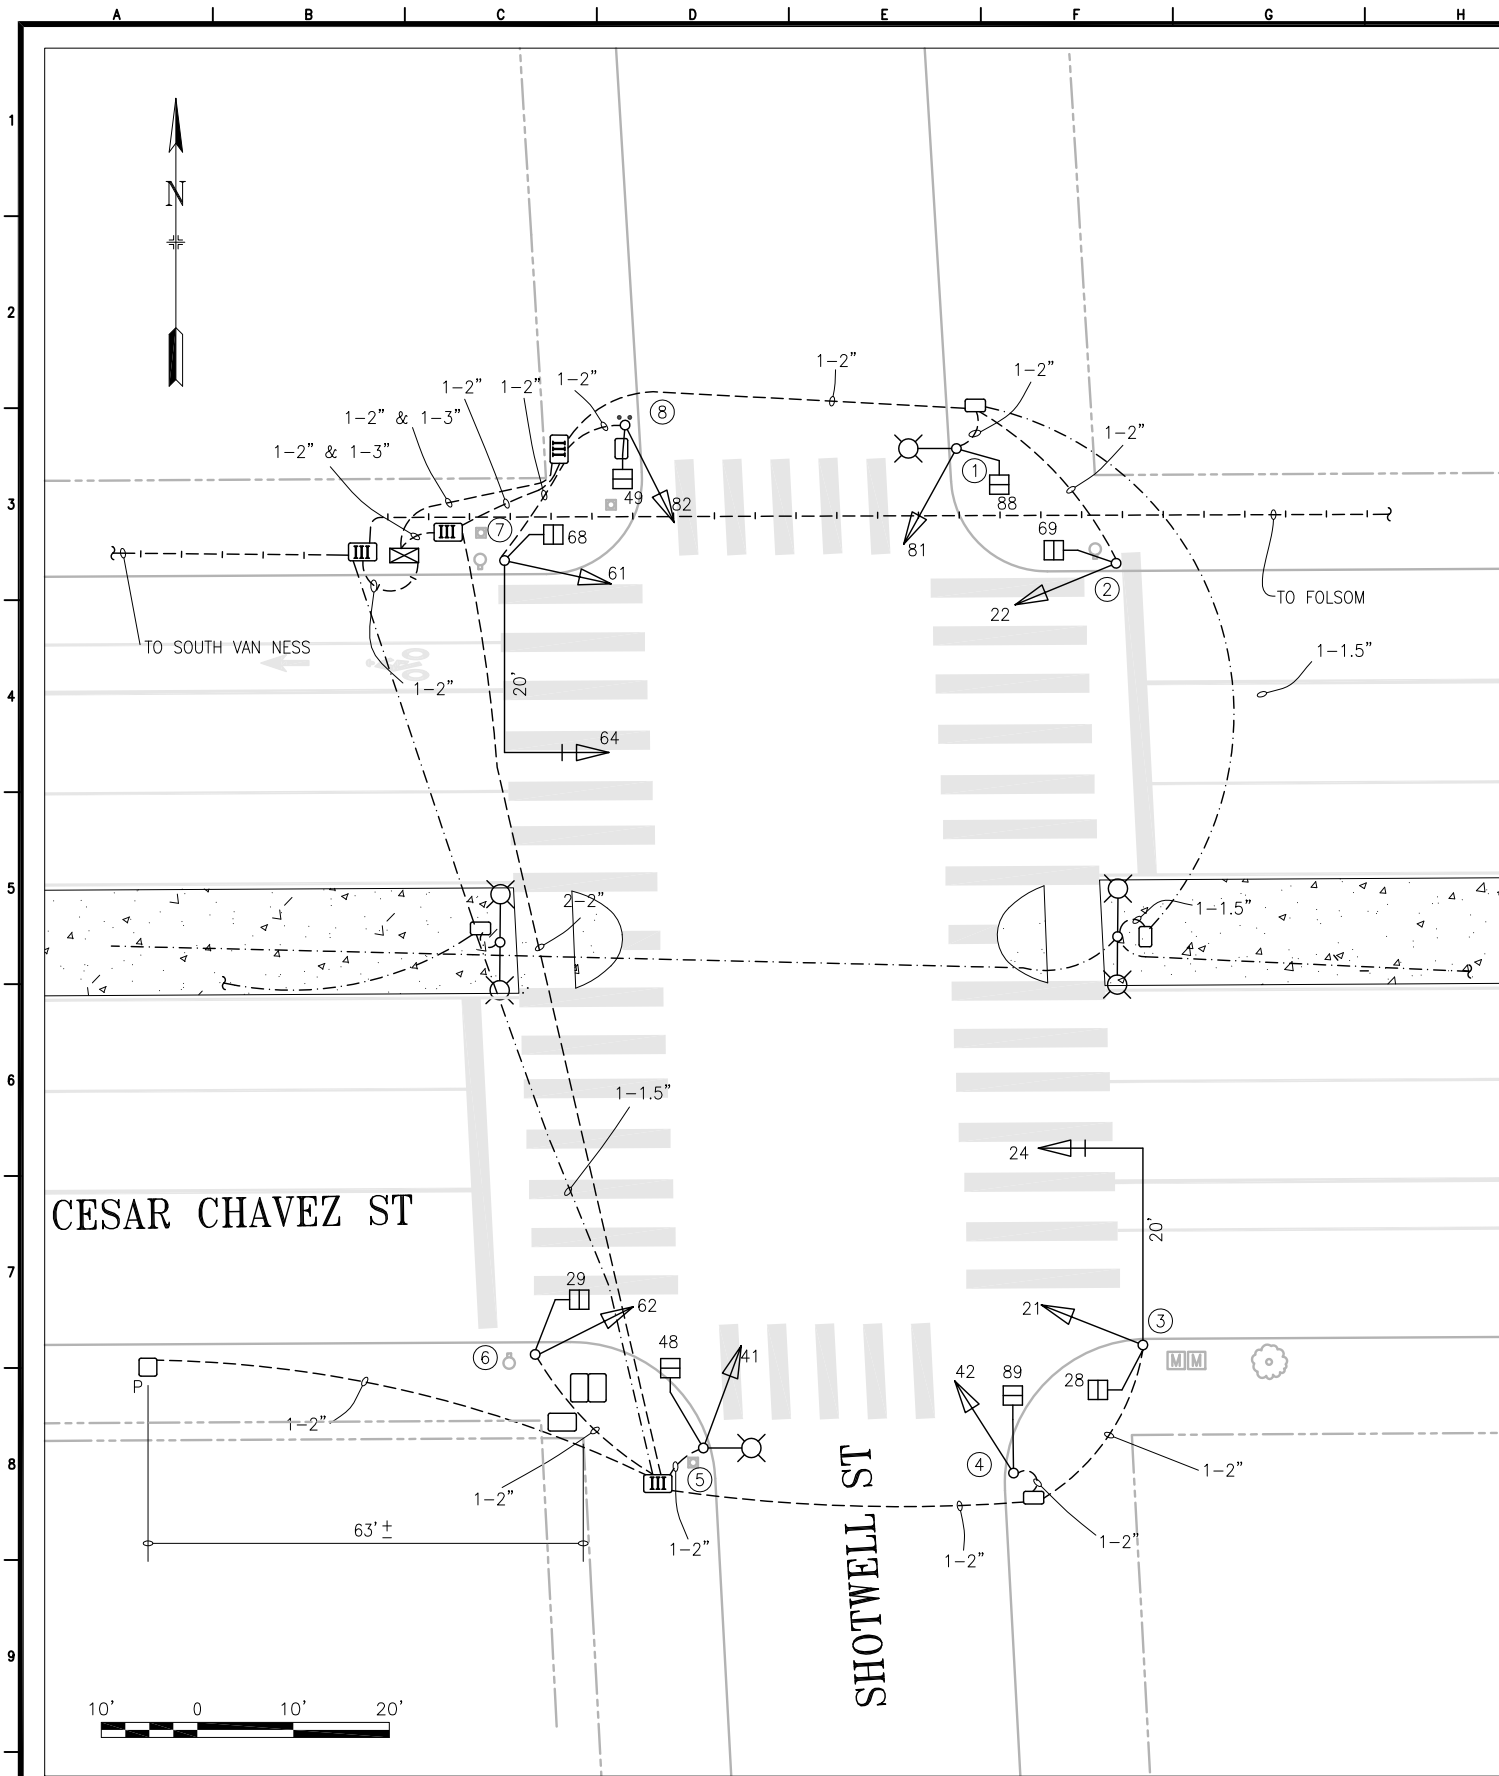

POLE AND EQUIPMENT SCHEDULE										
POLE No.	TYPE OF POLE	LUMINAIRE (HPS) VOLTAGE/ WATTS	VEHICLE SIGNAL					PEDESTRIAN SIGNAL		
			No.	TYPE	MOUNTING	VISORS	LOUVERS	No.	TYPE	MOUNTING
①	CITY STANDARD STREET LIGHT	120V 100W	81	3S12"	SV-1-T	T		88	1S-COUNT	SP-1
②	1-A (10')		22	3S12"	TV-1-T	T		69	1S-COUNT	SP-1
③	16-1-70 with 20' MASTARM		24 21	3S12" 3S12"	MAS SV-1-T	T T		28	1S-COUNT	SP-1
④	1-A (10')		42	3S12"	TV-1-T	T		89	1S-COUNT	SP-1
⑤	CITY STANDARD STREET LIGHT	120V 100W	41	3S12"	SV-1-T	T		48	1S-COUNT	SP-1
⑥	1-A (10')		62	3S12"	TV-1-T	T		29	1S-COUNT	SP-1
⑦	16-1-70 with 20' MASTARM		64 61	3S12" 3S12"	MAS SV-1-T	T T		68	1S-COUNT	SP-1
⑧	1-A (10')		82	3S12"	TV-1-T	T		49	1S-COUNT	SP-1
										REMARKS
										BACKPLATE
										BACKPLATE

PHASE DIAGRAM

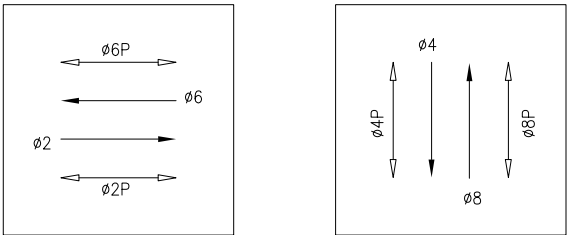

PHASE SEQUENCE

G	Y	R	CESAR CHAVEZ ST (EB & WB) - ø2 & ø6	
R		G	Y	R
WM		FRH	SHOTWELL ST (NB & SB) - ø4 & ø8	
RH		RH	PED XING SHOTWELL ST (NS & SS) - ø2P & ø6P	
RH		WM	FRH	RH
		PED XING CESAR CHAVEZ ST (WS & ES) - ø4P & ø8P		

0	1/14	SIGNAL UPGRADE ACTIVATED THRU 1068J; CONVERTED FROM 1068J AND 0494J CPs		JH	GD
NO.	DATE	DESCRIPTION		BY	APP.
TABLE OF REVISIONS CHECK WITH TRACING TO SEE IF YOU HAVE LATEST REVISION					

REFERENCE INFORMATION
& FILE NO. OF SURVEYS



SAN FRANCISCO MUNICIPAL TRANSPORTATION AGENCY
CITY AND COUNTY OF SAN FRANCISCO

DRAWN:	DATE:
JH	8/14
CHECKED:	DATE:
GD	8/14

SCALE:

AS SHOWN

SHEET OF SHEETS

1 OF 1

TRAFFIC SIGNAL INVENTORY DIAGRAM

CESAR CHAVEZ ST AND SHOTWELL ST

CNN NO.

21290000

REV NO.

0