


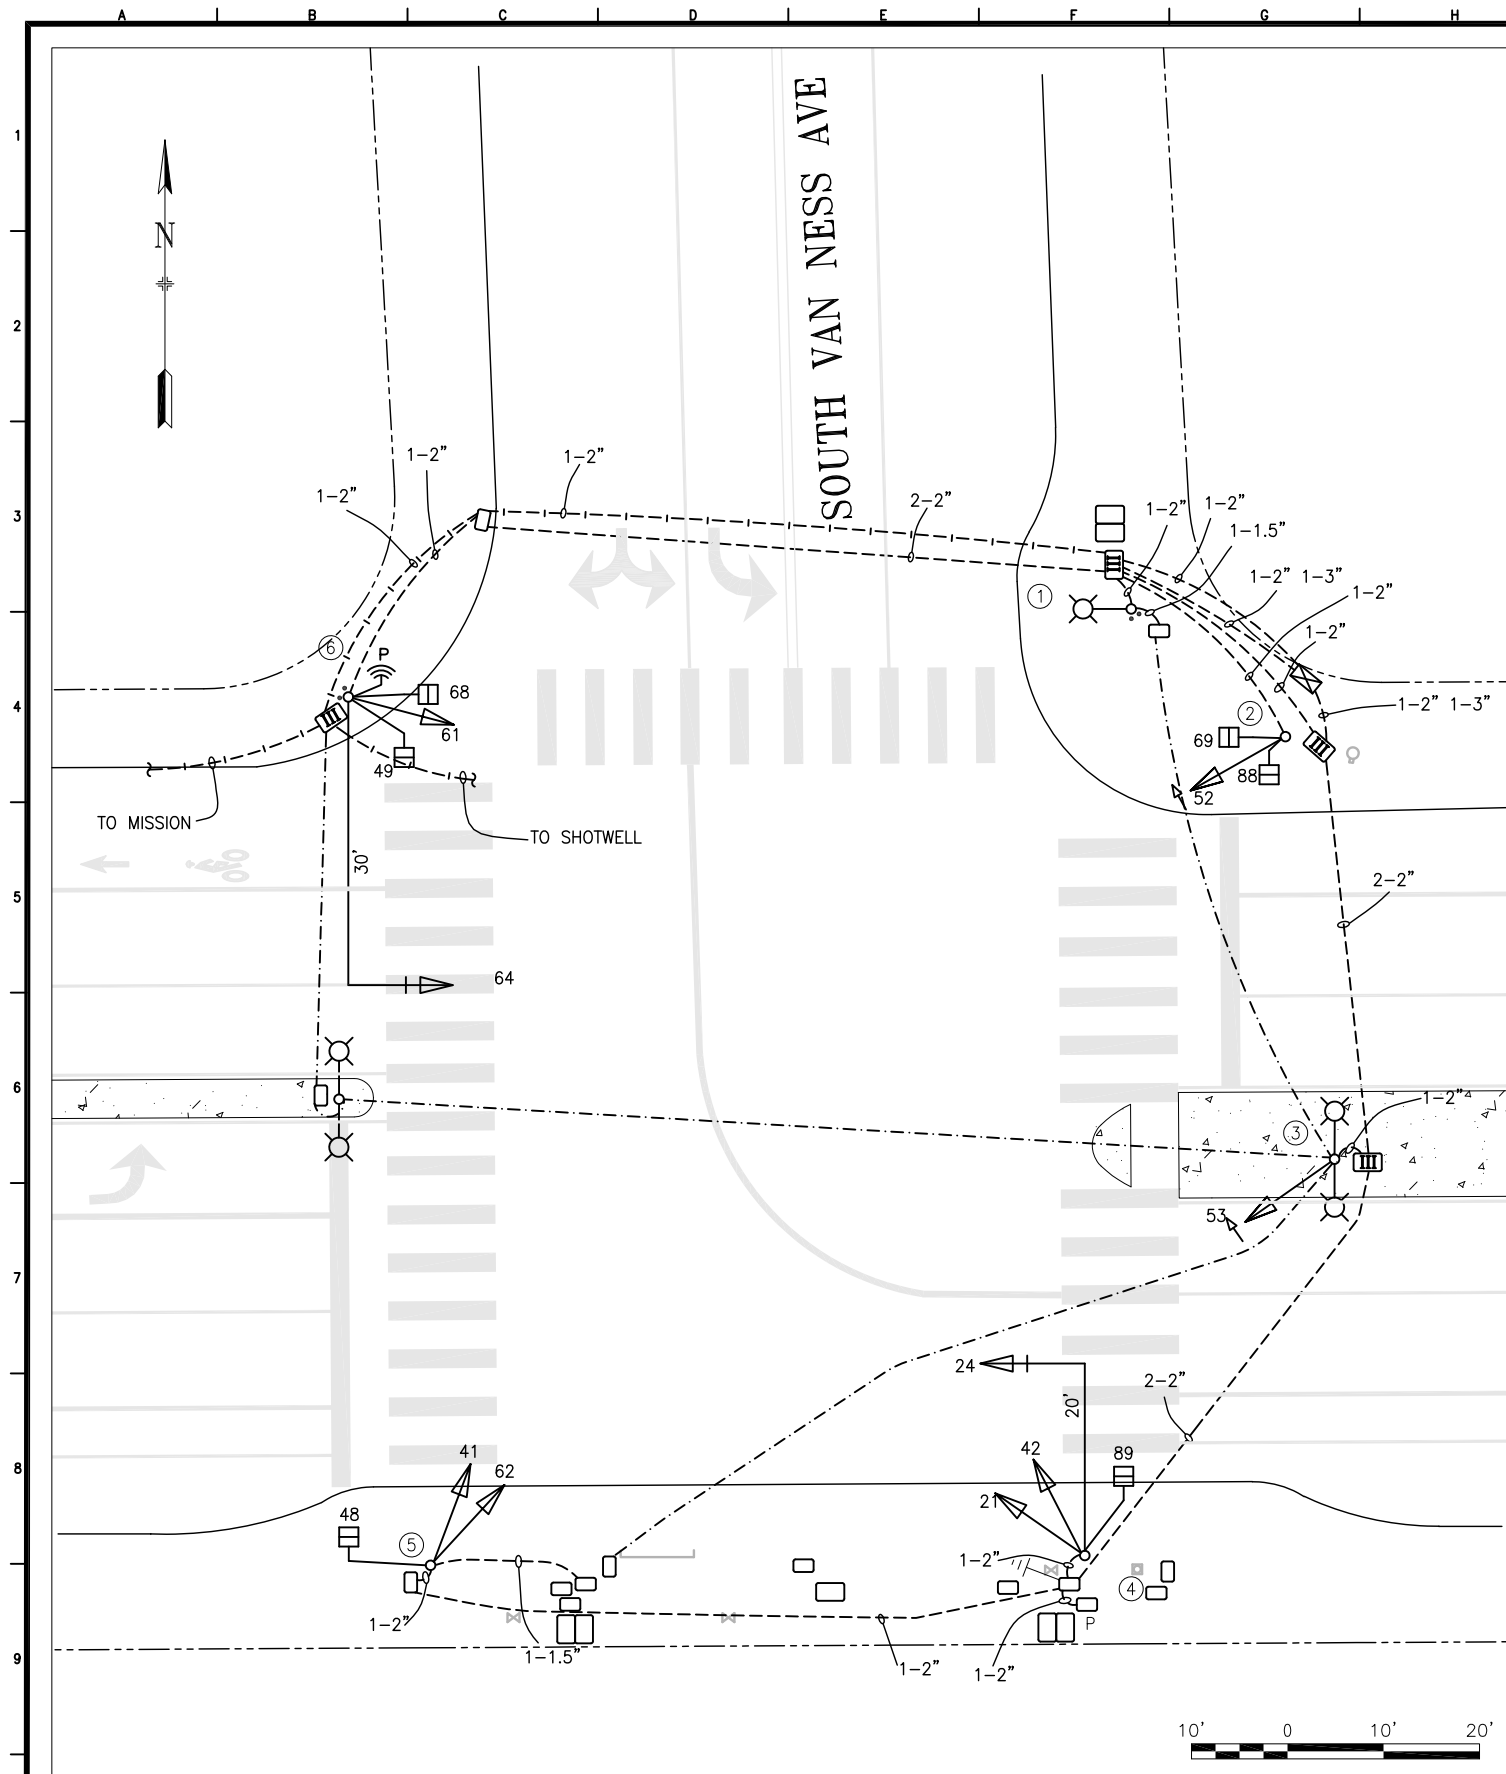

POLE AND EQUIPMENT SCHEDULE											
POLE No.	TYPE OF POLE	LUMINAIRE (HPS)	VEHICLE SIGNAL					PEDESTRIAN SIGNAL			REMARKS
		VOLTAGE/ WATTS	No.	TYPE	MOUNTING	VISORS	LOUVERS	No.	TYPE	MOUNTING	
①	CITY STANDARD STREET LIGHT	120V 150W									
②	1-A (10')		52 88	4S12"FYLA 1S-COUNT 1S-COUNT	TV-1-T SP-1 SP-1	T		69 88	1S-COUNT 1S-COUNT	SP-1 SP-1	
③	ORNAMENTAL STREET LIGHT		53	4S12"FYLA	SV-1	T					
④	16-1-70 with 20' MASTARM		24 21 42	3S12" 3S12" 3S12"	MAS SV-2-TC	T T T		89	1S-COUNT	SP-1	BACKPLATE
⑤	CITY STANDARD STREET LIGHT	120V 150W	41 62	3S12" 3S12"	SV-2-TC	T T		48	1S-COUNT	SP-1	
⑥	18-1-70 with 30' MASTARM		64 61	3S12" 3S12"	MAS SV-1-T	T T		49 68	1S-COUNT 1S-COUNT	SP-1-SF (12") SP-1 (22")	BACKPLATE PREEMPT RADIO

1	04/05/23	SRC 2023-006: CONVERT 23 & 22 TO 52 & 53 4S12" FYLA. PER FIELD: PED SIGNAL 88 ON POLE 2; REMOVE BP ON SIGNAL 52; PREEMPTION RADIO ON POLE 6	E. TANG	J. TOM
0	01/2014	SIGNAL UPGRADE ACTIVATED THRU 1068J; CONVERTED FROM 1068J AND 0494J CPs	J. HORNPOSTEL	G. DELEON
NO.	DATE	DESCRIPTION	BY	APPROVED
TABLE OF REVISIONS CHECKOUT DRAWING THROUGH THE SID CUSTODIAN FOR THE LATEST REVISION				



SFMTA

DRAWN BY:	DATE:
J. HORNPOSTEL	8/14
CHECKED BY:	DATE:
G. DE LEON	8/14

SCALE
AS SHOWN
SHEET OF SHEETS
1 OF 1

TRAFFIC SIGNAL INVENTORY DIAGRAM
CESAR CHAVEZ ST AND SOUTH VAN NESS AVE

CNN NO:
33364000
REV NO:
1