


[illegible]

1	04/14	UPGRADED SIGNALS TO 12"; NEW POLE 3, 11, 12, 13, 14		LY	PW
NO.	DATE	DESCRIPTION		BY	APP
TABLE OF REVISIONS CHECK WITH TRACING TO SEE IF YOU HAVE LATEST REVISION					

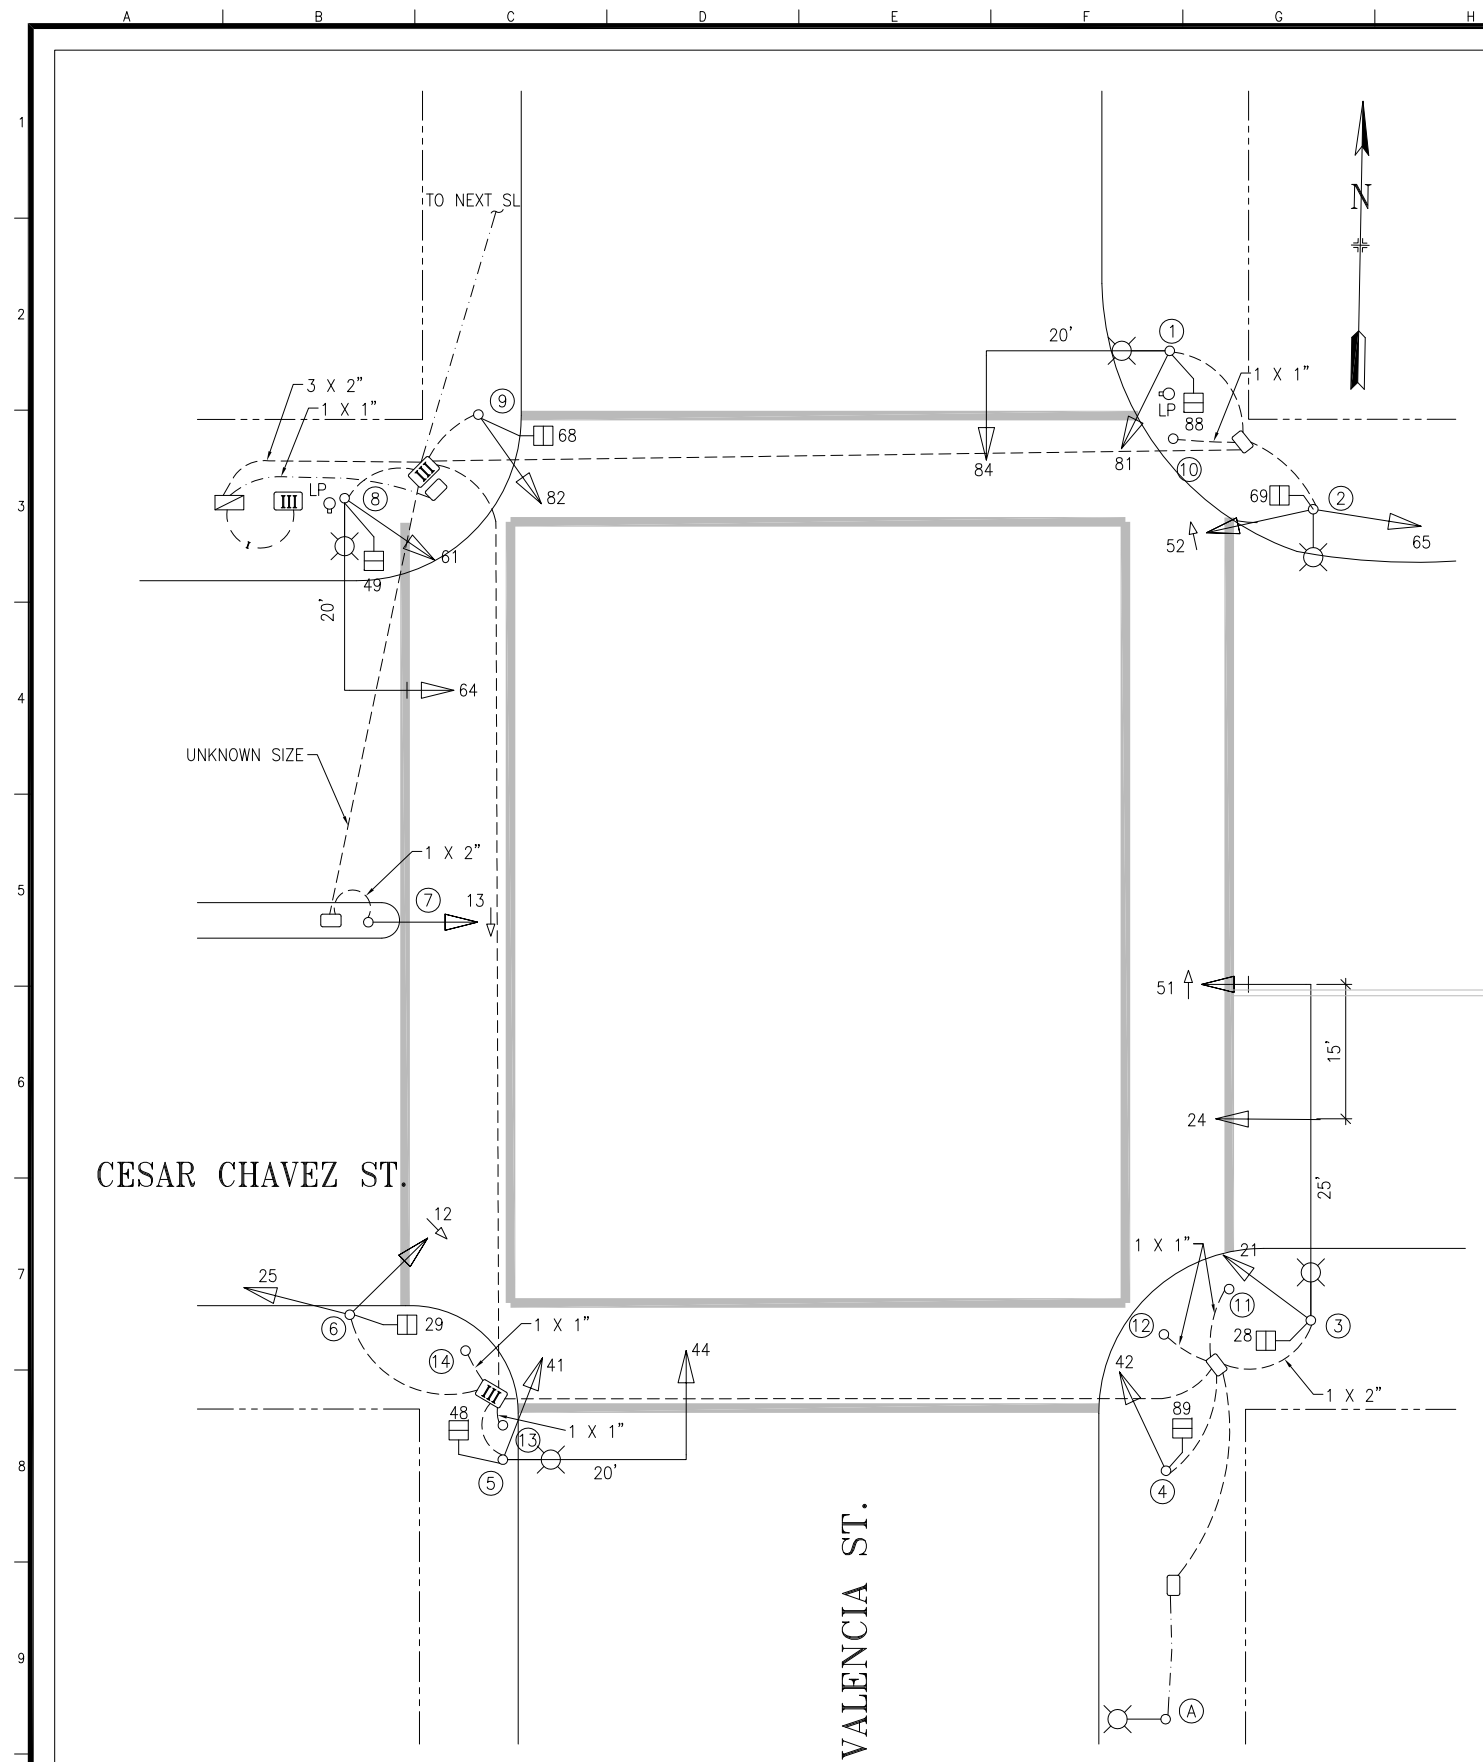

**SAN FRANCISCO MUNICIPAL TRANSPORTATION AGENCY
TRANSPORTATION ENGINEERING
CITY AND COUNTY OF SAN FRANCISCO**

DRAWN:	DATE:
CXL	4/03
CHECKED:	DATE:

SCALE:	1" = 20'
SHEET OF SHEETS	1 OF 1

TRAFFIC SIGNAL INVENTORY DIAGRAM

CESAR CHAVEZ ST AND VALENCIA ST

CNN NO.	21345000
REV. NO.	1