


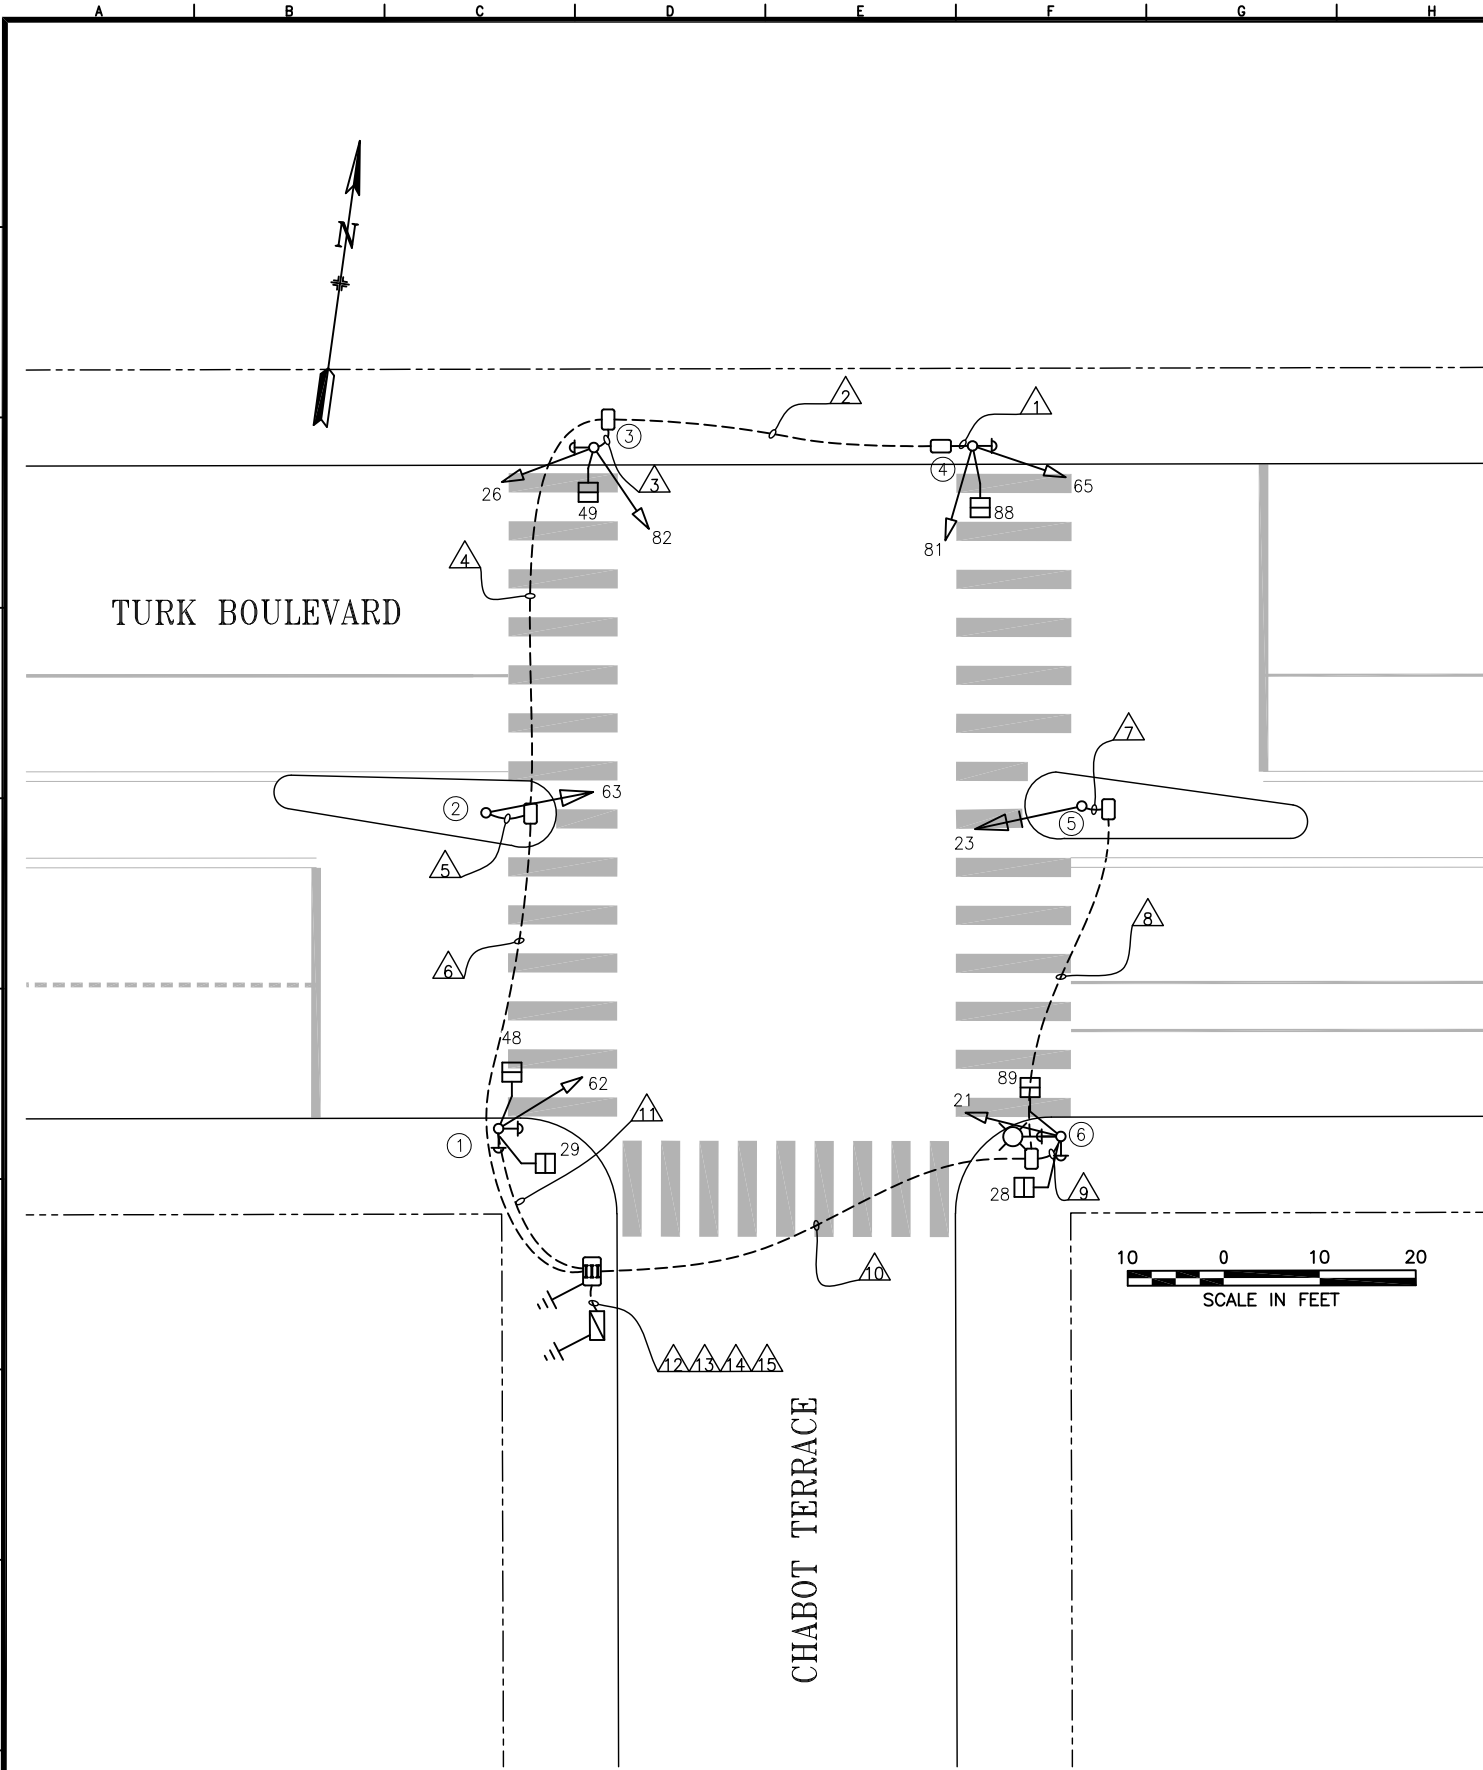

POLE AND EQUIPMENT SCHEDULE												
POLE No.	TYPE OF POLE	VEHICLE SIGNAL					PEDESTRIAN SIGNAL				ITS DEVICE	REMARKS
		No.	TYPE	MOUNTING	VISORS	LOUVERS/BP	No.	TYPE	MOUNTING	BUTTON		
①	1-A (10')	62	3S8"	TV-1	T		29 48	1S-COUNT 1S-COUNT	SP-1 SP-1	APS-4W APS-4W		
②	1-A (10')	63	3S12"	TV-1-T	T							
③	1-A (10')	26 82	3S8" 3S8"	TV-2-T-SFA	T T		49	1S-COUNT	SP-1	APS-4W		
④	1-A (10')	65 81	3S8" 3S8"	TV-2-T	T T		88	1S-COUNT	SP-1	APS-4W		
⑤	1-A (10')	23	3S12"	TV-1-T	T	BP						
⑥	MARBELITE SL	21	3S8"	SV-1-T	T		28 89	1S-COUNT 1S-COUNT	SP-1 SP-1	APS-4W APS-4W		

5	12/22/23	INSTALL PED SIGNALS AND APS FOR 2P PER SRC 2023-308	B. LIN	J. HORNOSTEL
4	11/2013	SIGNAL 63 REPLACED W/ 3S12 & TV-1-T; REMO BP PER FIELD	B. LIN	J. HORNOSTEL
3	5/2011	SIGNAL 23 REPLACED W/ 3S12 & TV-1-T PER FIELD	B. LIN	J. HORNOSTEL
2	7/2009	POLE 3 REPLACED W/ 1-A(10'), 61 BECOMES 26, SIGNALS MOUNTED TV-2-T-SFA	B. LIN	J. HORNOSTEL
1	8/18/08	INSTALL APS PER SRC 2008-139	B. LIN	J. HORNOSTEL
0	7/8/99	SIGNAL UPGRADE PER 1434N, CONVERTED FROM AS-BUILTS	B. LIN	J. HORNOSTEL
NO.	DATE	DESCRIPTION	BY	APPROVED
TABLE OF REVISIONS				
CHECKOUT DRAWING THROUGH THE SID CUSTODIAN FOR THE LATEST REVISION				



SFMTA

DRAWN BY:	DATE:
B. LIN	1/2/2024
CHECKED BY:	DATE:
J. HORNOSTEL	1/2/2024

SCALE
AS SHOWN
SHEET OF SHEETS
1 OF 2

TRAFFIC SIGNAL INVENTORY DIAGRAM
CHABOT TERRACE & TURK BOULEVARD

CNN NO:
26466000
REV NO:
5

[illegible]