


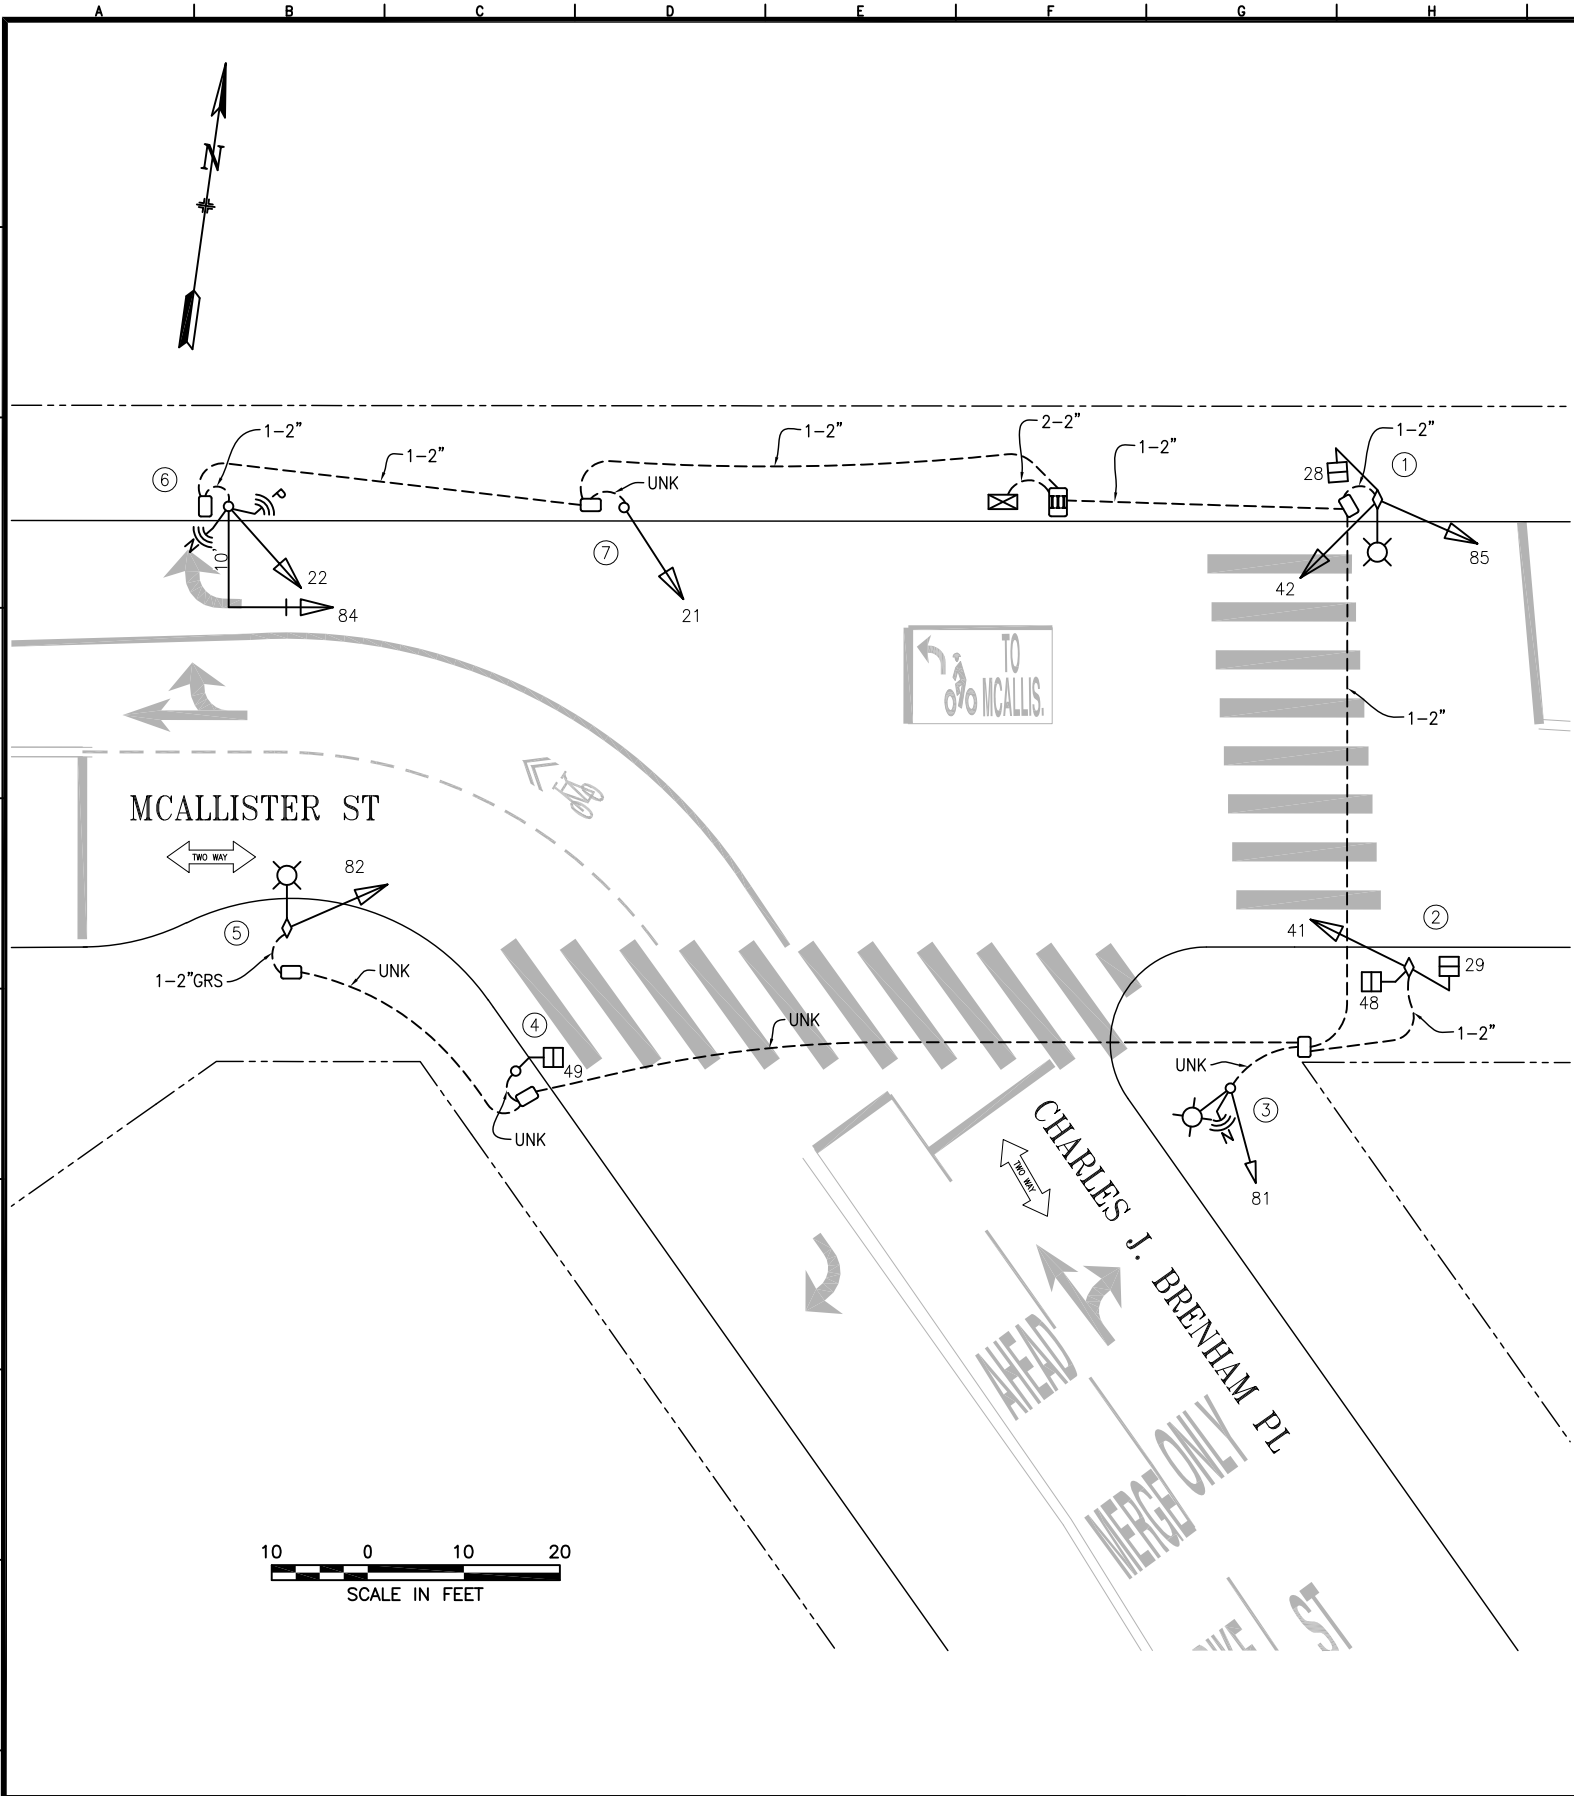

POLE AND EQUIPMENT SCHEDULE										
POLE No.	TYPE OF POLE	VEHICLE SIGNAL					PEDESTRIAN SIGNAL			REMARKS
		No.	TYPE	MOUNTING	VISORS	LOUVERS/BP	No.	TYPE	MOUNTING	
①	MUNI POLE W/ 6' LA	42 85	3S12" 3S12"	SV-2-TA	T T		28	1S-COUNT	SP-1	
②	MUNI POLE	41	3S12"	SV-1-T	T		29 48	1S-COUNT 1S-COUNT	SP-1 SP-1	
③	STREETLIGHT	81	3S8"	SV-1	T					NETWORK RADIO
④	1-A (7')						49	1S-COUNT	TP-1	
⑤	MUNI POLE W/ 6' LA	82	3S12"	SV-1-T	T					
⑥	16-1-100 W/ 10' MAST ARM	22 84	3S12" 3S12"	SV-1-T MAS	T T	BP				TSP RADIO NETWORK RADIO
⑦	1-A (10')	21	3S12"	TV-1-T						

8/10/23	UPDATE PER FIELD: M-SF. ADD RADIOS. NO EXT COND POLE 5. SP-1 FOR 48.	D. YEUNG	G. DE LEON		
5/29/13	CONVERTED FROM MUNI CONTRACT 1234 21 HAYES AS-BUILT	D. YEUNG	G. DE LEON		
NO.	DATE	DESCRIPTION	BY	APPROVED	

TABLE OF REVISIONS
CHECKOUT DRAWING THROUGH THE SID CUSTODIAN FOR THE LATEST REVISION



SFMTA

DRAWN BY: D. YEUNG	DATE: MAR 2023
CHECKED BY: G. DE LEON	DATE: MAR 2023

SCALE AS SHOWN	TRAFFIC SIGNAL INVENTORY DIAGRAM CHARLES J. BRENHAM PL AND MCALLISTER ST
SHEET OF SHEETS 1 OF 1	

CNN NO: 30045000
REV NO: 1