


INTERSECTION CHENERY & ELK STS.

DATE 11-5-71
OBSERVER GRH

REMOVED BY
RPD PROJECT
8/2014 PER
GOOGLE MAPS
- S. HORNBOSTEL

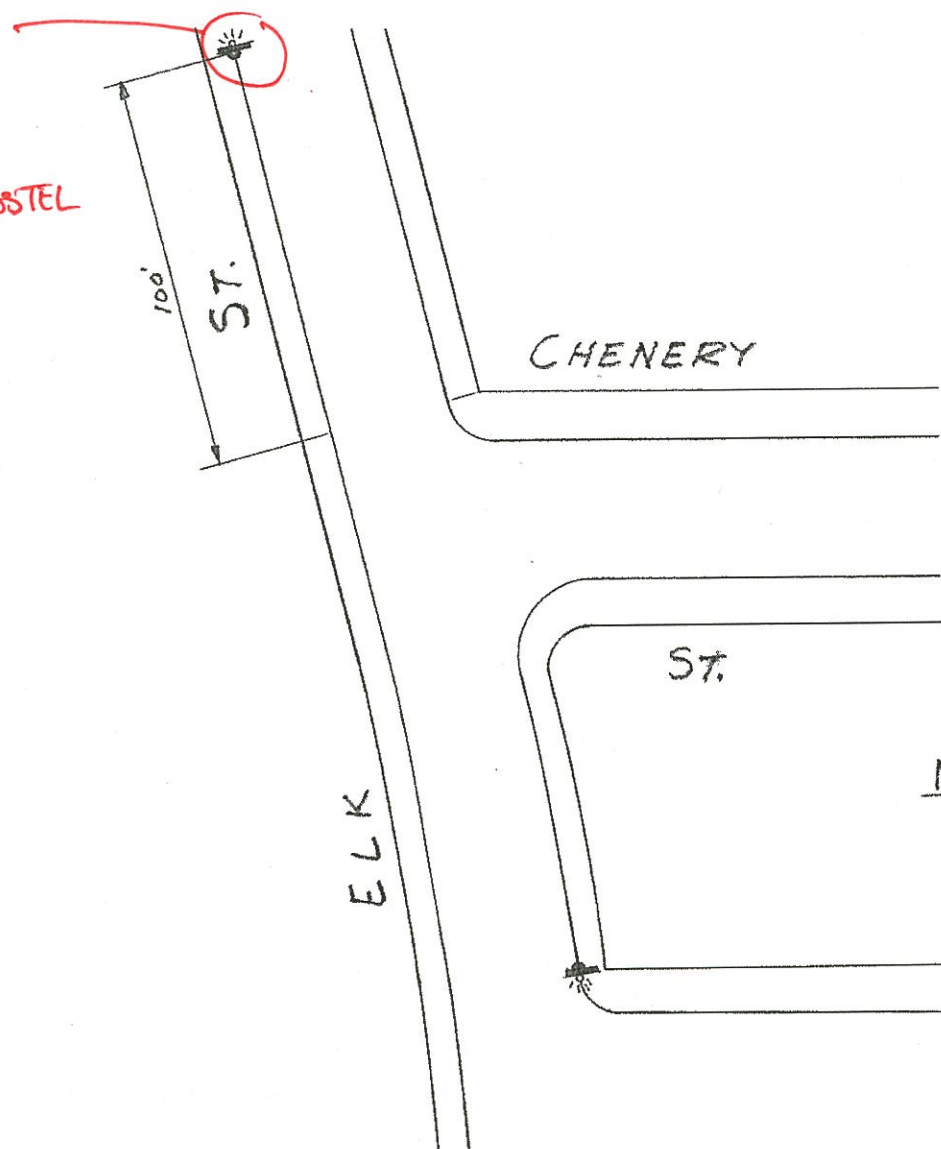

NOTE:
☼ 150 W BEACON