


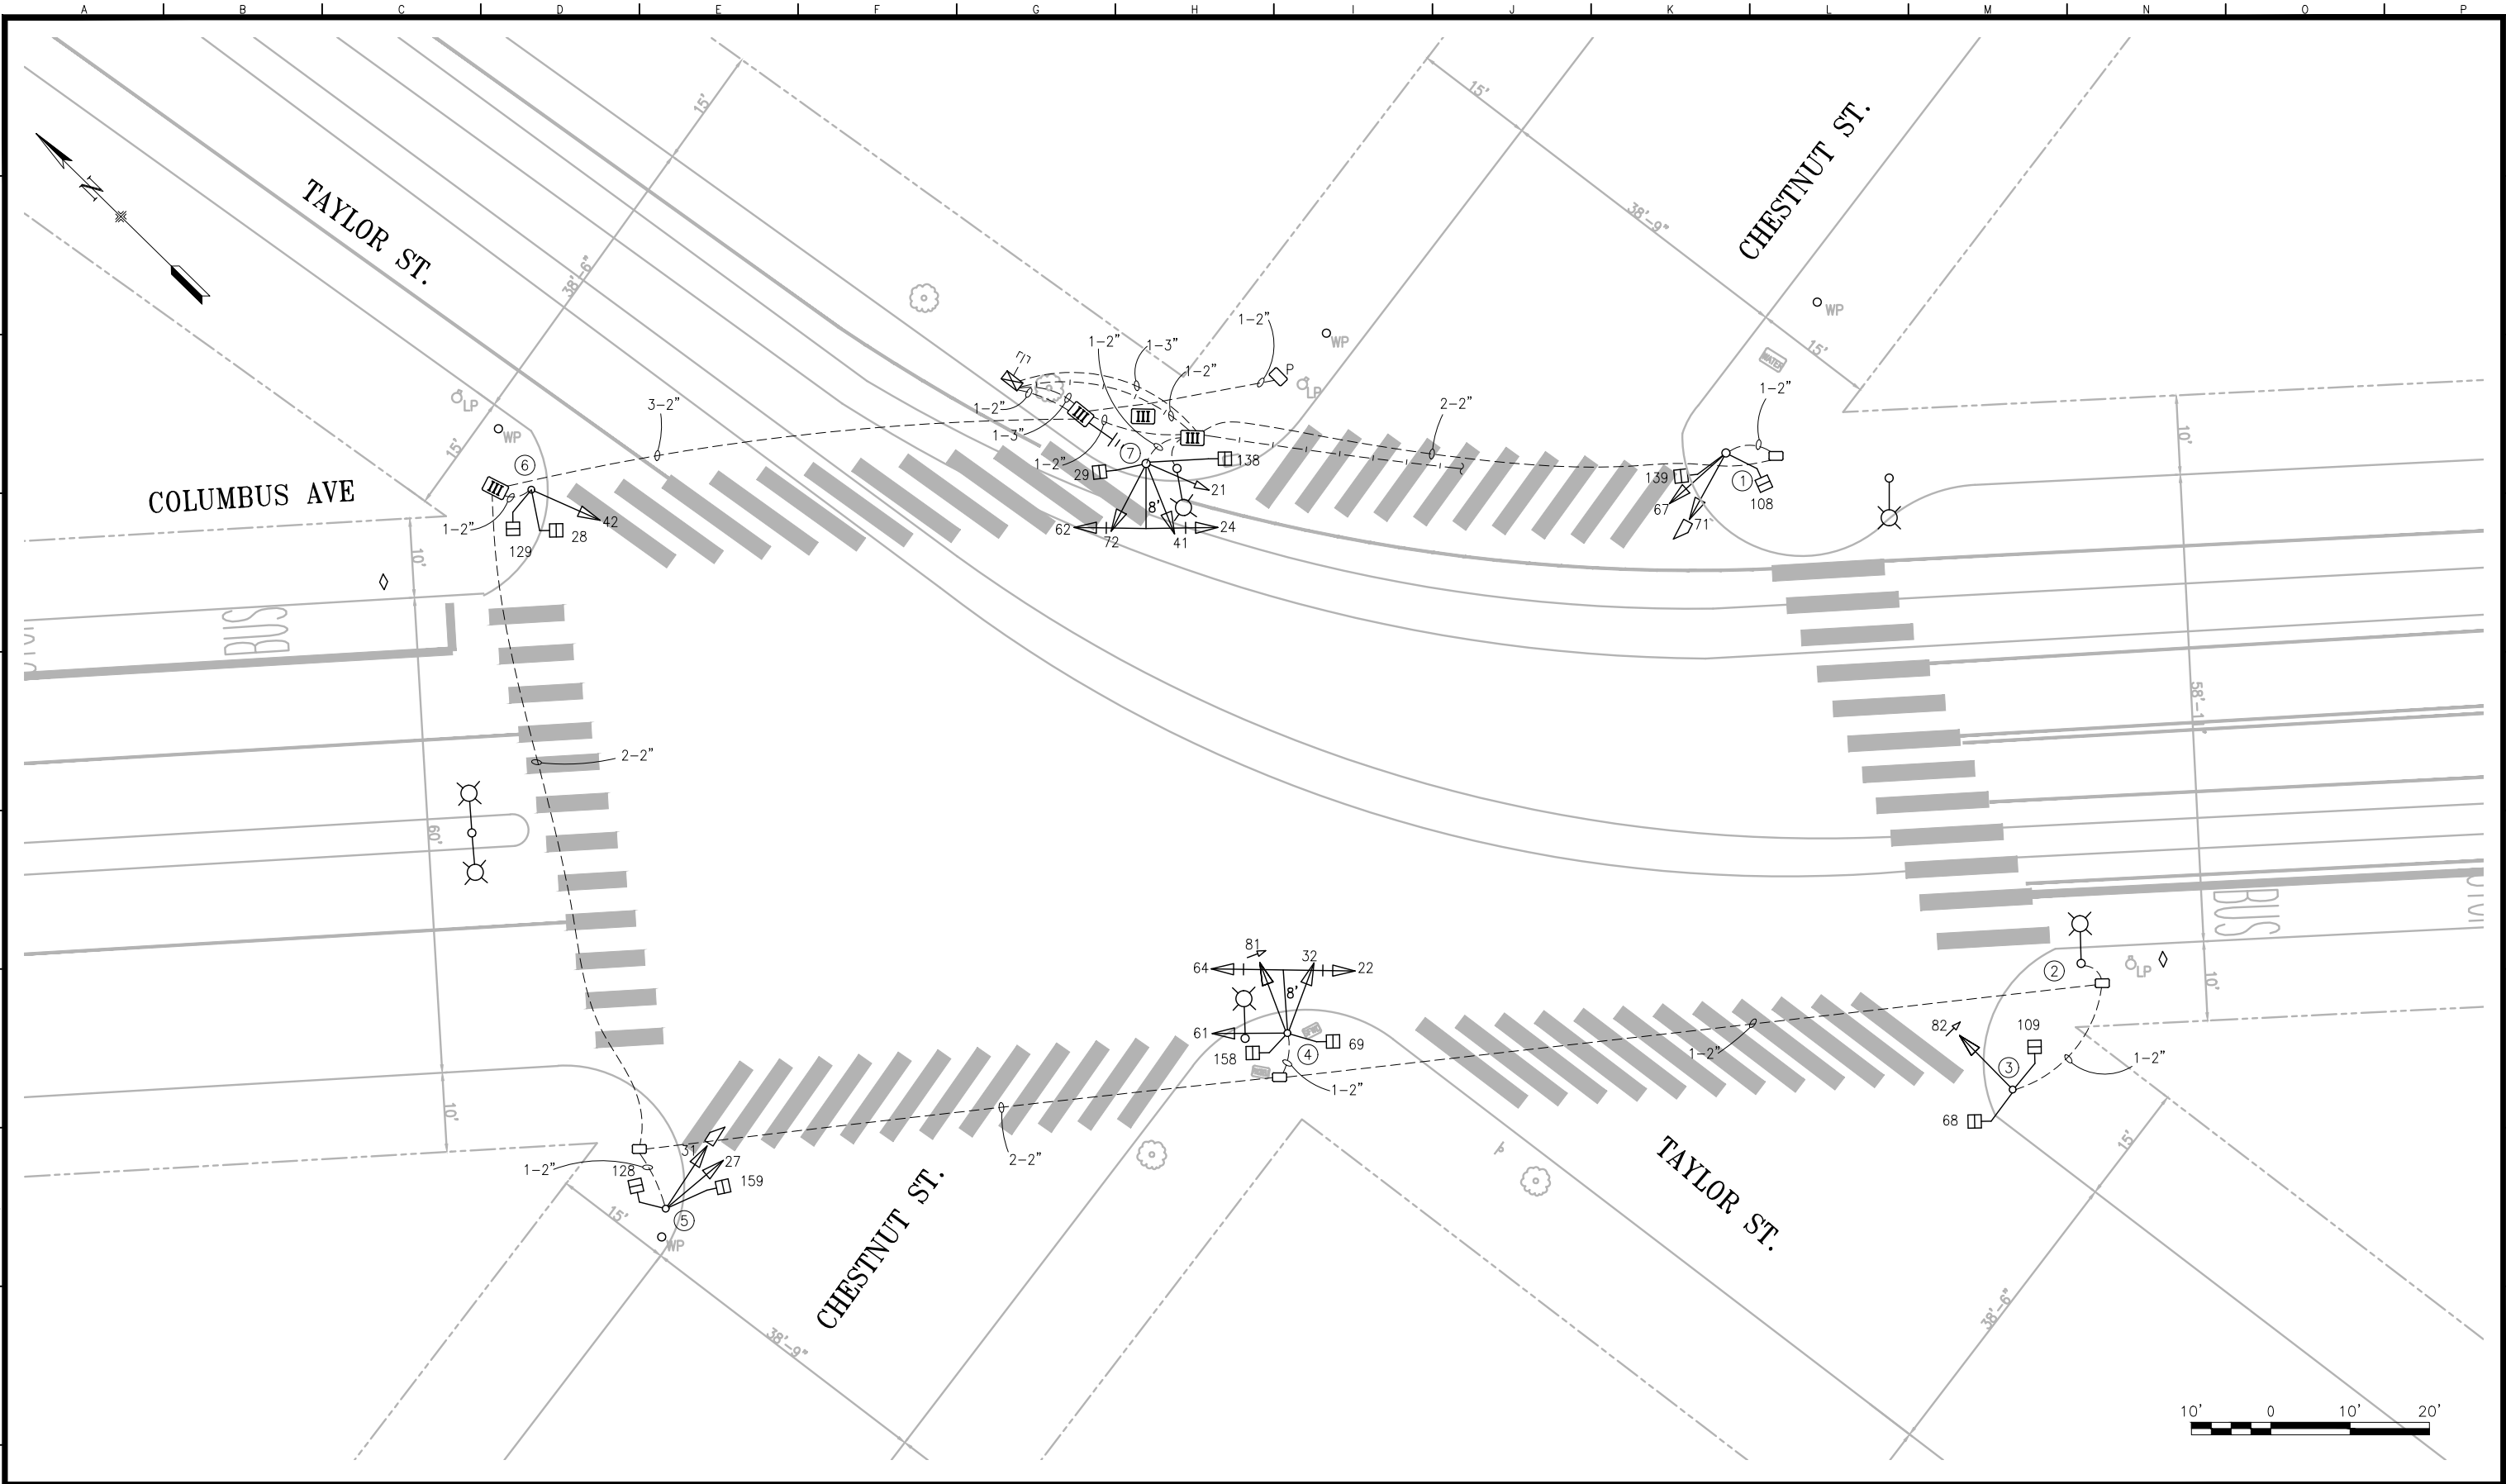

3	12/04/17	CHANGED SIGNAL 81 & 82 FROM 3S12" TO 4S12"GLA	KMLeung	EWoo
		SIGNAL 61 UPGRADED FROM 3S8" TO 3S12" BY SHOP		
2	05/08	UPDATED SIGNAL 27 AND 67 TO 3S12" PER FIELD	Umboster	CdeLeon
1	02/05	SIGNAL 27 AND 67 ADDED BY CHANGE ORDER #12	Umboster	CdeLeon
0	11/23/04	SIGNAL UPGRADE BY 0481J	Umboster	CdeLeon
NO.	DATE	DESCRIPTION	BY	APP.
TABLE OF REVISIONS CHECK WITH TRACING TO SEE IF YOU HAVE LATEST REVISION				

REFERENCE INFORMATION & FILE NO. OF SURVEYS
--



SAN FRANCISCO MUNICIPAL TRANSPORTATION AGENCY
CITY AND COUNTY OF SAN FRANCISCO

DRAWN:	DATE:
K.M.LEUNG	04/2018
CHECKED:	DATE:
B.WOO	04/2018

--

SCALE:
AS SHOWN
SHEET OF SHEETS
1 OF 2

TRAFFIC SIGNAL INVENTORY DIAGRAM
CHESTNUT ST, COLUMBUS AVE, AND TAYLOR ST

CNN NO.
25468000
REV NO.
3

