


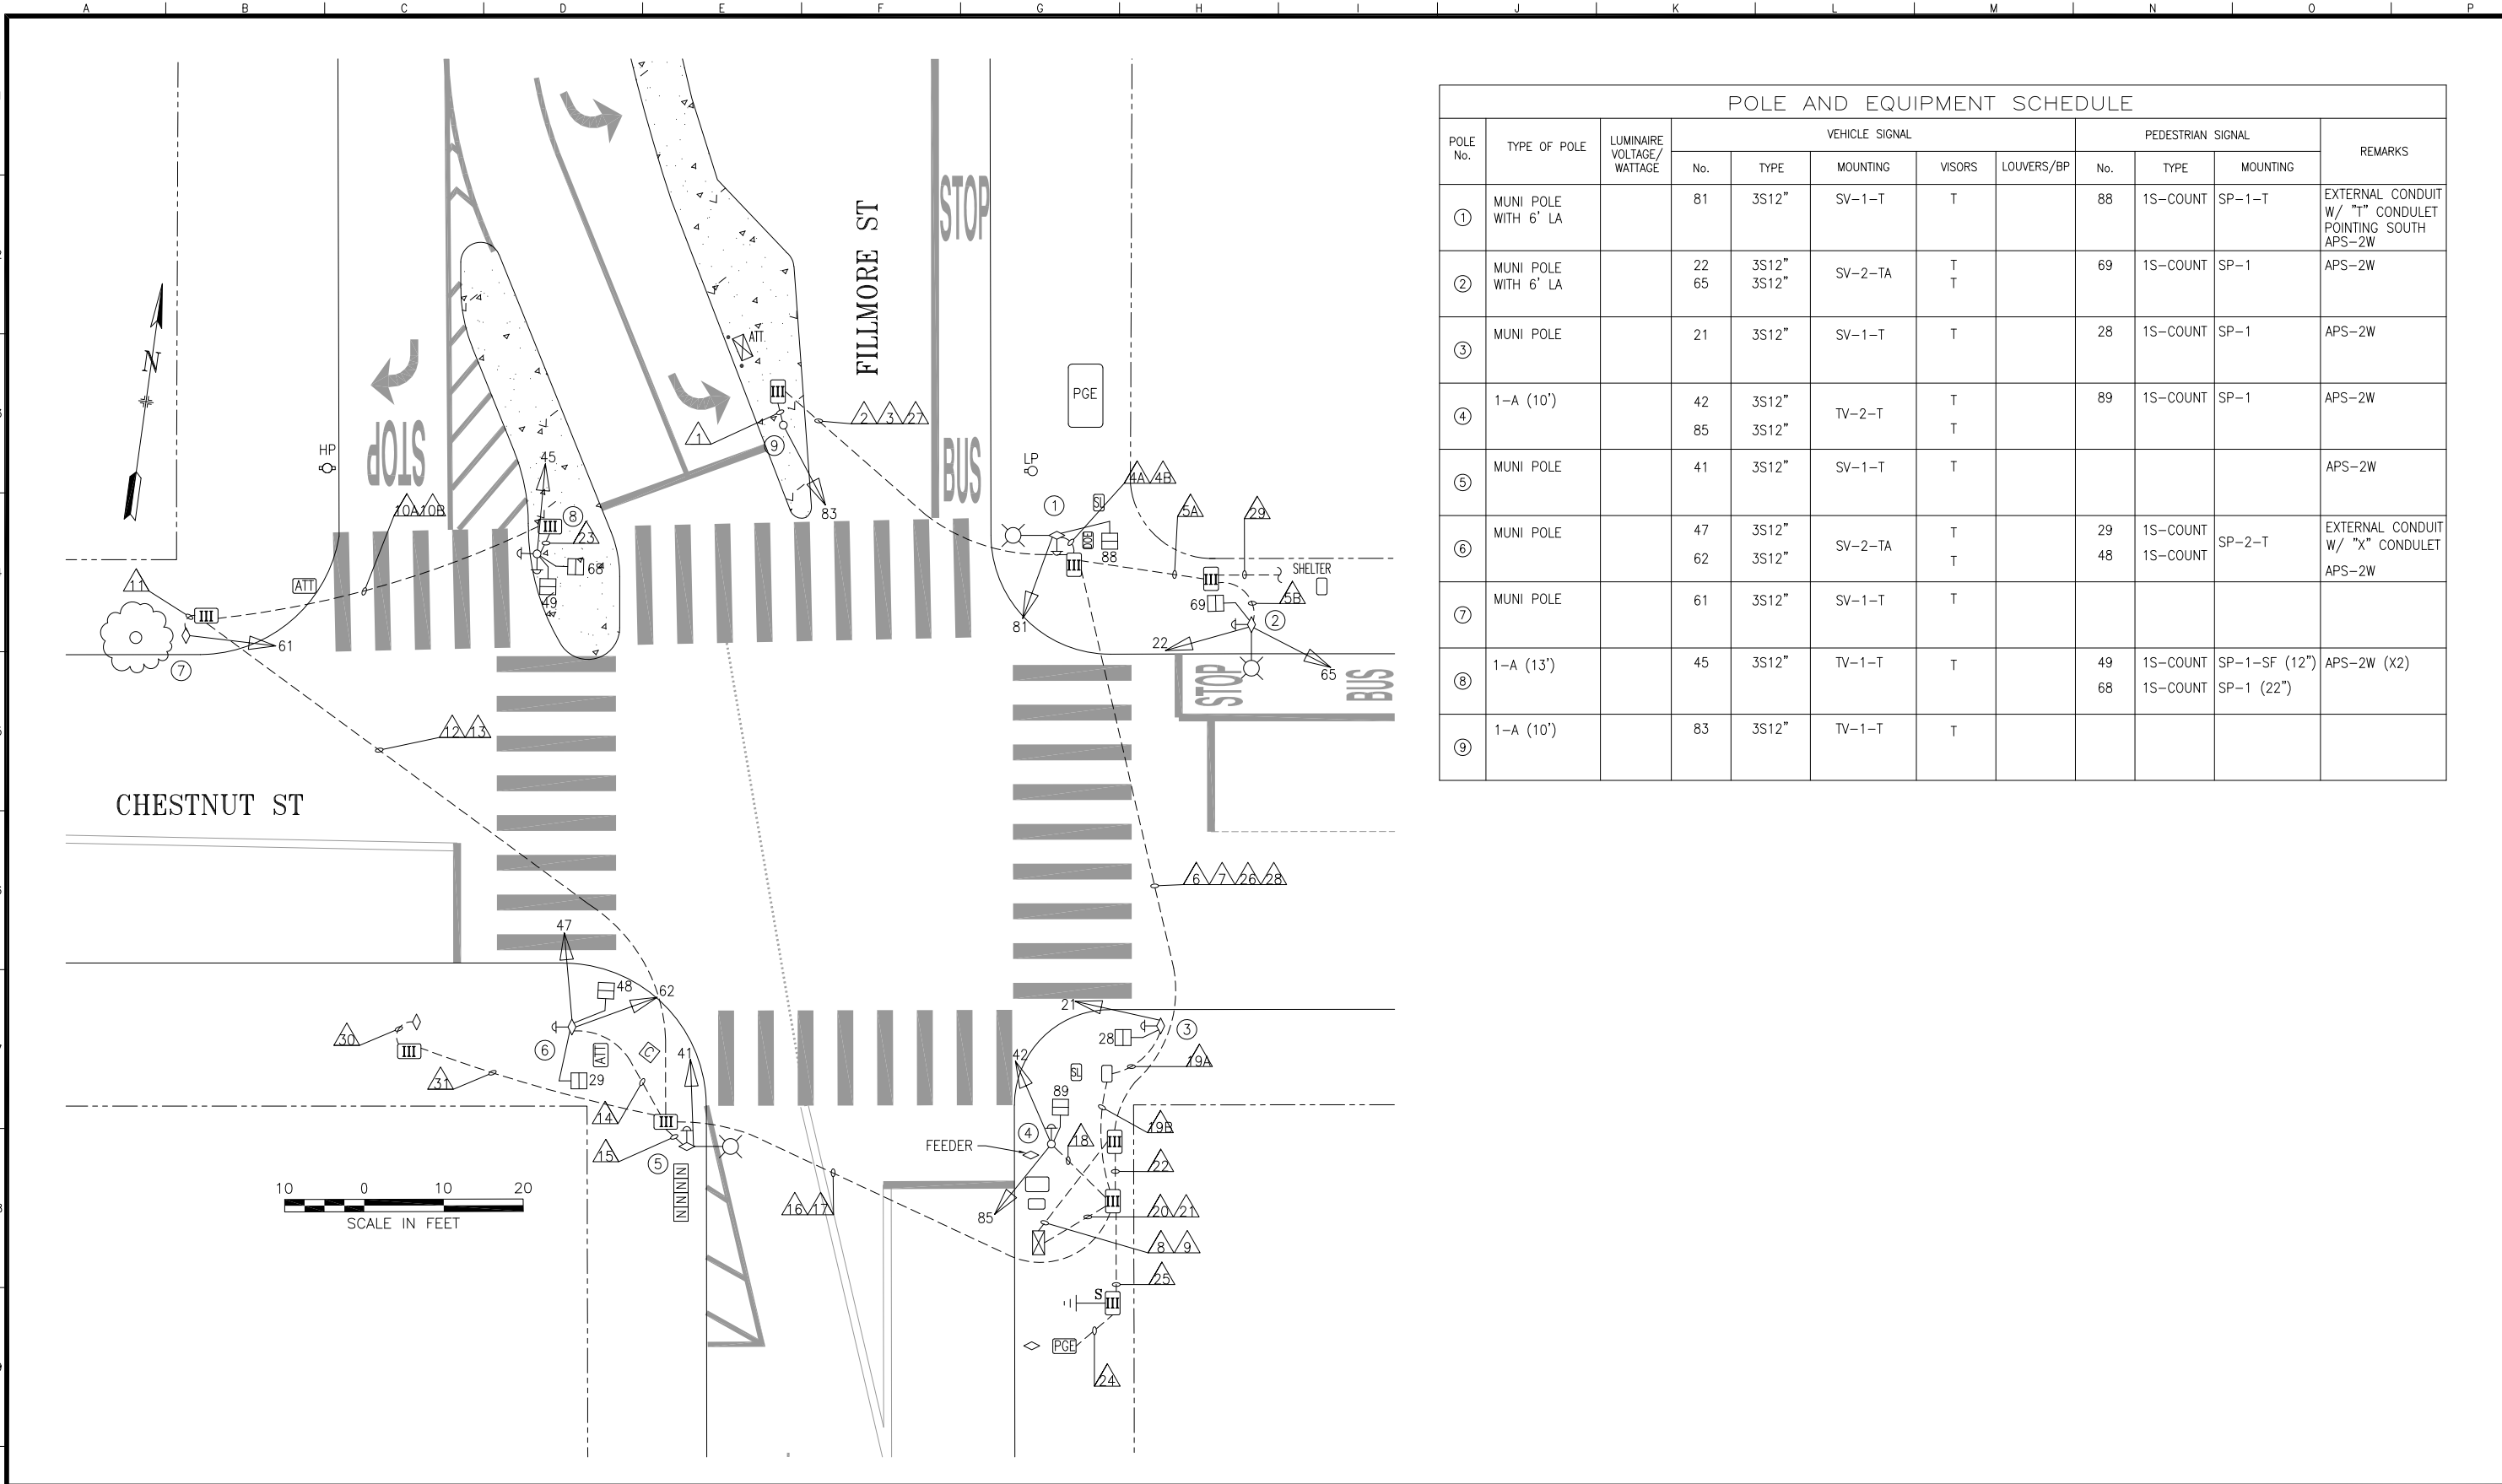

POLE AND EQUIPMENT SCHEDULE											
POLE No.	TYPE OF POLE	LUMINAIRE VOLTAGE/ WATTAGE	VEHICLE SIGNAL					PEDESTRIAN SIGNAL			REMARKS
			No.	TYPE	MOUNTING	VISORS	LOUVERS/BP	No.	TYPE	MOUNTING	
①	MUNI POLE WITH 6' LA		81	3S12"	SV-1-T	T		88	1S-COUNT	SP-1-T	EXTERNAL CONDUIT W/ "T" CONDULET POINTING SOUTH APS-2W
②	MUNI POLE WITH 6' LA		22 65	3S12" 3S12"	SV-2-TA	T T		69	1S-COUNT	SP-1	APS-2W
③	MUNI POLE		21	3S12"	SV-1-T	T		28	1S-COUNT	SP-1	APS-2W
④	1-A (10')		42 85	3S12" 3S12"	TV-2-T	T T		89	1S-COUNT	SP-1	APS-2W
⑤	MUNI POLE		41	3S12"	SV-1-T	T					APS-2W
⑥	MUNI POLE		47 62	3S12" 3S12"	SV-2-TA	T T		29 48	1S-COUNT 1S-COUNT	SP-2-T	EXTERNAL CONDUIT W/ "X" CONDULET APS-2W
⑦	MUNI POLE		61	3S12"	SV-1-T	T					
⑧	1-A (13')		45	3S12"	TV-1-T	T		49 68	1S-COUNT 1S-COUNT	SP-1-SF (12") SP-1 (22")	APS-2W (X2)
⑨	1-A (10')		83	3S12"	TV-1-T	T					

1	05/06/19	SIGNAL UPGRADE BY 26122; TRAFFIC MOD. (NINE) & NEW NS ISLAND; ADDED APS	K SHUE	M MORALES	
0	02/23/17	SIGNAL UPGRADE BY 25951, CONVERTED FROM AS-BUILT	D YEUNG	G DELEON	
NO.	DATE	DESCRIPTION	BY	APP.	

TABLE OF REVISIONS
CHECK WITH TRACING TO SEE IF YOU HAVE LATEST REVISION

REFERENCE INFORMATION
& FILE NO. OF SURVEYS



SAN FRANCISCO MUNICIPAL TRANSPORTATION AGENCY
CITY AND COUNTY OF SAN FRANCISCO

DRAWN:	DATE:
D YEUNG	10/2019
CHECKED:	DATE:
G DELEON	10/2019

SCALE:
AS SHOWN

SHEET OF SHEETS
1 OF 2

TRAFFIC SIGNAL INVENTORY DIAGRAM

CHESTNUT STREET AND FILLMORE STREET

CNN NO.
26763000

REV NO.
1

