


CLARENDON AVE.

SPEED CONTROL ZONE

OPERATIONAL DATE: 9/8/76

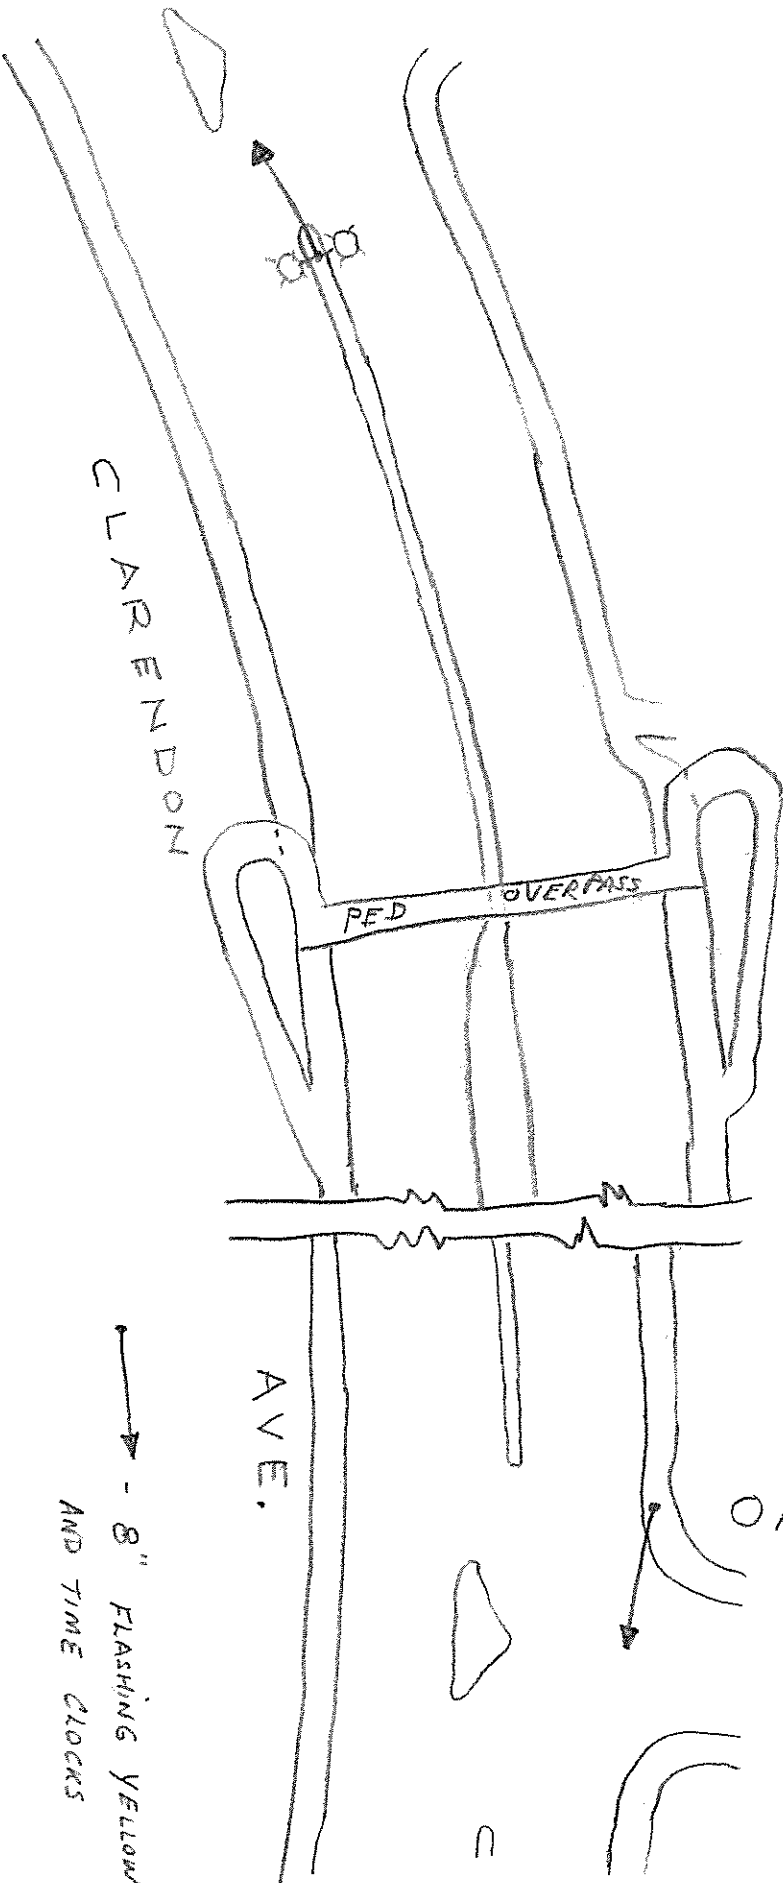

→ - 8" FLASHING YELLOW
AND TIME CLOCKS

1" = 50'

OAK PARK

AVE.