


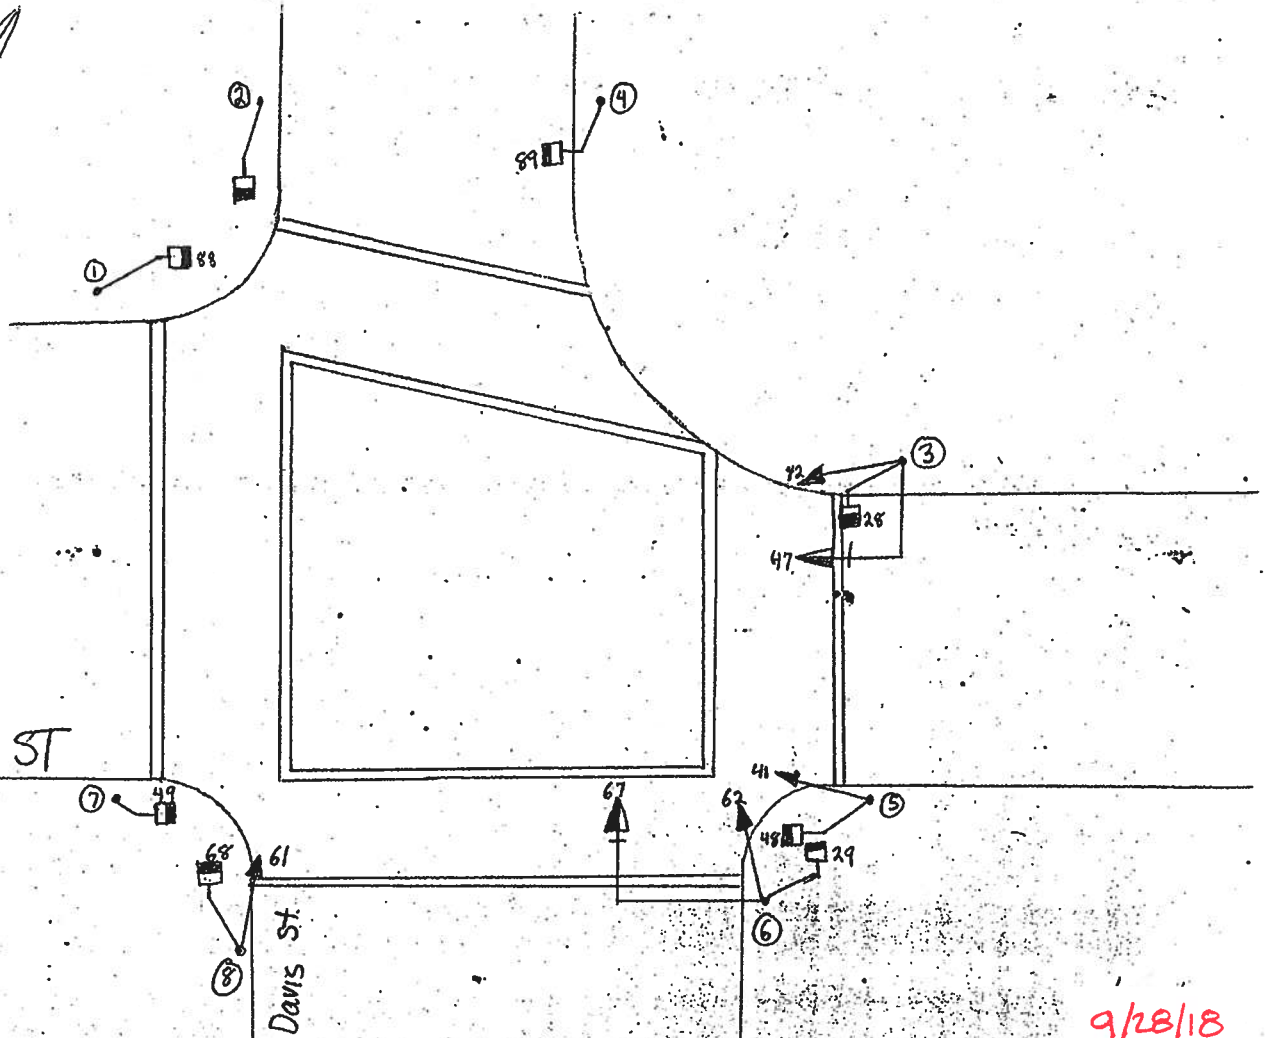

9/28/18

[illegible]

CONTROLLER CABINET SIZE : ordinary BASE CABINET: yes

COMMENTS: REPLACE MAST ARM ON POLE 3 WITH  
8-FOOT MAST ARM PER SRC 2018-124

- Hornbostel