



CLAY & DRUMM STS.

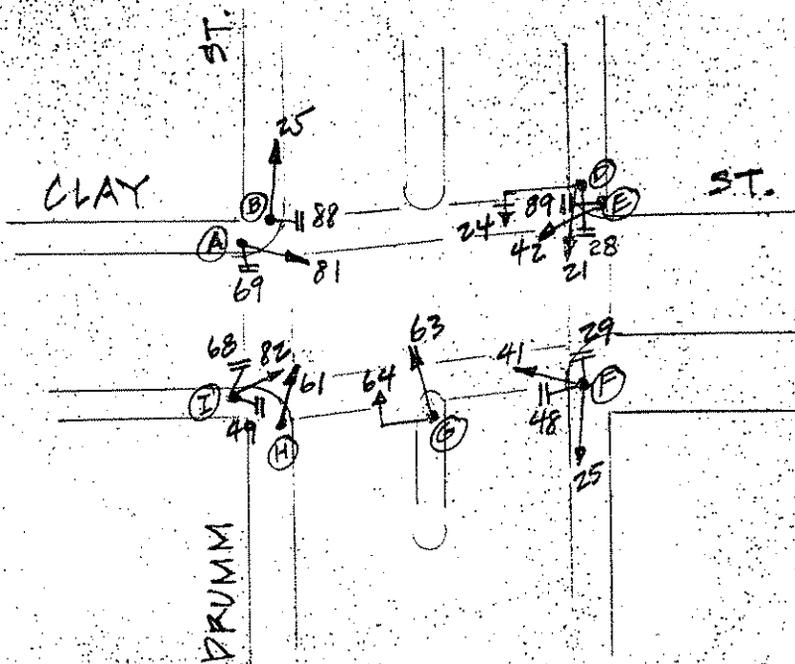

****81 and 82 are 4-section signals as shown:

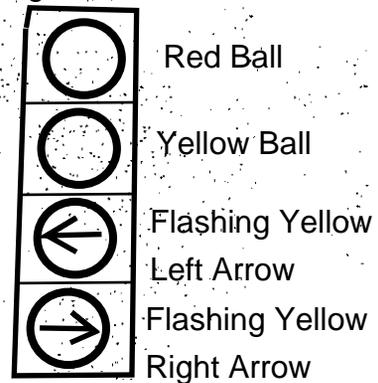

3-10-2022

POLE	FUNC.	MAT'L	SIGNAL NO.	MAKE	NO. OF SECT.	SIZE	VISOR	B.P. OR LOUVERS	MOUNT	PED SIGNAL NO.	LEGEND	MESSAGE		MAKE	MOUNT
												ELEMENT	COLOR		
A	S	S	81	TCT	4S12"****		IT	No	T	69	I	IS-1	W/O	ICC	S
B	S	S	25	TCT	3	8"	FC 8"	NO	T	88	I	IS-1	W/O	ICC	S
			21	EA	3	8"	FC 8"	NO	T	89	I	IS-1	W/O	ICC	S
D	L	S	24	TCT	3	12"	FC 12"	BP	MAT	29	I	IS-1	W/O	ICC	S
E	S	S	42	TCT	3	12"	T	NO	T	48	I	IS-1	W/O	ICC	S
F	S	S	41	TCT	3	8"	FC 8"	NO	T	49	I	IS-1	W/O	ICC	S
G	S	S	63	TCT	3	8"	FC 8"	NO	S	68	I	IS-1	W/O	ICC	S
H	S	S	64	TCT	3	12"	FC 12"	BP	MAT	28	I	IS-1	W/O	ICC	S
I	S	S	61	TCT	3	12"	T	NO	T						
			82	TCT	4S12"****		T	NO	T						
			25	TCT	3	8"	FC 8"	NO	T						

CONTROLLER CABINET SIZE: Ordinary BASE CABINET: yes

COMMENTS: Upgrade 81 and 82 to 4-section heads with flashing arrows per SRC 2022-007

- D. Yeung 3-10-2022